

DEPARTMENT OF INSPECTIONS, LICENSES AND PERMITS
3430 COURT HOUSE DRIVE
ELICOTT CITY, MD 21043
PERMITS (410) 313-2455 INSPECTIONS (410) 313-1810
AUTOMATED INFORMATION (410) 313-3800

HOWARD COUNTY
PERMIT APPLICATION

PERMIT NUMBER
302002996

Building Address 11906 Simpson Rd
Suite/Apt. #: SDP/WP/Petition #:
Census Tract Subdivision
Section Area Lot
Tax Map Parcel Grid
Zoning Map Coordinates Lot size

Property Owner's Name
Address
City State Zip Code
Phone Phone
Applicant's Name & Mailing Address, (if other than stated hereon):
Phone Fax

Existing Use
Proposed Use
Estimated Construction Cost \$
Description of Work
Occupant or Tenant
Contact Name
Address
City State Zip Code
Phone Fax

Contractor Company
Contact Person
Address
City State Zip Code
License No.
Phone Fax
Engineer or Architect Company
Contact Person
Address
City State Zip Code
Phone Fax

BUILDING DESCRIPTION - COMMERCIAL

BUILDING DESCRIPTION - RESIDENTIAL

Building Characteristics

Utilities

Building Characteristics

Utilities

Height:
No. of stories:
Gross area, sq. ft. per floor:
Use group:
Construction type:
Reinforced Concrete
Structural Steel
Masonry
Wood Frame
State Certified Modular

Water Supply:
Public
Private
Sewage Disposal:
Public
Private
Electric Yes No
Gas Yes No
Heating System:
Electric Oil
Natural Gas
Propane Gas
Sprinkler system: N/A
Full
Partial
Other Suppression
of Heads

SF Dwelling SF Townhouse
Depth Width
1st floor:
2nd floor:
Basement:
Finished Basement Unfinished Basement
Crawl space Slab on Grade
No. of Bedrooms
Height:
Multi-family dwellings:
No. of efficiency units:
No. of 1 BR units:
No. of 2 BR units:
No. of 3 BR units:
Other Structure:
Dimensions:
Footings:
Roof Height:
State Certified Modular
Manufactured Home

Water Supply:
Public
Private
Sewage Disposal:
Public
Private
Electric Yes No
Gas Yes No
Heating System:
Electric Oil
Natural Gas
Propane Gas
Sprinkler system: N/A
NFPA #13D
NFPA #13R
Other:

THE UNDERSIGNED HEREBY CERTIFIES AND AGREES AS FOLLOWS: (1) THAT HE/SHE IS AUTHORIZED TO MAKE THIS APPLICATION; (2) THAT THE INFORMATION IS CORRECT; (3) THAT HE/SHE WILL COMPLY WITH ALL REGULATIONS OF HOWARD COUNTY WHICH ARE APPLICABLE THERETO; (4) THAT HE/SHE WILL PERFORM NO WORK ON THE ABOVE REFERENCED PROPERTY NOT SPECIFICALLY DESCRIBED IN THIS APPLICATION; (5) THAT HE/SHE GRANTS COUNTY OFFICIALS THE RIGHT TO ENTER ONTO THIS PROPERTY FOR THE PURPOSE OF INSPECTING THE WORK PERMITTED AND POSTING NOTICES.

Applicant's Signature

Print Name

Title/Company

Date

Checks payable to: DIRECTOR OF FINANCE OF HOWARD COUNTY
** PLEASE WRITE NEATLY AND LEGIBLY. **
FOR OFFICE USE ONLY

AGENCY DATE SIGNATURE APPROVAL

DPZ SETBACK INFORMATION

PROPERTY ID#

Land Development, DPZ
State Highways
Building Official
Dev. Engineering, DPZ
Health
Fire Protection
Is Sediment Control approval required prior to issuance?
YES NO
CONTINGENCY CONSTRUCTION START:
ONE STOP SHOP:
Distribution of Copies- White: Building Official Green: LDD, DPZ Yellow: DED, DPZ Pink: Health Gold: SHA
T:\forms\PERMIT.FRM


Front:
Rear:
Side:
Side St.:
All minimum setbacks met?
YES NO
Is Entrance Permit required?
YES NO
Historic District?
YES NO
Lot Coverage for NewTown Zone
SDP/Red-line approval date
Filing fee
Permit fee
Excise tax
Add'l per. fee
TOTAL FEES
Sub-total paid
Balance due
Check
Validation
Accepted by

Rev. 11/4/04

LANDTECH ASSOCIATES, INC.

1410 CRAIN HIGHWAY, N.W. SUITE 7B GLEN BURNIE, MD 21061
(410) 768-2121 FAX (410) 553-9081

*NOTE: NOT TO BE USED FOR THE ISSUANCE OF PERMITS.

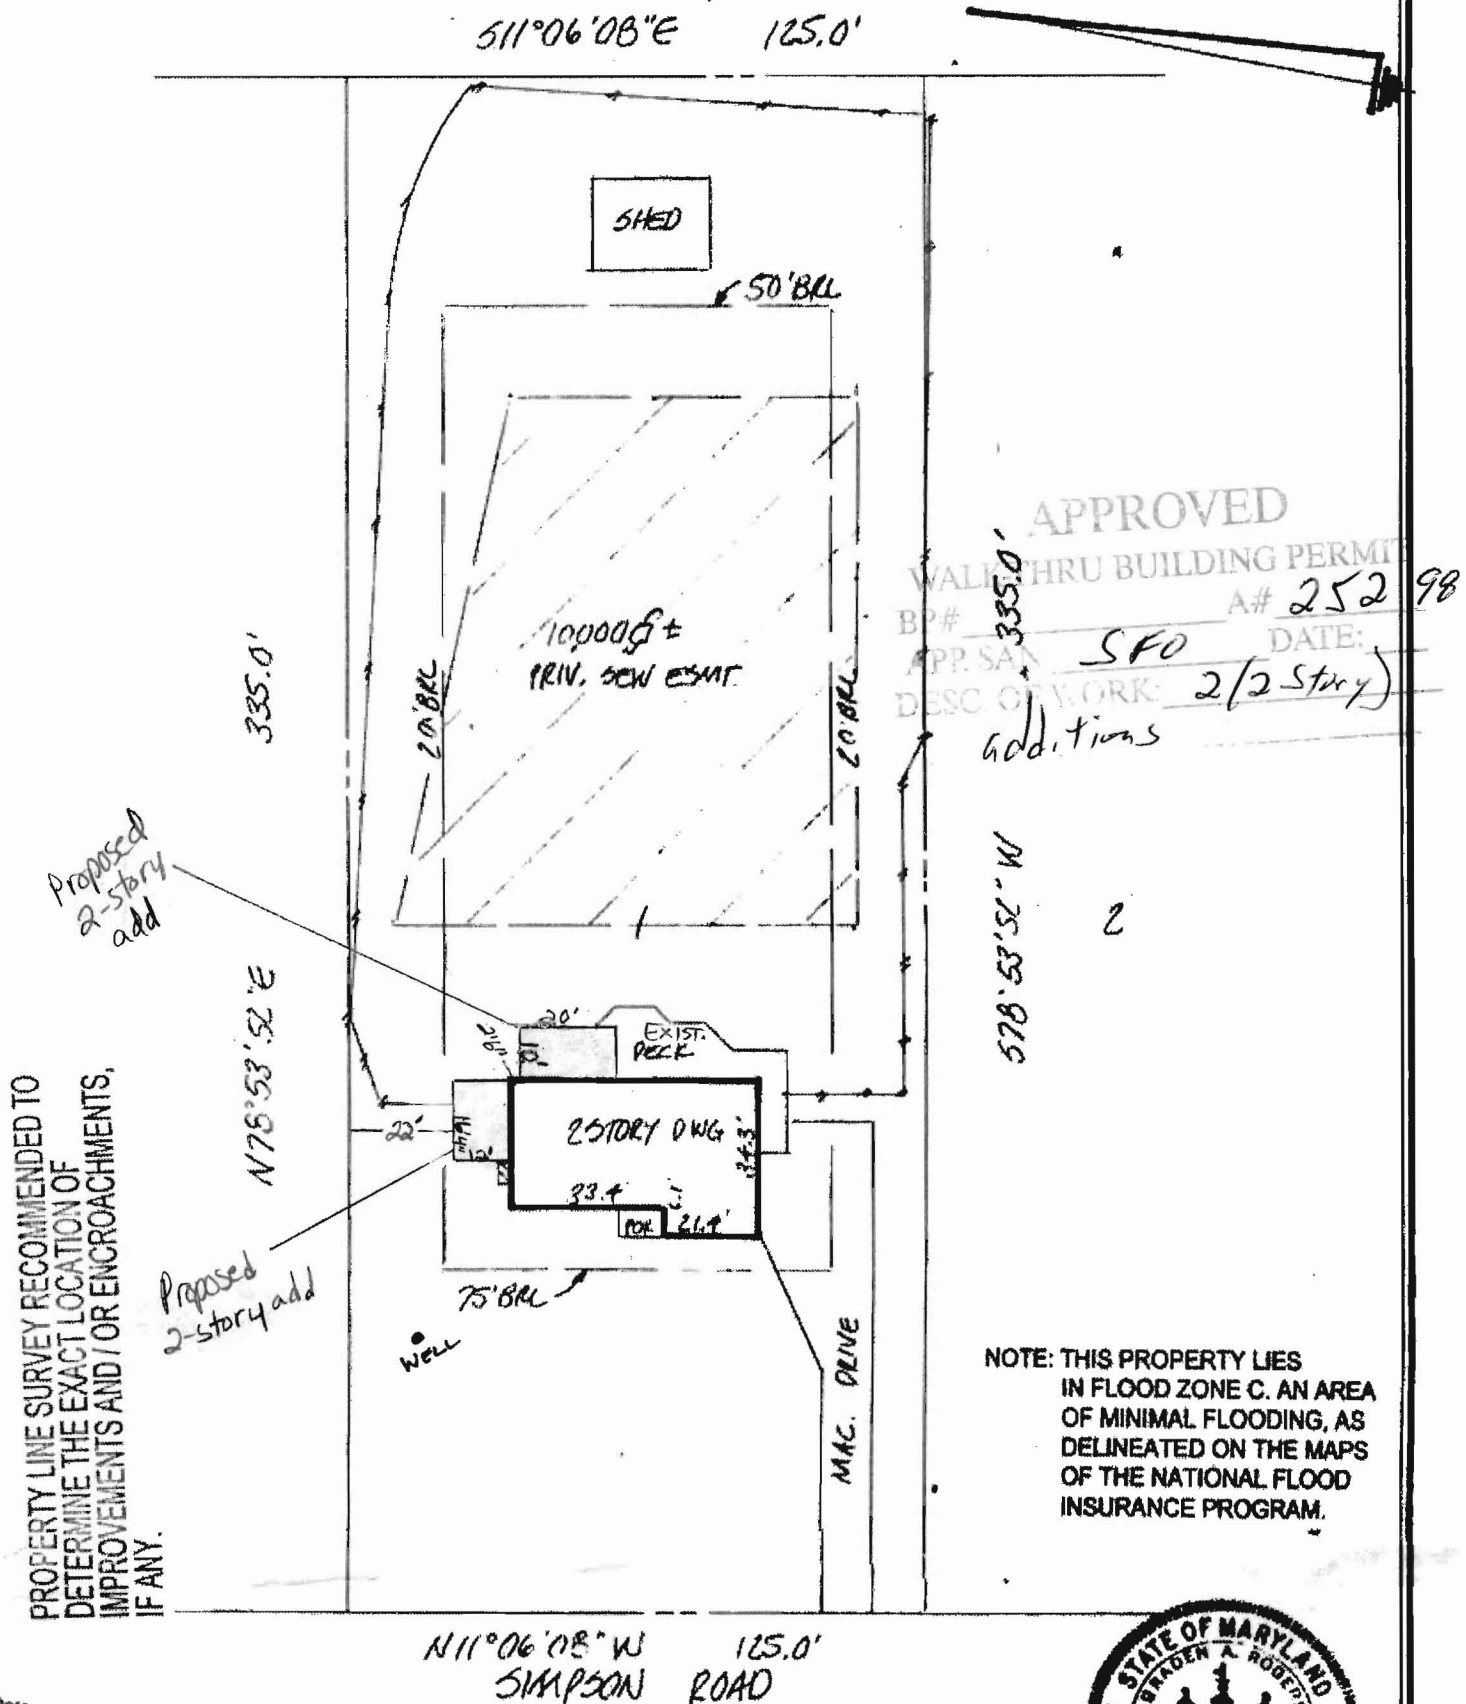

Notes:

- 1) This plat is of benefit to a consumer only insofar as it is required by a lender or a title insurance company or its agent in connection with contemplated transfer, financing or re-financing.
- 2) This plat is not to be relied upon for the establishment or location of fences, garages, buildings, or other existing or future improvements.
- 3) This plat does not provide for the accurate identification of property boundary lines, but such identification may not be required for the transfer of title or securing financing or refinancing.
- 4) No title report furnished.

Certification: This is to certify that the improvements indicated hereon are located as shown.

Graden A. Rogers
GRADEN A. ROGERS - Propri. L.S. MD. Lic. No. 119

LIBER _____ FOLIO _____
LOT _____ BLOCK _____ SECT. 1 PLAT _____
PLAT ENTITLED SIMPSON WOODS AR. 1
RECORDED IN HOWARD CO. MD.
PLAT BOOK 3754 FOLIO _____

11906 SIMPSON ROAD
Merkwitz/Bustos
SCALE 1" = 40' CASE NO. 09001827
DATE 8-6-03 JOB NO. MSC20031174

