

# PERMIT

SEWAGE DISPOSAL SYSTEM

MARYLAND STATE DEPARTMENT OF HEALTH

HOWARD COUNTY

INDEXED

P 17347

A 17170

ELLICOTT CITY

DISTRICT 2nd

DATE 8/15/72

Walter Shank

IS PERMITTED TO INSTALL ☒ ALTER

ADDRESS 13194 Sky Way, Ellicott City, Md. PHONE 531-5631

A SEWAGE DISPOSAL SYSTEM LOCATED AT

SUBDIVISION ROAD Sky Way off Walt-Ann Dr. Lot

PROPERTY OWNER Walter Shank & wife

ADDRESS same as above

SPECIFICATIONS 4 bedrooms

DRAIN FIELD DEPTH FEET, BOTTOM AREA SQ. FT.

SEEPAGE PITS ABSORBENT SIDE-WALL AREA SQ. FT.

SEPTIC TANK CAPACITY 1250 GALLONS

FOR GARBAGE GRINDER, INCREASE DISPOSAL AREA 22% & TANK CAPACITY 50%.

OTHER DRY WELL - 560 sq. ft. sidewall area below the inlet with the inlet no deeper than 6 ft. and the bottom of the dry well no deeper than 12 ft. Place the dry well 20 ft. from the Hudson property and 50-75 ft. from new driveway.

NOTE: ALL PIPE FROM HOUSE TO SEPTIC TANK MUST BE CAST IRON.  
PERMIT VOID AFTER THREE YEARS.

NOTE: INSTALL STAND PIPE ON SEPTIC TANK AND DRY WELL.


PLANS APPROVED BY Raymond Hodges DATE 7/13/72

FILL SEPTIC TANK AND DISTRIBUTION BOX WITH WATER BEFORE CALLING FOR AN INSPECTION. COVER NO WORK UNTIL INSPECTED AND APPROVED.

NEITHER THE HOWARD COUNTY COMMISSIONERS NOR THE HEALTH DEPARTMENT IS RESPONSIBLE FOR THE SUCCESSFUL OPERATION OF ANY SYSTEM.

(Lot D)  
refer to drawing attached

17170

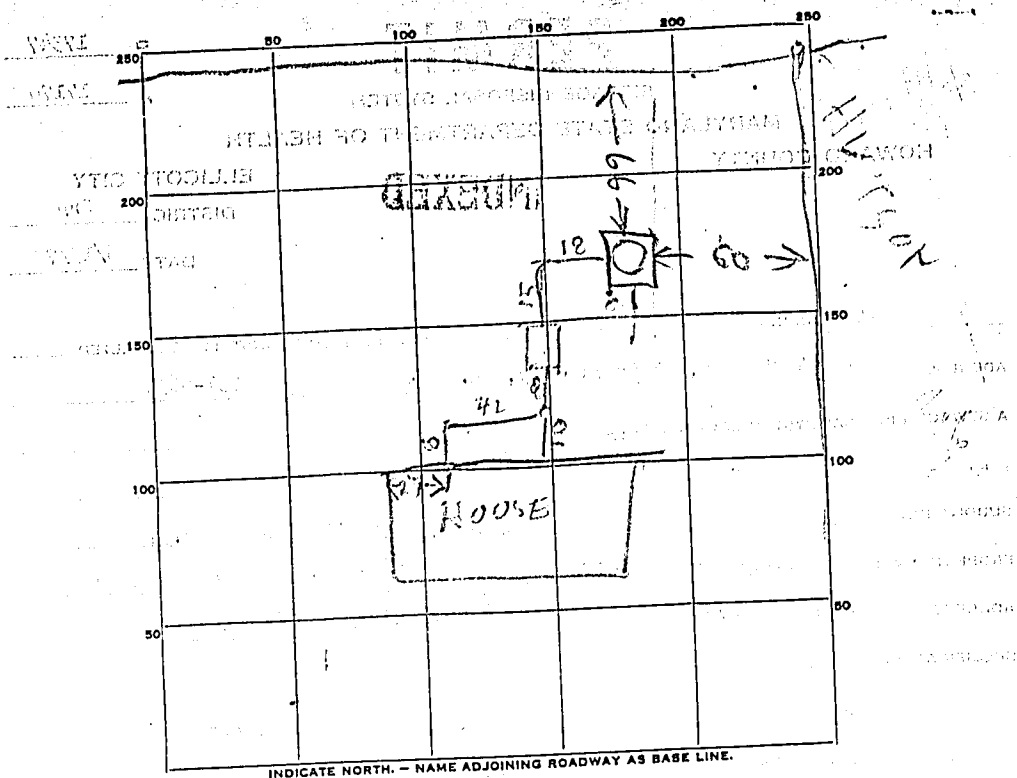

PERMIT CARD \_\_\_\_\_

SEPTIC TANK, LEVEL on concrete 1200 CLEANOUTS 0

DISTRIBUTION BOX, LEVEL top 11' below grade

TILE FIELD, DEPTH \_\_\_\_\_ FT. TRENCH WIDTH \_\_\_\_\_ FT.

GRAVEL DEPTH \_\_\_\_\_ IN. TOTAL LENGTH \_\_\_\_\_ FT.

NUMBER OF TRENCHES \_\_\_\_\_ TOTAL BOTTOM AREA \_\_\_\_\_

SEEPAGE PITS, INSIDE DIAMETER 12 FT. DEPTH BELOW INLET 10 FT.

ABSORBENT AREA 360 SQ. FT. not counting stone

REMARKS 3/5/73 Dry Well 4' below 3' 7' below grade  
Perimeter of tank is 70' x 7'

Well not yet drilled

DATE SYSTEM APPROVED 3/5/73 INSPECTOR Thompson/Kodas