

PERMIT NUMBER: B

20003612

DATE ACCEPTED:

OCT 08 2020

RECEIVED

RESIDENTIAL BUILDING PERMIT APPLICATION

HOWARD COUNTY DEPARTMENT OF INSPECTIONS, LICENSES, AND PERMITS

3430 COURT HOUSE DRIVE, ELLICOTT CITY, MD 21043

PHONE: (410) 313-2455 OPTION #4

www.howardcountymd.gov

BUILDING SITE ADDRESS REQUIRED

Street Address: 15457 Rivercrest ct.

Unit:

City: Brookville

State: MD

Zip Code: 20833

Subdivision/Village/Complex Name: Rivercrest

SDP/WP/BA #:

Lot: 12

Tax Map: 21

Parcel:

Grading Permit #:

DESCRIPTION OF WORK REQUIRED

Existing Use: new single family home

Proposed Use: LP gas

Estimated Cost: \$3,500.00

Trade Work to Be Completed (Separate Permits Required): ☐ Mechanical (HVACR) ☐ Electrical ☐ Plumbing ☒ None

Install new inground LP gas tank -500 gal/capcity

PROPERTY OWNER INFORMATION REQUIRED

Owner(s) Name(s) (As it appears on tax records): Columbia builders, inc.

Primary Residence: ☐ Yes ☒ No

Owner's Street Address: P O Box 999

City: Columbia,

State: MD

Zip Code: 21044

Phone:

Email:

APPLICANT NAME REQUIRED - INDIVIDUAL WHO SIGNS THIS APPLICATION

Business Name: Bluestream Service Inc

Contact Name: Gary Skovron

Street Address: 2298 Jim Kohler rd.

City: Eldersburg

State: MD

Zip Code: 21784

Phone: (410) 363-0072

Email: bluestreamservices@comcast.net

CONTRACTOR INFORMATION REQUIRED

Business Name: Bluestream Service Inc

Licensee's Name: Gary Skovron

License #: 5563

Street Address: 2298 Jim Kohler rd

City: Eldersburg

State: Md

Zip Code: 21784

Phone: (410) 363-0072

Email: bluestreamservices@comcast.net

ARCHITECT/ENGINEER INFORMATION INDIVIDUAL WHO SIGNED PLANS, IF APPLICABLE

Business Name:

Name:

Street Address:

City:

State:

Zip Code:

Phone:

Email:

BUILDING CHARACTERISTICS REQUIRED

Primary Structure: ☒ SF Dwelling ☐ SF Townhouse ☐ SF Duplex ☐ Mobile Home ☐ Multi-Family Dwelling (MF*)

Condo: ☐ Yes ☐ No

Utilities: ☐ Electric ☒ Gas

Water Supply: ☐ Public ☒ Private (Well)

Sewage Disposal: ☐ Public ☒ Private (Septic)

Heating System: ☐ Electric ☐ Natural Gas ☒ Propane ☐ Other:

Roadside Tree Project: ☐ No ☐ Yes: #

Sprinkler System: ☐ NFPA 13 ☐ NFPA 13R ☐ NFPA 13D ☐ None

Fire Alarm System: ☐ Yes ☐ No ☐ Voice Evac

ADDITIONAL RESIDENTIAL INFORMATION (PLEASE SELECT/COMPLETE ALL THAT APPLY)

Model Name & Options:

of Bedrooms (SF):

of efficiency units (MF*):

of 1 BR (MF*):

of 2 BR (MF*):

of 3 BR (MF*):

Rooms:

Full Baths:

Half Baths:

Fireplaces:

Garage/Carport Info: ☐ Attached Garage ☐ Detached Garage ☐ Integral Garage ☐ Carport ☐ None

Basement/Foundation Info: ☐ Slab on Grade ☐ Post & Pier ☐ Unfinished Basement ☐ Finished Basement: ☐ Full or ☐ Partial

1st Fl Width:

1st Fl Depth:

2nd Fl Width:

2nd Fl Depth:

Bsmt Width:

Bsmt Depth:

Energy Method: ☐ Prescriptive ☐ Performance ☐ UA Alternative ☐ ERI

Gross Area:

sq ft

Occupiable Area:

sq ft

AGREEMENT/ DISCALIMER REQUIRED

THE UNDERSIGNED HEREBY CERTIFIES AND AGREES AS FOLLOWS: (1) THAT HE/SHE IS AUTHORIZED TO MAKE THIS APPLICATION; (2) THAT THE INFORMATION IS CORRECT; (3) THAT HE/SHE WILL COMPLY WITH ALL REGULATIONS OF HOWARD COUNTY WHICH ARE APPLICABLE THERETO; (4) THAT HE/SHE WILL PERFORM NO WORK ON THE ABOVE REFERENCED PROPERTY NOT SPECIFICALLY DESCRIBED IN THIS APPLICATION; (5) THAT HE/SHE GRANTS COUNTY OFFICIALS THE RIGHT TO ENTER ONTO THIS PROPERTY FOR THE PURPOSE OF INSPECTING THE WORK PERMITTED AND POSTING NOTICES.

APPLICANT'S ORIGINAL SIGNATURE

DATE SIGNED

10/6/20

FOR OFFICE USE ONLY

CHECKS PAYABLE TO: DIRECTOR OF FINANCE OF HOWARD COUNTY

AGENCIES REQUIRED/APPROVALS:

☒ PR

☒ DPZ

☒ DED

☒ Health

☐ SHA

☐ CID

SUBMITTAL FEES: \$110.00

PAYMENT: #004863


ACCEPTED BY: Dmpbox

Quality Steel Corporation Domestic Tank Specifications

Tank Specifications


Height from Top of Tank to Demo Top

AG	7.50
AG/UG	10.75
AG/UG Long	14.75
UG (SNR)	14.75
UG (LNR)	26.75

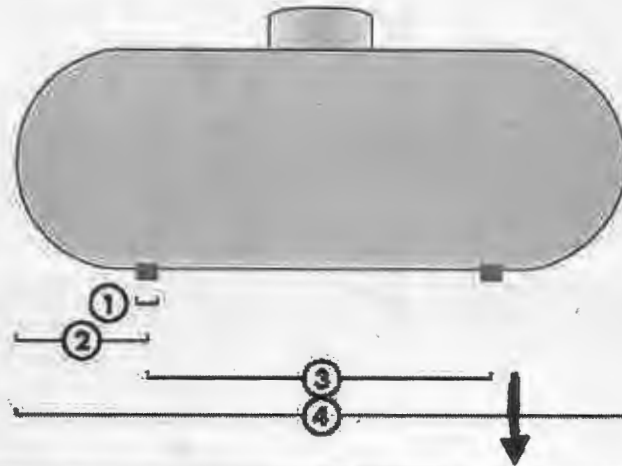

Tank Size (in gallons)	120	150	250	320	475	500	1000
Dimensions	24x67	24x82	30x92	30x114	37x113	37x120	41x190
Approximate Weight (in pounds)	260	380	480	620	920	940	1800
Shell Thickness	0.140	0.140	0.175	0.175	0.218	0.218	0.238
Head Thickness	0.138	0.138	0.148	0.148	0.184	0.184	0.201
① Leg Width	2.5	2.5	2.5	2.5	3	3	3
② Leg Distance from Edge of Shell	6.5	2.75	1.75	6	4	4	4
③ Leg Distance from Center to Center	34.5	39	60	60	60	60	141.5
④ Shell Width	50	67	64	87	75	81	149

All dimensions are in inches unless otherwise noted. Dimensions may vary +/- 1".

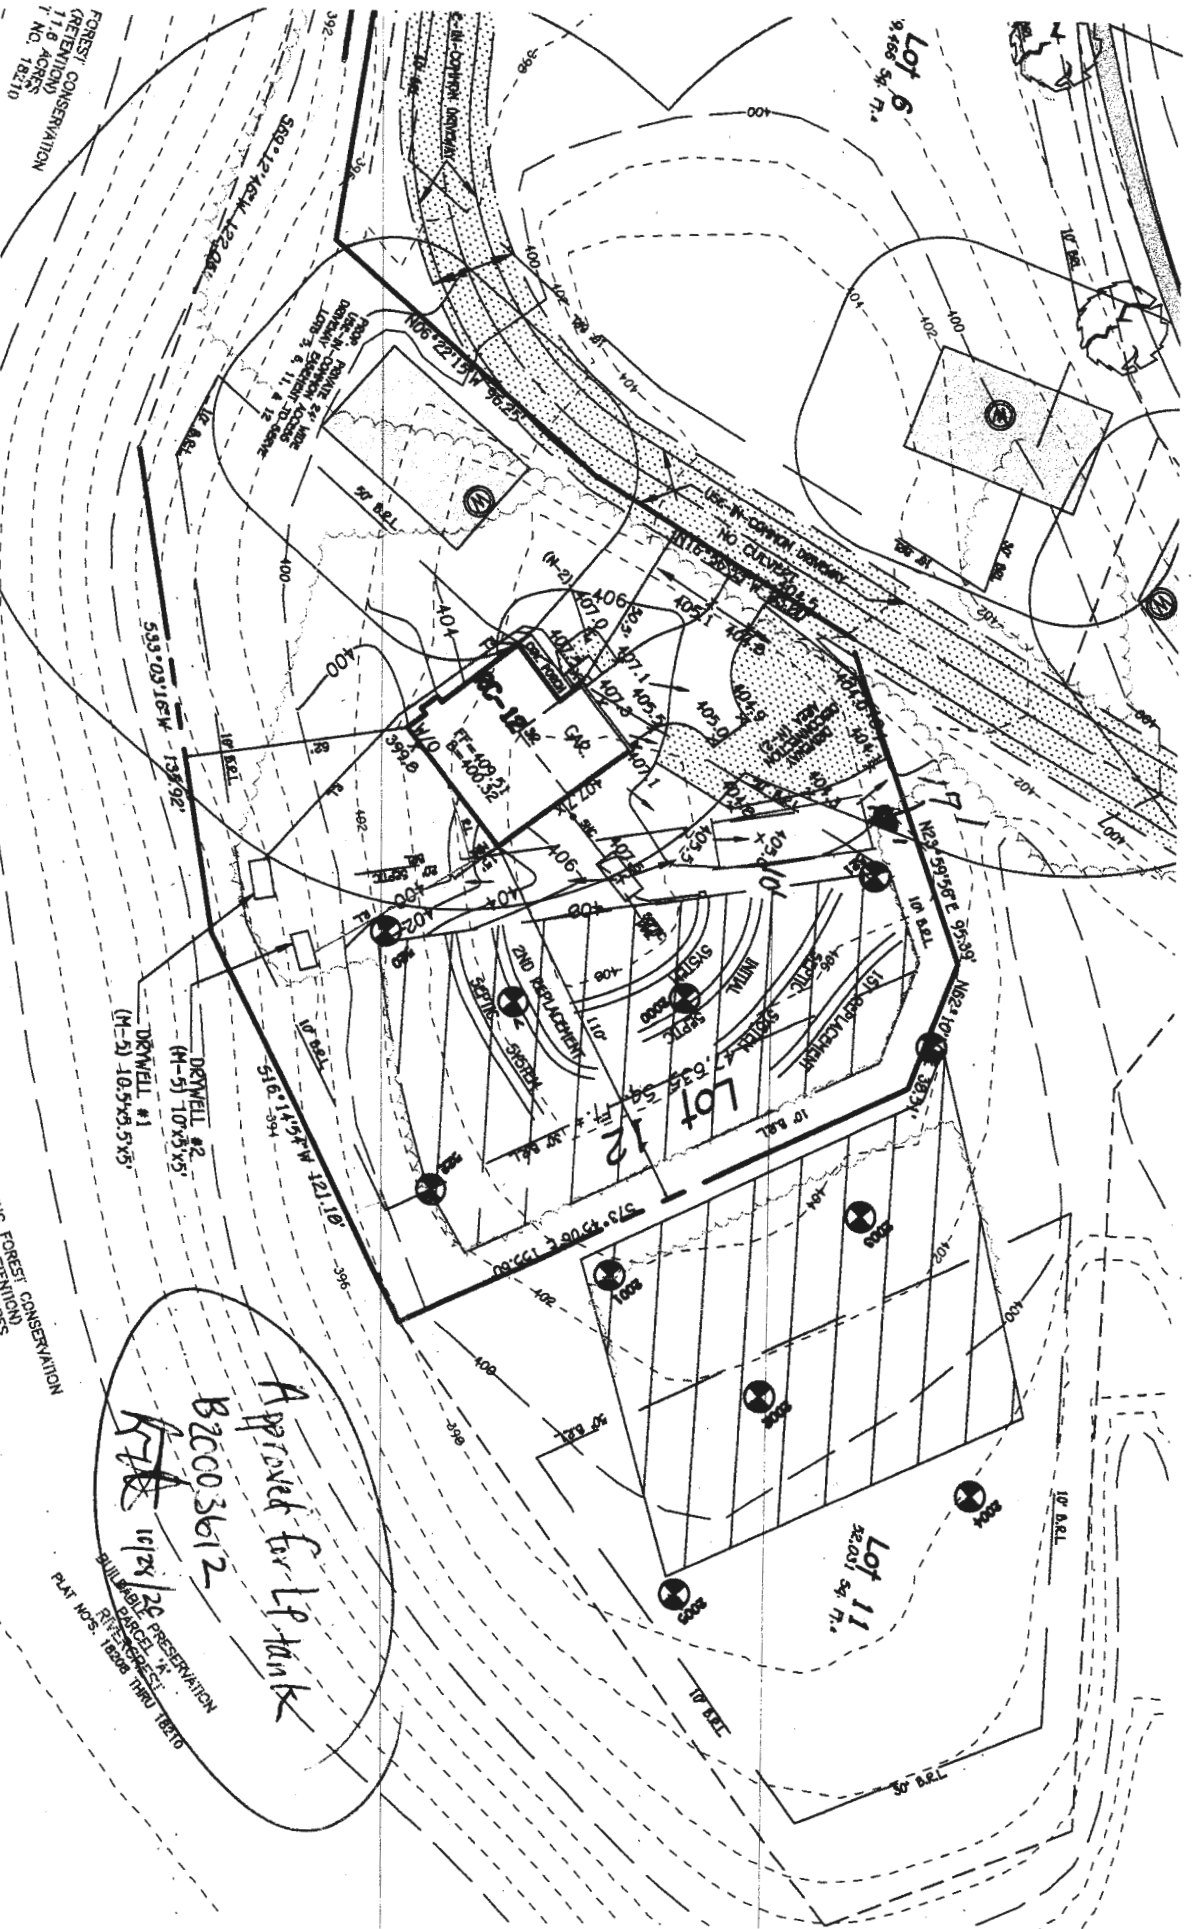

RIVERCREST Lot 12