

Bureau of Environmental Health

8930 Stanford Boulevard, Columbia, MD 21045 Main: 410-313-2640 | Fax: 410-313-2648 TDD 410-313-2323 | Toll Free 1-866-313-6300 www.hchealth.org


Facebook: www.facebook.com/hocohealth

Maura J. Rossman, M.D., Health Officer

RECEIPT DATE: 10/8/2021 ONSITE SEWAGE DISPOSAL SYSTEM P 570187					
APPROVAL DATE: Who was PERMIT: REPAIR A Repair					
PROPERTY ADDRESS: 11800 Triadelphia Road					
SUBDIVISION: LOT: TAX ID: 03-280292					
CONTRACTOR: Freedom Septic EMAIL: Christy@freedomseptic.com					
CONTRACTOR ADDRESS: 2809 Liberty Rd, Sykesville, MD 21784 PHONE: 410-795-2947					
PROPERTY OWNER: James Wagandt EMAIL:					
OWNER ADDRESS: Same PHONE: 443-844-2828					
SEPTIC TANK SIZE: 1500 PUMP TANK CAPACITY: n/a PUMP SIZE: n/a					
DISTRIBUTION SYSTEM: GRAVITY PRESSURE DOSED BEDROOMS: 4 APPLICATION RATE: 0.6					
LINEAR FEET REQUIRED: 104 INLET DEPTH: 3'					
TRENCHES: TRENCH WIDTH: 3 MAXIMUM BOTTOM DEPTH: 7					
MINIMUM SPACE BETWEEN TRENCHES: 11 EFFECTIVE AREA BEGINNING DEPTH: 5					
LOCATION: TO BE STAKED BY SANITARIAN DURING PRE-CONSTRUCTION INSPECTION.					
Install new septic tank per layout at time of perc test. Owner expressed a possible addition off existing house extending aprx. 25' or so. Owner was onsite when proposed new S.T. location proposed. Install 2x52' trenches just above perc test A running towards property line. Existing cesspool to be pumped and collapsed.					
ISSUED BY: K. Wolf ISSUE DATE: 10/7/2021 EXPIRATION DATE: 10/7/2022					
NOTE: CONTRACTOR MUST SCHEDULE A PRE-CONSTRUCTION INSPECTION PRIOR TO BEGINNING ANY INSTALLATION					
NOTE: CONTRACTOR MUST SCHEDULE AN INSPECTION AND GAIN APPROVAL OF ALL COMPONENTS PRIOR TO COVERING					
NOTE: STONE MUST BE APPROVED BY HEALTH DEPARTMENT AND GRAVEL TICKET MUST BE AVAILABLE FOR REVIEW.					
NOTE: WATERTIGHT SEPTIC TANKS REQUIRED NOTE: ALL PARTS OF SEPTIC SYSTEM SHALL BE AT LEAST 100 FEET DOWNGRADIENT FROM ANY WATER WELL					
NOTE: MANHOLE RISERS REQUIRED ON ALL SEPTIC TANKS AND PUMP CHAMBERS					
NOTE: AN ELECTRICAL PERMIT IS REQUIRED FOR INSTALLATION OF ANY ELECTRICAL COMPONENTS OF THE SYSTEM ELECTRICAL PERMIT ISSUED E n/a					
NOTE: THE HCHD DOES NOT WARRANTY ANY SYSTEM AND CANNOT GUARANTEE THE PERFORMANCE OF THIS SYSTEM AS DESIGNED. BY ACCEPTING THIS PERMIT, THE OWNER AND/OR APPLICANT ACKOWLEDGE THAT THE SPECIFICATIONS DETAILED IN THIS DESIGN ARE ONE POSSIBLE OPTION AND THAT THE HCHD WILL REVIEW OTHER PROPOSALS. YOU HAVE THE OPTION TO SEEK THE ADVICE OF A QUALIFIED DESIGN CONSULTANT OR PROFESSIONAL ENGINEER FOR FURTHER GUIADNCE.					
NOTE: AN INDIVIDUAL CERTIFIED BY MDE AND THE MANUFACTURER FOR BAT INSTALLATION MUST BE PRESENT AT ALL TIMES DURING BAT INSTALLATION.					
NOTE: MDE RECOMMENDS SEPTIC TANKS, BAT, AND OTHER PRETREATMENT UNITS BE PUMPED AT A FREQUENCY ADEQUATE TO ENSURE THAT SOLIDS ARE NOT DISCHARGED TO THE DISPOSAL AREA					

NEITHER THE HOWARD COUNTY COUNCIL NOR THE HEALTH DEPARTMENT IS RESPONSIBLE FOR THE SUCCESSFUL OPERATION OF ANY SYSTEM.

PERMITTEE RESPONSIBLE FOR OBTAINING FINAL APPROVAL ON THIS PERMIT.
CALL 410-313-1771 TO SCHEDULE INSPECTIONS.

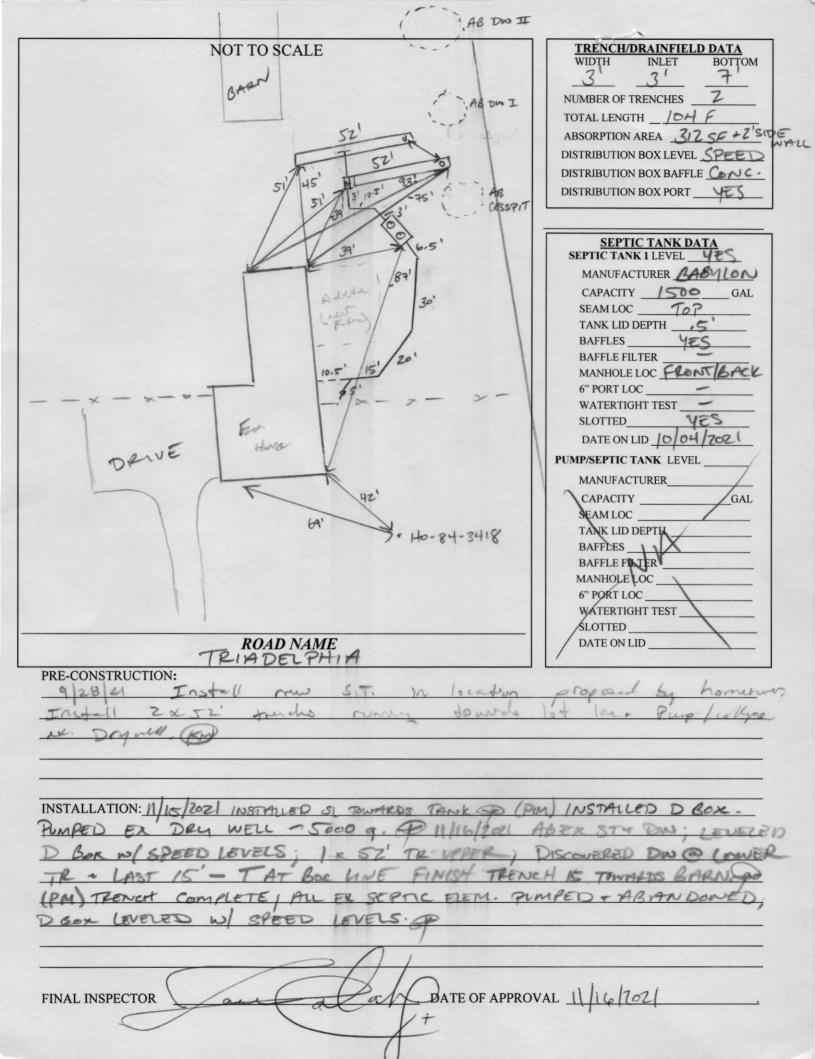



Bureau of Environmental Health 8930 Stanford Blvd | Columbia, MD 21045 410.313.2640 - Voice/Relay 410.313.2648 - Fax 1.866.313.6300 - Toll Free

Maura J. Rossman, M.D., Health Officer

INFORMATION FORM - SEPTIC SYSTEM REPAIR/UPGRADE

Reason for Request:	Has the septic tank been pumped within the last month?
Failing System System relocation for proposed addition System upgrade for proposed addition Inadequate treatment zone Collapsed septic tank Collapsed drywell	Yes
Existing system design	Was a visual inspection of the sewage line conducted?
Drywell Trench Mound Unknown Other:	Yes No Blockage Leading to the field Yes Explain UN UNDUM
Is discharge surfacing on the ground?	
∕—Yes No	
Additional Comments:	
garages, etc? This information must be disclosed at the time of t	In the future any additions or modifications to the property, i.e. pools, living space additions, his application. The Health Department will not be able to accommodate requests in the field for puests may require an additional fee, testing, and submittal of a Percolation Certification Plan, if Contractor's Phone: 40.785.2947 County File:
*A Sanitarian will be in contact within three business days	
the repair or upgrade. *Prior to scheduling inspections, scaled plans should be so Print out a copy of Real Property Data via Dept. of Taxatio If soil/site conditions are limited and sewer and/or Metro of Emergency Sewer Extension or Emergency Metro Distri	Indexed file found District status is not conducive to connection, the Sanitarian may recommend pursuit ict Inclusion. The Owner should contact the Bureau of Utilities for details. without prior fee collection at the office unless an emergency exists.

2/2020

1A	IΩ	nc	ite	
	, –	wa	116	

