

Record Detail * (This section is required.)

Permit Type	Permit Number	Opened Date
Building/Residential/Misc/Tanks	B22001001	03/23/2022
Description of Work		
SFD/ Setting 2-120 AG LP Tanks		

[check spelling](#)

Address * (This section is required.)

Search Reset Clear Get Parcel & Owner

Street #	Street Name	Street Type
1130	SAINT MICHAELS	RD
Unit Type	Unit #	X Coordinate
--Select--		-77.10694
		Y Coordinate
		39.33879
City	State	Zip Code
MOUNT AIRY	MD	21771
	Primary	Yes

Parcel * (This section is required.)

Search Reset Clear Get Address & Owner

GIS ID *	Parcel	Parcel Area	Land Value	Improved Value	Exemption Value	Plan Area
830876	36	1.94	219400	411400	192000	RURAL

Legal Description

IMPSLOTS 23,24,25,26,27,[]1130 SAINT MICHAELS RD[]POPLAR HEIGHTS

[check spelling](#)

Block	Lot	Census Tract	Council Dist	Inspection Dist	Supervisor Dist	Map #	DAP Zone
	23 24	604001	5				
Plan Area	State Tax Id	Subdivision Name					
	1404326849	Popular Heights Subdivision					
Section	Area	Tax Map					
		7					
Grid	Zoning District	ADC Map					
7-8	RC-DEO	4691-C6					
SDP No.	Final Plan No.	WP File No.					
Record Plat No.	WS Contract No.	FDP No.			Primary		
3/026					Yes		
Owner Occupied	Year Built	Historic District					
☐ Yes ☐ No	1966	☐ Yes ☒ No					
Historic District Registry No.	Stat Area	Flood Plain					
	4-04	☐ Yes ☒ No					
Building No							

Owner * (This section is required.)

Search Reset Clear

Name *	
ROCHE BRIAN E ETAL	
Address Line 1	
1130 Saint Michaels Rd	
Address Line 2	
Address Line 3	
Mail City	Mail State
Mt Airy	MD
Phone	Mail Zip Code
240-674-6042	21771
E-mail	Primary
	Yes

Approved 3/31/22


javis@carrollhomeservices.com

Cell Number

Fax Number

Professionals (This section is not required.)

Search

Reset

Clear

License # * 20020006908
License Type * Plumb/Gas
Primary Yes
Business Name ARCO MECHANICAL SERVICES
First Name JOHN
Middle Name
Last Name TEWEY
Address Line 1 10008 MAGLEDT RD0
Address Line 2
City BALTIMORE
State MD
ZIP Code 21234-0000
Phone 1 4109088180
Phone 2
Fax
E-mail JOHN.TEWEE@YAHOO.COM

Applicant (This section is not required.)

Search

As Owner

As Lic. Prof

As Contact

Type * Applicant
Relationship Applicant
Primary Yes
First Name John
MI
Last Name Mazura
Full Name John Mazura
Organization Name Carrollhomeservices.com
Street Address 1105 Camberley Ct
Address Line 2
City ABINGDON
State MD
Zip Code 21009
Phone 410-937-5882
Cell
Fax
E-mail jmazura@carrollhomeservices.com

Addtl Info

Est Construction Cost * 1500
Housing Units * 0
Number of Buildings * 0
Public Owned No
Construction Type 329 - Structures Other Than Buildings (Retaining Walls/Tents)

TANK INFORMATION

RESIDENTIAL TANK INFORMATION

Capital Project-No Fee * ☐ Yes ☒ No
Capital Project Number
Fee Exempt * ☐ Yes ☒ No
Roadside Tree Project Permit * ☐ Yes ☒ No
Roadside Tree Permit #
Existing Use SFD
Number of Tanks Installed * 2
Number of Tanks Removed * 0
Water Supply Private
Sewage Disposal Private
Expiration Date 9/27/2022
Relocate Existing Tank * 0

PAYMENT INFORMATION


Check 1 Payee 1 Check 2 Payee 2 SAP Doc No SAP Entered

Submit Cancel

Brian Roche
 1130 Saint Michael Rd
 Alt Any MD 21771



1130 St. Michael

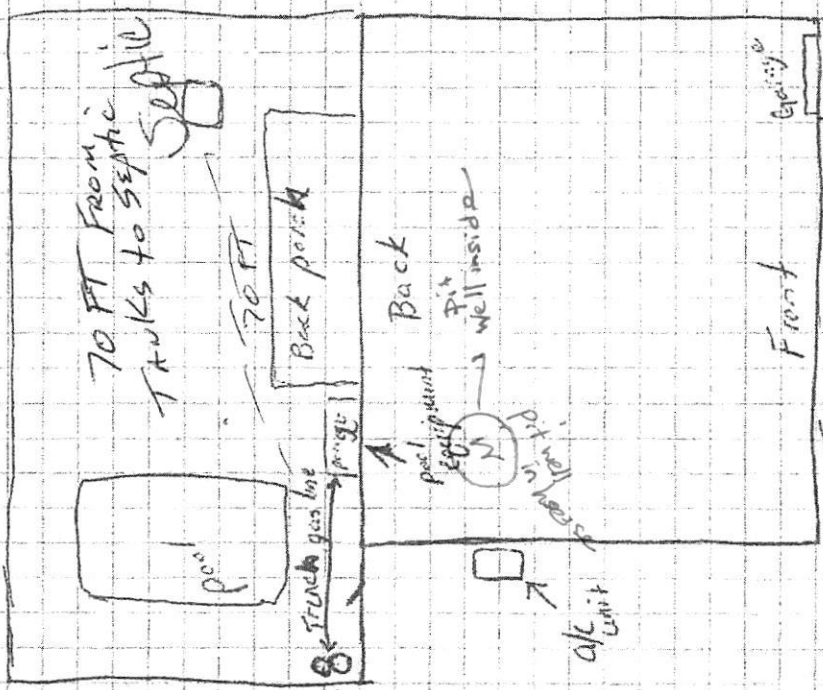

Well under House

Set Backs
 Front - 80 ft
 Back - 115 ft
 Left - 78 ft
 Right - 144 ft

Approved for LP tank
 B22001001
 2/16/12

Approved for LP tank
 B22001001
 Set backs good -
 Check archive files