

APPLICATION

SEWAGE DISPOSAL TESTING

MARYLAND STATE DEPARTMENT OF HEALTH

A 14334

P _____

HOWARD COUNTY

ELLICOTT CITY

DISTRICT 4

DATE 3/14/69

Preliminary 3/26/69 9:30
Septic Tank - 750 gal.
Dry Well - 300 sq ft absorbent sidewalk area
below inlet pipe inlet pipe 3 1/4 ft below original grade
May Dept permits for dry well is 12 ft below original grade
Place dry well 54 ft from rear lot line and 51 ft from right
sideline as seen when facing lot from South Alley

TO: THE COUNTY HEALTH OFFICER
ELLICOTT CITY, MARYLAND

I, HEREBY, APPLY FOR THE NECESSARY TESTS IN ORDER TO CONSTRUCT (OR RECONSTRUCT) A SEWAGE DISPOSAL SYSTEM.

PROPERTY OWNER Paul H. Jegerdt

ADDRESS Lisbon, Maryland PHONE 489-4170

PROPERTY LOCATION:

SUBDIVISION _____ LOT NO. 90

ROAD AND DESCRIPTION South Alley - go by Lisbon School bear right - middle lot
between Dayhoff & Esworthy.

OCCUPANT _____ PHONE _____

PERSON TO CONSTRUCT SYSTEM _____

ADDRESS _____ PHONE _____

SIZE OF LOT 66' x 165' TYPE BLDG. _____

NUMBER OF BEDROOMS

IF NOT SINGLE RESIDENCE DESCRIBE _____ (Single Fmly. Dwllg.)

SIGNATURE OF APPLICANT Mary T. Mathis

APPROVED BY Donald W. Monaghan FOR Dry Well DATE 3/26/69

(KIND OF SYSTEM)


REJECTED BY _____ FOR _____ DATE _____

(KIND OF SYSTEM)

HOLD PENDING FURTHER TESTS _____ DATE _____

REASONS FOR REJECTION OR HOLDING _____

THIS IS NOT A PERMIT

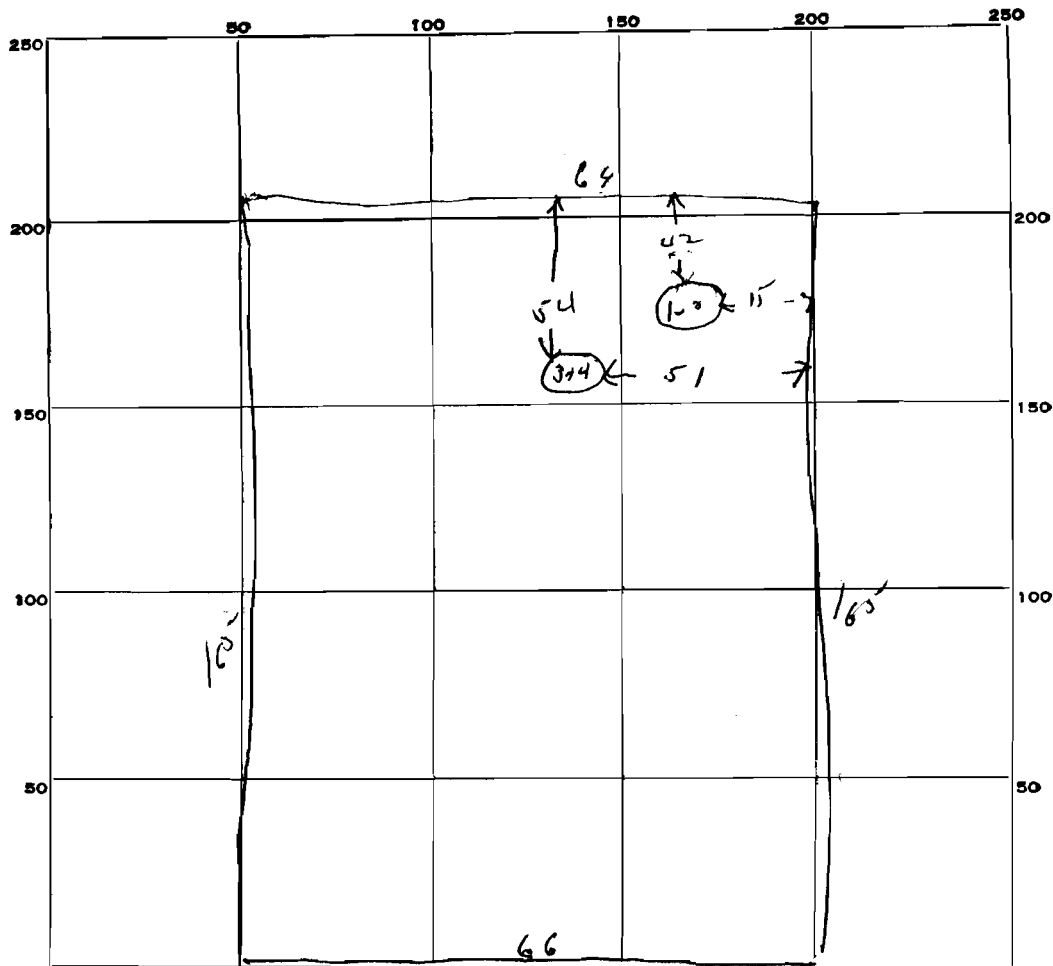

INDICATE NORTH. - NAME ADJOINING ROADWAY AS BASE LINE.

South Alley

DATE	TEST NO.	DEPTH	PRE-WET		TEST - 1" DROP		TIME
			START	STOP	START	STOP	
5/24/64	1	9 ft	10 03	10 09	10 10	10 18	8 min
	2	10 ft	10 06	10 08	10 08	10 14	6 min
	1 A	4 ft	10 07	10 17	10 13	10 20	7 min
	2 A	3 ft	10 08	10 10	10 10	10 16	6 min

SOIL AUGER FINDING

TESTED BY DM

REMARKS


Observe H & P. 1st

APPROVED FOR PRIVATE WATER & SEWERAGE

DR. THEODORE R. SHROP


DATE

HOWARD COUNTY HEALTH OFFICER

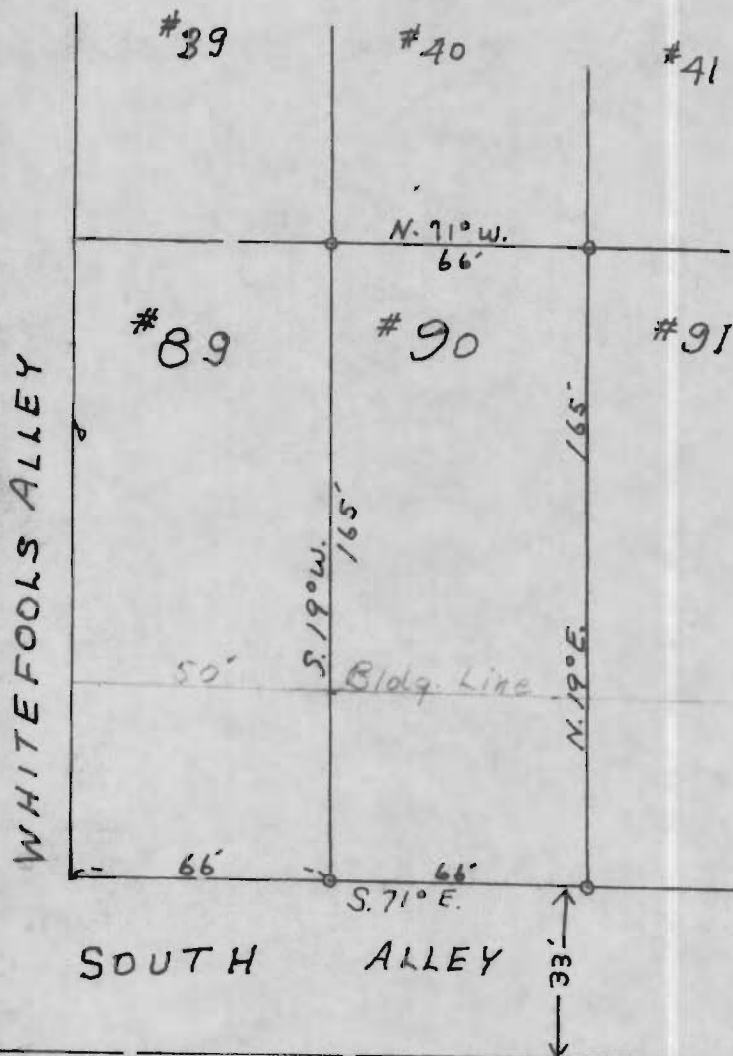

APPROVED BY VIRTUE OF PLANNING COMMISSION ACTION

T. G. HARRIS, JR. PLANNING DIRECTOR - DATE
HOWARD COUNTY PLANNING COMMISSION.

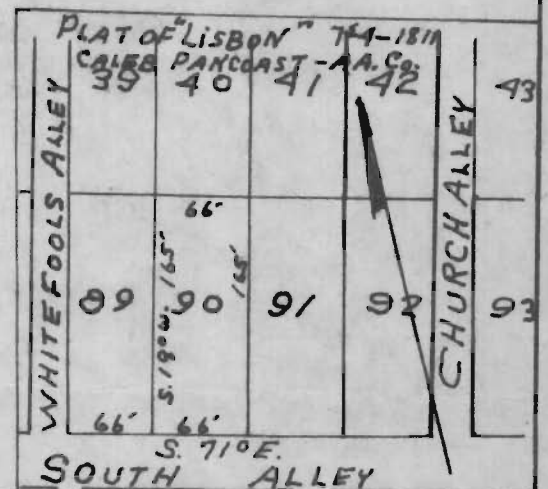

PREPARED BY
J. HARRY KOLLER
REG. LAND SURVEYOR
No. 250
Rt. 2, SYKESVILLE, MD.
21784
PHONE, 301-795-1639

OWNER: PAUL H. JOGEREIT
FOURTH ELECTION DISTRICT,
HOWARD COUNTY, MD.
TITLE REFERENCE
LIBER W.H.H. No. 474, Folio 124

SCALE: 1" = 50'