


SITE INSPECTION SHEET

OWNER: _____ PHONE #: 410-419-3273
ADDRESS: 10981 Scaggsville Rd. CONTRACTOR: Paul Arnold
_____ WELL TAG #: _____
SUBDIVISION: _____ LOT: _____ COUNTY #: _____
PROPOSAL: Refinish basement after water damage.

LOCATION DIAGRAM

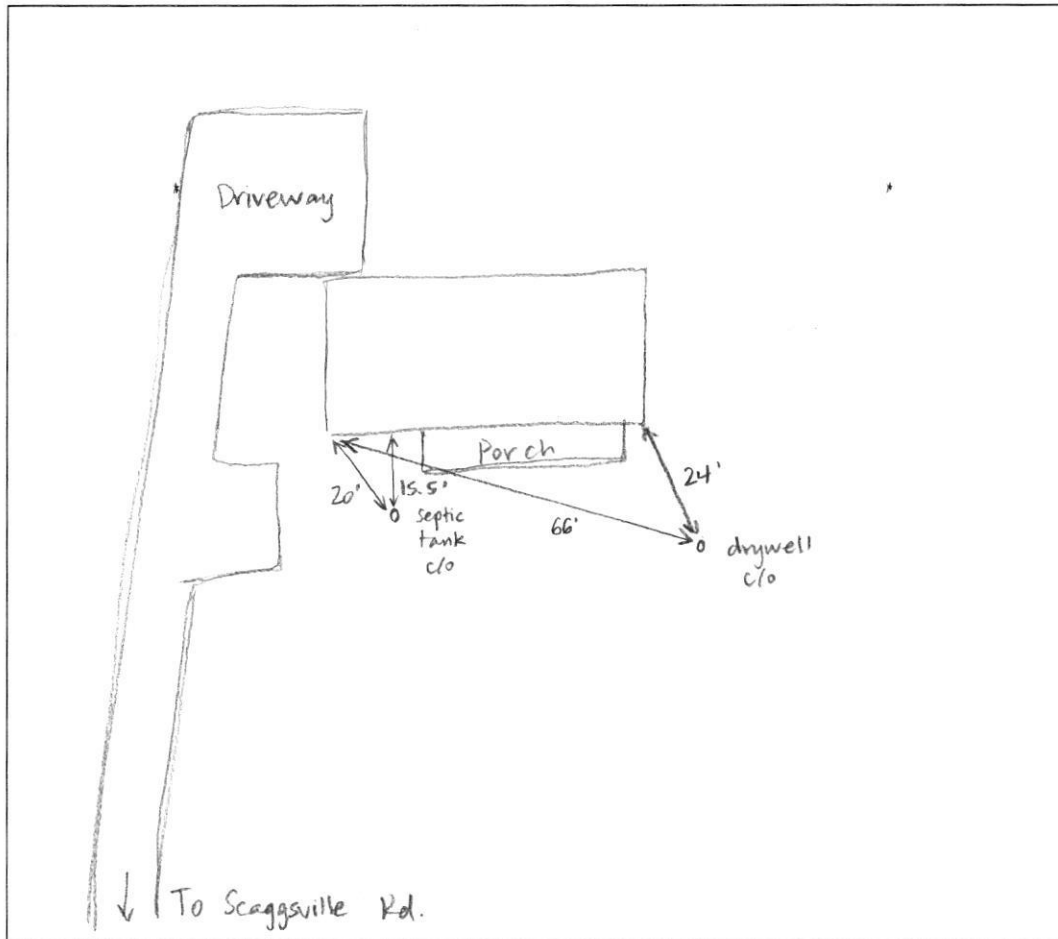

COMMENTS: Drywell measured - 11' to bottom. 32" to liquid from
grade. Septic tank is 29" to scum/liquid from grade.

DATE: 1/5/18 INSPECTOR: S. Collins

FILE INQUIRY NOTES

(10981 Scaggsville Rd.)

DATE	RESULTS OF REVIEW FOR FILE
1/4/18	Contractor (Paul Arnold 410-419-3273) came in to office w/ a BP for walk thru to re-finish basement that had extensive H₂O damage. No living space addition proposed. Looking @ existing floor plans from Mr. Arnold showed 3 existing Bedrooms on First floor, 3 existing Bedrooms on 2nd floor and 1 Bedroom in Basement, totally <u>7</u> BRs. I explained due to the existing system being severely undersized, we need to perform a site evaluation on the syde system before we can approve BP for basement. If system is failing, owner will need to connect to public sewer per sec .18 of the Ho Co. Code. Property resides inside Metro District w/ pub - H₂O more to follow <u>EX-10</u>