

DEPARTMENT OF INSPECTIONS, LICENSES AND PERMITS 3430 COURTHOUSE DRIVE ELLICOTT CITY, MD 21043 PERMITS (410) 313-2455 INSPECTIONS (410) 313-1810 AUTOMATED INFORMATION (410) 313-3800		HOWARD COUNTY PERMIT APPLICATION		PERMIT NUMBER B 07004680	
Building Address <u>17125 Spring Hollow Ct.</u> <u>MOUNT AIRY APT. 21971</u>			Property Owner's Name <u>CHEN, TAN, JIAN LIAU</u>		
Suite/Apt. #: _____ SDP/WP/Petition #: _____			Address <u>17125 Spring Hollow Ct.</u>		
Census Tract _____ Subdivision _____			City <u>MOUNT AIRY</u> State <u>MD</u> Zip Code <u>21371</u>		
Section _____ Area _____ Lot _____			Home Phone _____ Work Phone <u>410-270-7400</u>		
Tax Map _____ Parcel _____ Grid _____			Applicant's Name & Mailing Address, (if other than stated hereon): <u>SCOTT ANTKOWIAK</u> <u>TECH. CO. ENGINEER</u> <u>410-270-7400</u> Fax <u>410-270-7400</u>		
Zoning _____ Map Coordinates _____ Lot size _____			Contractor Company <u>TECH. CO. ENGINEER</u>		
Existing Use <u>SFD</u>			Contact Person <u>SCOTT ANTKOWIAK</u>		
Proposed Use <u>SEE SUPPLEMENT</u>			Address <u>17125 Spring Hollow Ct.</u>		
Estimated Construction Cost \$ <u>2,000,000</u>			City <u>MOUNT AIRY</u> State <u>MD</u> Zip Code <u>21371</u>		
Description of Work <u>INSTALL OF ROOFING</u> <u>UNDER EXISTING ROOF</u>			License No. <u>410-270-7400</u>		
Occupant or Tenant _____			Phone _____ Fax _____		
Contact Name <u>NA</u>			Engineer or Architect Company _____		
Address _____			Contact Person _____		
City _____ State _____ Zip Code _____			Address <u>NA</u>		
Phone _____ Fax _____			City _____ State _____ Zip Code _____		
			Phone _____ Fax _____		

BUILDING DESCRIPTION - COMMERCIAL		BUILDING DESCRIPTION - RESIDENTIAL	
Building Characteristics	Utilities	Building Characteristics	Utilities
Height: _____	Water Supply: _____ Public _____ Private ☒	SF Dwelling ☒ SF Townhouse ☐ Depth _____ Width _____	Water Supply: _____ Public _____ Private ☒
No. of stories: _____	Sewage Disposal: _____ Public _____ Private ☒	1st floor: _____	Sewage Disposal: _____ Public _____ Private ☒
Gross area, sq. ft. per floor: _____	Electric Yes ☐ No ☐ Gas Yes ☐ No ☐	2nd floor: _____	Electric Yes ☐ No ☐ Gas Yes ☐ No ☐
Use group: _____	Heating System: _____ Electric ☐ Oil ☐ Natural Gas ☐ Propane Gas ☐	Basement: _____	Heating System: _____ Electric ☐ Oil ☐ Natural Gas ☐ Propane Gas ☐
Construction type: _____ Reinforced Concrete _____ Structural Steel _____ Masonry _____ Wood Frame _____	Sprinkler system: N/A ☐ Full _____ Partial _____ Other Suppression _____ # of Heads _____	Finished Basement ☐ Unfinished Basement ☐ Crawl space ☐ Slab on Grade ☐ No. of Bedrooms _____	Sprinkler system: N/A ☐ NFPA #13D _____ NFPA #13R _____ Other: _____
_____ State Certified Modular		Height: _____	
		Multi-family dwellings: _____	
		No. of efficiency units: _____	
		No. of 1 BR units: _____	
		No. of 2 BR units: _____	
		No. of 3 BR units: _____	
		Other Structure: _____	
		Dimensions: _____	
		Footings: _____	
		Roof Height: _____	
		_____ State Certified Modular	
		_____ Manufactured Home	

THE UNDERSIGNED HEREBY CERTIFIES AND AGREES AS FOLLOWS: (1) THAT HE/SHE IS AUTHORIZED TO MAKE THIS APPLICATION; (2) THAT THE INFORMATION IS CORRECT; (3) THAT HE/SHE WILL COMPLY WITH ALL REGULATIONS OF HOWARD COUNTY WHICH ARE APPLICABLE THERETO; (4) THAT HE/SHE WILL PERFORM NO WORK ON THE ABOVE REFERENCED PROPERTY NOT SPECIFICALLY DESCRIBED IN THIS APPLICATION; (5) THAT HE/SHE GRANTS COUNTY OFFICIALS THE RIGHT TO ENTER ON THIS PROPERTY FOR THE PURPOSE OF INSPECTING THE WORK PERMITTED AND POSTING NOTICES.

Applicant's Signature _____
Title/Company _____
Print Name _____
Date _____

Checks payable to: **DIRECTOR OF FINANCE OF HOWARD COUNTY**
** PLEASE WRITE NEATLY AND LEGIBLY. **
- FOR OFFICE USE ONLY.

AGENCY	DATE	SIGNATURE	APPROVAL	DPZ SETBACK INFORMATION	PROPERTY ID#
Land Development, DPZ				Front: _____	Filing fee \$ _____
State Highways				Rear: _____	Permit fee \$ <u>100.00</u>
Building Official				Side: _____	Excise tax \$ <u>10.00</u>
Dev. Engineering, DPZ				Side St.: _____	Add'l per. fee \$ _____
Health	<u>12/10/07</u>	<u>[Signature]</u>		All minimum setbacks met? YES ☐ NO ☐	TOTAL FEES \$ <u>110.00</u>
Fire Protection				Is Entrance Permit required? YES ☐ NO ☐	Sub-total paid \$ _____
Is Sediment Control approval required prior to issuance?				Historic District? YES ☐ NO ☐	Balance due \$ _____
YES ☐ NO ☐				Lot Coverage for New Town Zone _____	Check # <u>723</u>
CONTINGENCY CONSTRUCTION START: ☐				SDP/Red-line approval date _____	Validation # _____
ONE STOP SHOP: ☐					
Distribution of Copies: _____	White: Building Official	Green: LDD, DPZ		Accepted by <u>[Signature]</u>	
T: Forms/PERMIT.FRM				Yellow: DED, DPZ	Pink: Health
					Gold: SHA



HOWARD COUNTY PERMIT APPLICATION

PERMIT NUMBER

B0002634

Building Address 17125 SPRING HOLLOW CT
MT. AIRY 21771
Suite/Apt. #: _____ SDP/WP/Petition #: 6P00-39
Census Tract 6041 Subdivision SPRING HOLLOW
Section NA Area NA Lot 7
Tax Map 7 Parcel 141 Grd 8
Zoning RCPO Map Coordinates 2K9 Lot size 41,860sq

Property Owner's Name TRINITY BUILDERS
Address 7320 ECALL DR
City COLUMBIA State MD Zip Code 21044
Home Phone _____ Work Phone 410-313-8722
Applicant's Name & Mailing Address, (if other than stated hereon):

Phone _____ Fax 410-313-8731

Existing Use VACANT LOT
Proposed Use SFD
Estimated Construction Cost \$ 120,000
Description of Work CUSTOM ABNEY W/CHANGLES
3 STORY, FULL BSMT, 4 FB, 1 HB, FP
1 GARAGE (SBR) FINISHED BSMT W/BATH

Contractor Company SAMI
Contact Person _____
Address _____
City _____ State _____ Zip Code _____
License No. _____
Phone _____ Fax _____

Occupant or Tenant N/A
Contact Name _____
Address _____
City _____ State _____ Zip Code _____
Phone _____ Fax _____

Engineer or Architect Company SAMI
Contact Person _____
Address _____
City _____ State _____ Zip Code _____
Phone _____ Fax _____

BUILDING DESCRIPTION - COMMERCIAL

Building Characteristics	Utilities
Height: _____	Water Supply: _____ Public _____ Private _____
No. of stories: _____	Sewage Disposal: _____ Public _____ Private _____
Gross area, sq. ft. per floor: _____	Electric: Yes ☐ No ☐ Gas: Yes ☐ No ☐
Use group: _____	Heating System: _____ Electric ☐ Oil ☐ Natural Gas ☐ Propane Gas ☐
Construction type: _____ Reinforced Concrete _____ Structural Steel _____ Masonry _____ Wood Frame _____	Sprinkler system: <u>N/A</u> ☐ Full _____ Partial _____ Other Suppression _____ # of Heads _____
State Certified Modular _____	

BUILDING DESCRIPTION - RESIDENTIAL

Building Characteristics	Utilities
SF Dwelling ☒ SF Townhouse ☐ Depth _____ Width _____	Water Supply: _____ Public _____ Private ☒
1st floor: _____ 2nd floor: _____ Basement: _____	Sewage Disposal: _____ Public _____ Private ☒
Finished Basement ☒ Unfinished Basement ☐ Crawl space ☐ Slab on Grade ☐ No. of Bedrooms <u>5</u>	Electric: Yes ☒ No ☐ Gas: Yes ☐ No ☒
Multi-family dwellings: No. of efficiency units: _____ No. of 1 BR units: _____ No. of 2 BR units: _____ No. of 3 BR units: _____	Heating System: _____ Electric ☒ Oil ☐ Natural Gas ☐ Propane Gas ☐
Other Structure: _____ Dimensions: _____ Footings: _____ Roof: _____	Sprinkler system: <u>N/A</u> ☒ NFPA #13D _____ NFPA #13R _____ Other: _____
State Certified Modular _____ Manufactured Home _____	

THIS UNDERSIGNED HEREBY CERTIFIES AND AGREES AS FOLLOWS: (1) THAT HE/SHE IS AUTHORIZED TO MAKE THIS APPLICATION, (2) THAT THE INFORMATION IS CORRECT, (3) THAT HE/SHE WILL COMPLY WITH ALL REGULATIONS OF HOWARD COUNTY WHICH ARE APPLICABLE THEREIN, (4) THAT HE/SHE WILL PERFORM NO WORK ON THE ABOVE REFERENCED PROPERTY NOT SPECIFICALLY DESCRIBED IN THIS APPLICATION, (5) THAT HE/SHE GRANTS COUNTY OFFICIALS THE RIGHT TO ENTER ONTO THIS PROPERTY FOR THE PURPOSE OF INSPECTING THE WORK PERMITTED AND POSTING NOTICES.

Sally L. Hodge
Applicant's Signature
DPZ Operations
Title/Company

SALLY HODGE
Print Name
2/29/00
Date

Checks payable to: DIRECTOR OF FINANCE OF HOWARD COUNTY
** PLEASE WRITE NEATLY AND LEGIBLY **
FOR OFFICE USE ONLY


AGENCY	DATE	SIGNATURE APPROVAL
Land Development DPZ		
State Highways		
Building Official		
Dev. Engineering DPZ	<u>3/15/00</u>	<u>Mark E. Riffkin</u>
Health		
Fire Protection		
Is Sediment Control approval required prior to issuance?	YES ☐ NO ☐	

DPZ SETBACK INFORMATION
Front: _____
Rear: _____
Side: _____
Side St.: _____
All minimum setbacks met? YES ☐ NO ☐
Is Entrance Permit required? YES ☐ NO ☐
Historic District? YES ☐ NO ☐
Lot Coverage for New Town Zone _____
SDP/Red-line approval date _____ Accepted by D

PROPERTY ID# 45121
Filing fee \$ 25
Permit fee \$ _____
Excise tax \$ _____
Sub-total paid \$ _____
Add'l permit fee \$ _____
TOTAL FEES \$ _____
Balance due \$ _____
Check # 7103
Validation # 27965

CONTINGENCY CONSTRUCTION START: ☐
ONE STOP SHOP: ☐

Distribution of Copies: White: Building Official Green: LDD, DPZ Yellow: DED, DPZ Pink: Health Gold: SHA

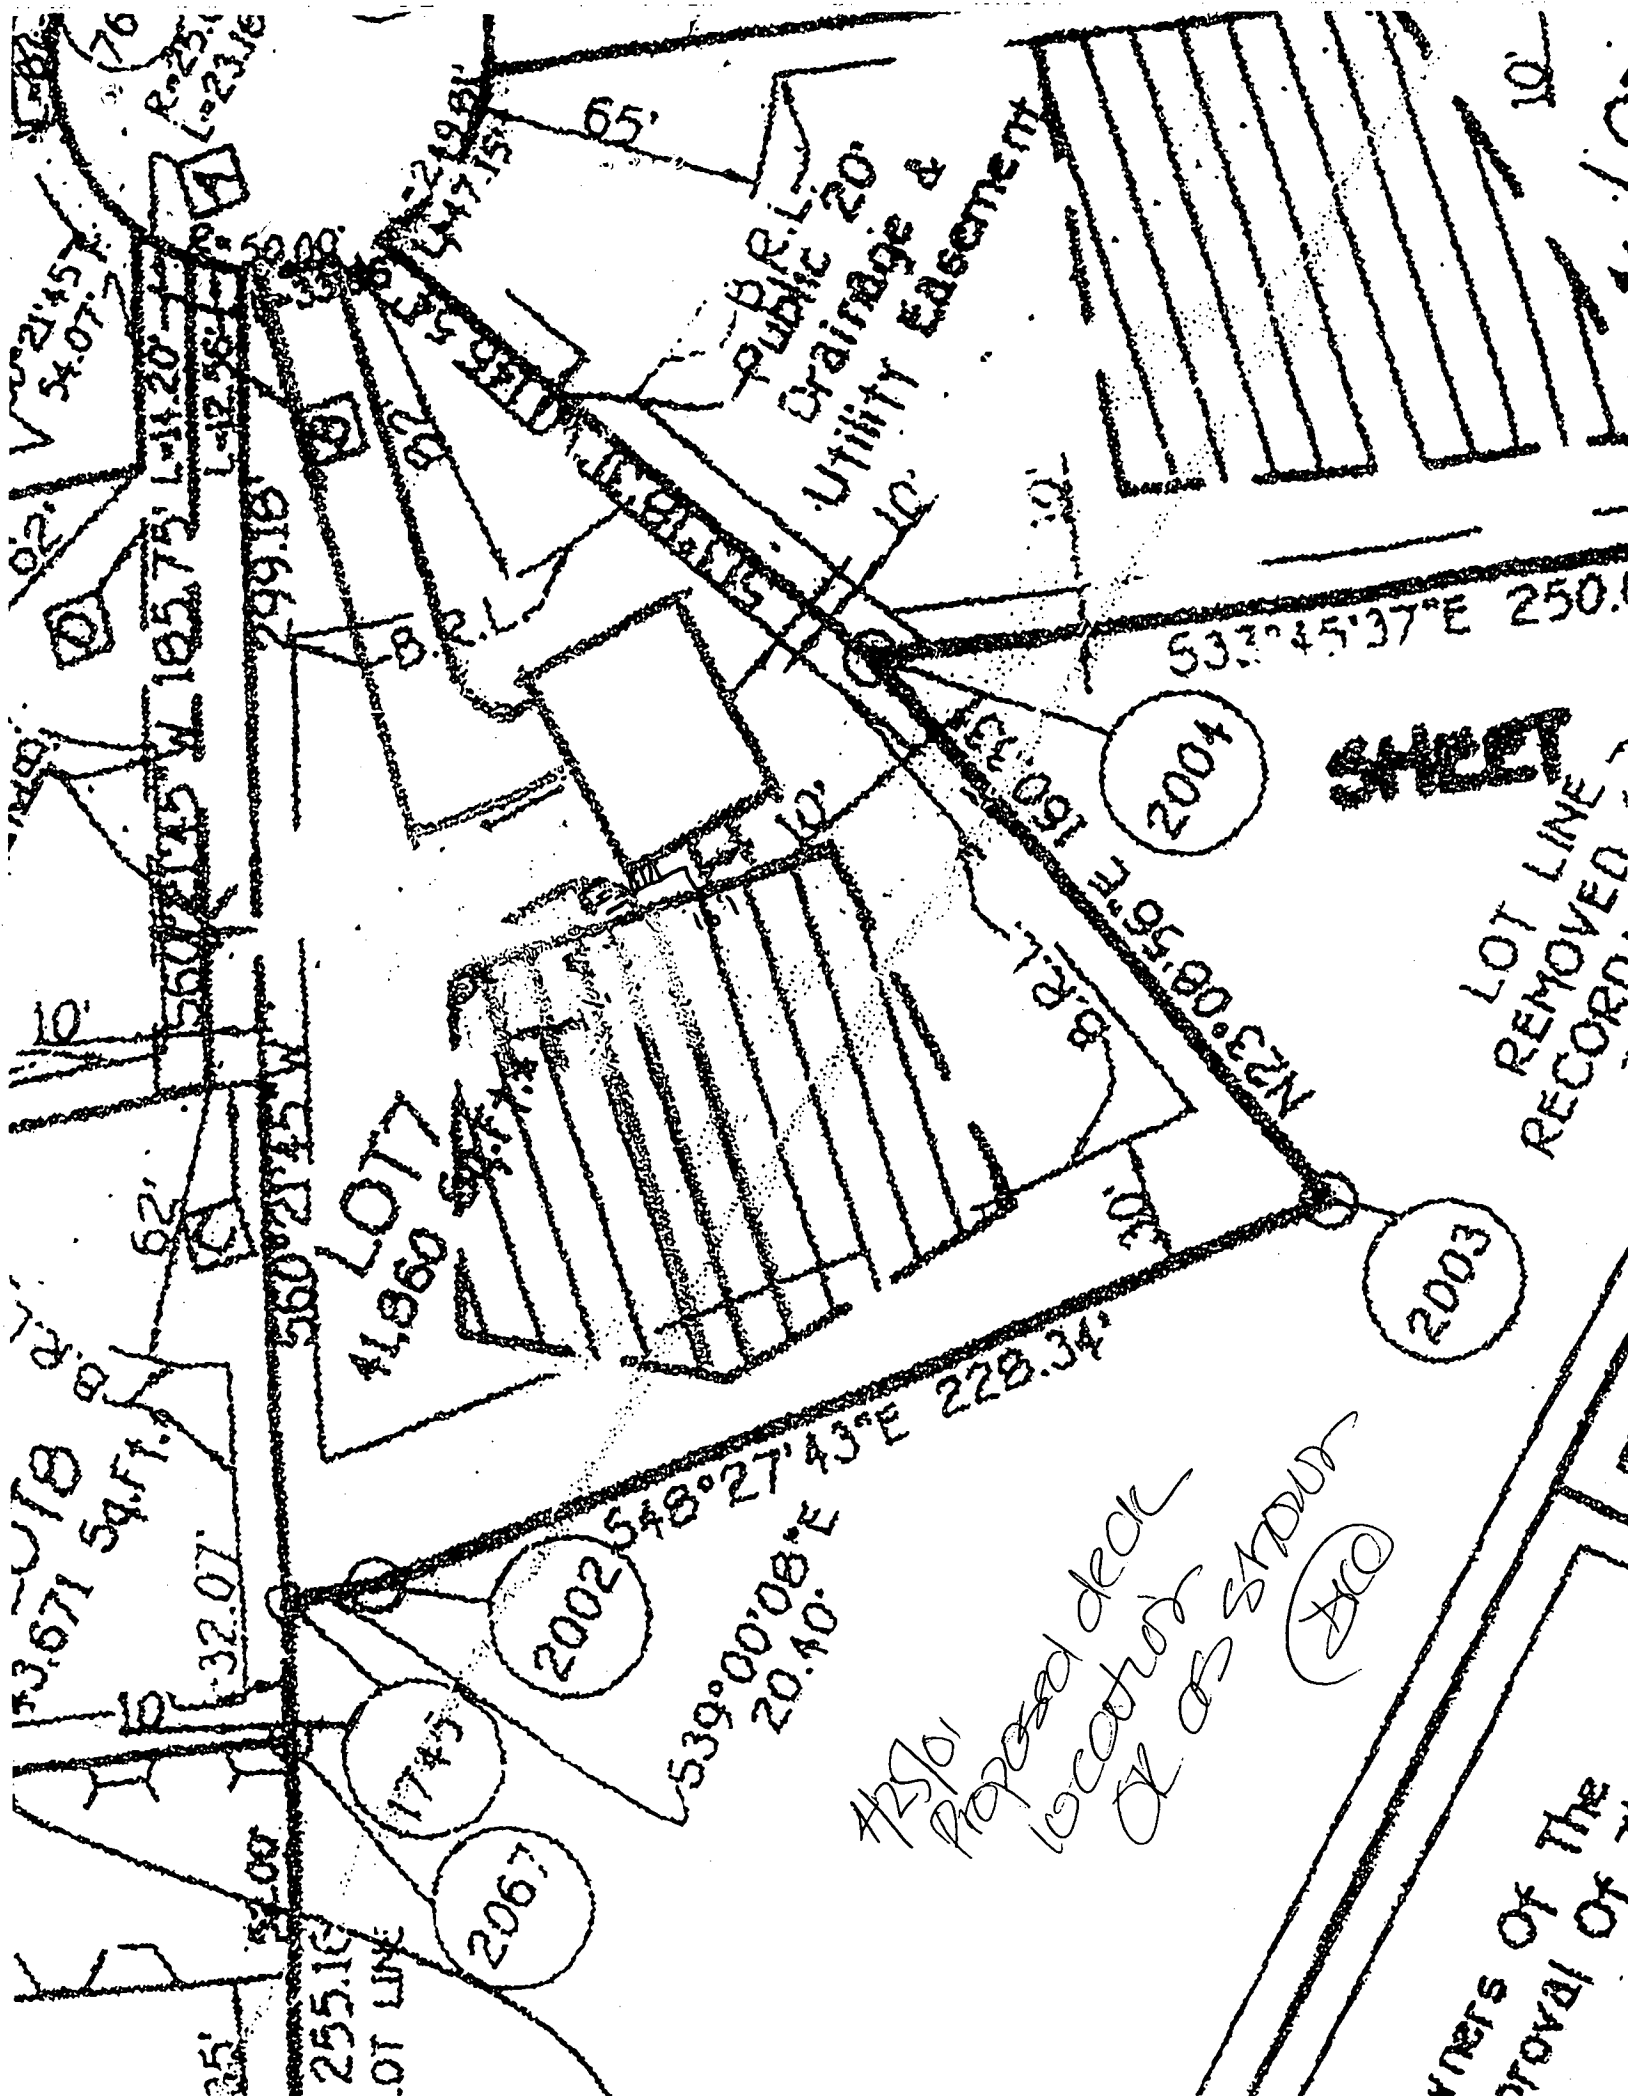

Building Address <u>17125 Spring Hollow Ct</u> <u>HL Ave MD 21771</u> Suite/Apt. #: _____ SDP/WP/Petition #: _____ Census Tract <u>140</u> Subdivision <u>11105</u> Section _____ Area _____ Lot <u>7</u> Tax Map <u>7</u> Parcel <u>144</u> Grid _____ Zoning <u>2000</u> Map Coordinates <u>2R9</u> Lot size _____	Property Owner's Name <u>John Law</u> Address <u>17125 Spring Hollow Ct</u> City <u>HL Ave</u> State <u>MD</u> Zip Code <u>21771</u> Home Phone <u>410-597-0291</u> Work Phone <u>NA</u> Applicant's Name & Mailing Address, (if other than stated hereon): _____ Phone _____ Fax _____
Existing Use <u>SD</u> Proposed Use <u>21000 sq ft</u> Estimated Construction Cost \$ <u>7500</u> Description of Work <u>Dock pole stairs</u> <u>6x10</u>	Contractor Company <u>RESIDENTIAL ADHS</u> Contact Person <u>Brent Johnson</u> Address <u>17116 Spring Hollow Ct</u> City <u>HL Ave</u> State <u>MD</u> Zip Code <u>21771</u> License No. <u>410-597-0291</u> Phone <u>410-597-0291</u> Fax _____
Occupant or Tenant <u>Owner</u> Contact Name _____ Address _____ City _____ State _____ Zip Code _____ Phone _____ Fax _____	Engineer or Architect Company <u>NA</u> Contact Person _____ Address _____ City _____ State _____ Zip Code _____ Phone _____ Fax _____

BUILDING DESCRIPTION - <u>COMMERCIAL</u>		BUILDING DESCRIPTION - <u>RESIDENTIAL</u>	
Building Characteristics Height: _____ No. of stories: _____ Gross area, sq. ft. per floor: _____ Use group: _____ Construction type: ☐ Reinforced Concrete ☐ Structural Steel ☐ Masonry ☐ Wood Frame ☐ State Certified Modular	Utilities Water Supply: ☐ Public ☐ Private Sewage Disposal: ☐ Public ☐ Private Electric Yes ☐ No ☐ Gas Yes ☐ No ☐ Heating System: Electric ☐ Oil ☐ Natural Gas ☐ Propane Gas ☐ Sprinkler system: N/A ☐ Full _____ Partial _____ Other Suppression _____ # of Heads _____	Building Characteristics SF Dwelling ☒ SF Townhouse ☐ Depth _____ Width _____ 1st floor: _____ 2nd floor: _____ Basement: _____ Finished Basement ☐ Unfinished Basement ☐ Crawl space ☐ Slab on Grade ☐ No. of Bedrooms _____ Multi-family dwellings: No. of efficiency units: _____ No. of 1 BR units: _____ No. of 2 BR units: _____ No. of 3 BR units: _____ Other Structure _____ Dimensions: _____ Footings: _____ Roof: _____ State Certified Modular _____ Manufactured Home _____	Utilities Water Supply: ☐ Public ☒ Private Sewage Disposal: ☐ Public ☒ Private Electric Yes ☐ No ☐ Gas Yes ☐ No ☐ Heating System: Electric ☒ Oil ☐ Natural Gas ☐ Propane Gas ☐ Sprinkler system: N/A ☒ NFPA #13D _____ NFPA #13R _____ Other: _____

THE UNDERSIGNED HEREBY CERTIFIES AND AGREES AS FOLLOWS: (1) THAT HE/SHE IS AUTHORIZED TO MAKE THIS APPLICATION, (2) THAT THE INFORMATION IS CORRECT, (3) THAT HE/SHE WILL COMPLY WITH ALL REGULATIONS OF HOWARD COUNTY WHICH ARE APPLICABLE TO THIS PROJECT, (4) THAT HE/SHE WILL PERFORM ANY WORK ON THE ABOVE REFERENCED PROPERTY NOT SPECIFICALLY DESCRIBED IN THIS APPLICATION, (5) THAT HE/SHE GRANTS COUNTY OFFICIALS THE RIGHT TO ENTER UPON THIS PROPERTY FOR THE PURPOSE OF INSPECTING THE WORK PERMITTED AND ISSUING NOTICES.

Applicant's Signature <u>Brent Johnson</u> Title/Company <u>RESIDENTIAL ADHS</u>	Print Name <u>Brent Johnson</u> Date <u>4-25-01</u>
--	---

Checks payable to: **DIRECTOR OF FINANCE OF HOWARD COUNTY**
**** PLEASE WRITE NEATLY AND LEGIBLY ****
FOR OFFICE USE ONLY

AGENCY	DATE	SIGNATURE APPROVAL	DPZ SETBACK INFORMATION	PROPERTY ID#
☒ Land Development, DPZ			Front: _____	45171
☒ State Highways			Rear: _____	Filing fee: \$ _____
☒ Building Official			Side: _____	Permit fee: \$ <u>90</u>
☒ Dev. Engineering, DPZ			Side St: _____	Excise tax: \$ _____
☒ Health			All minimum setbacks met? YES ☐ NO ☐	Add'l per. fee: \$ _____
☒ Fire Protection			Is Entrance Permit required? YES ☐ NO ☐	TOTAL FEES: \$ <u>90</u>
Is Sediment Control approval required prior to issuance? YES ☐ NO ☐			Historic District? YES ☐ NO ☐	Sub-total paid: \$ _____
CONTINGENCY CONSTRUCTION START: ☐			Lot Coverage for New Town Zone _____	Balance due: \$ _____
ONE STOP SHOP: ☐			SDP/Red-line approval date _____	Check # <u>3232</u>
Distribution of Copies: White: Building Official Green: LDD, DPZ Yellow: DED, DPZ Pink: Health Gold: SHA			Validation # <u>45171</u>	
T: forms PERMIT FRM			Accepted by <u>[Signature]</u>	

PRIVATE
& SEPTIC

PARCEL A

20.40'
N39°00'08"V

N48°27'43"W

228.34'

30' B.R.L.

160.33'

SEPTIC
RESERVE
AREA

129'


10' BRL

N60°21'45"E

TANK


10' BRL
S23°08'56"W

LOT 6
5/17/01
Pool O.K.
as shown

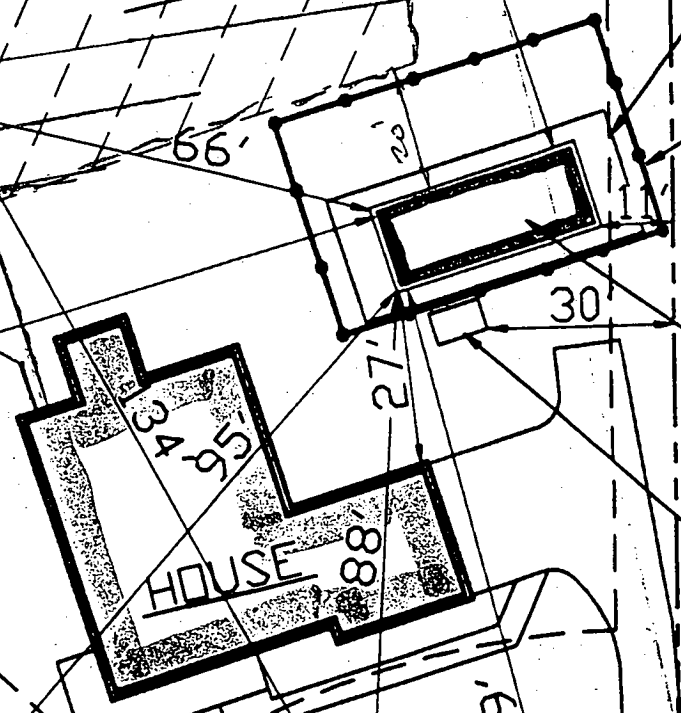

PUBLIC 20' WIDE DRAINAGE
& UTILITY ESMT.

LOT 7
0.96 AC. + Y

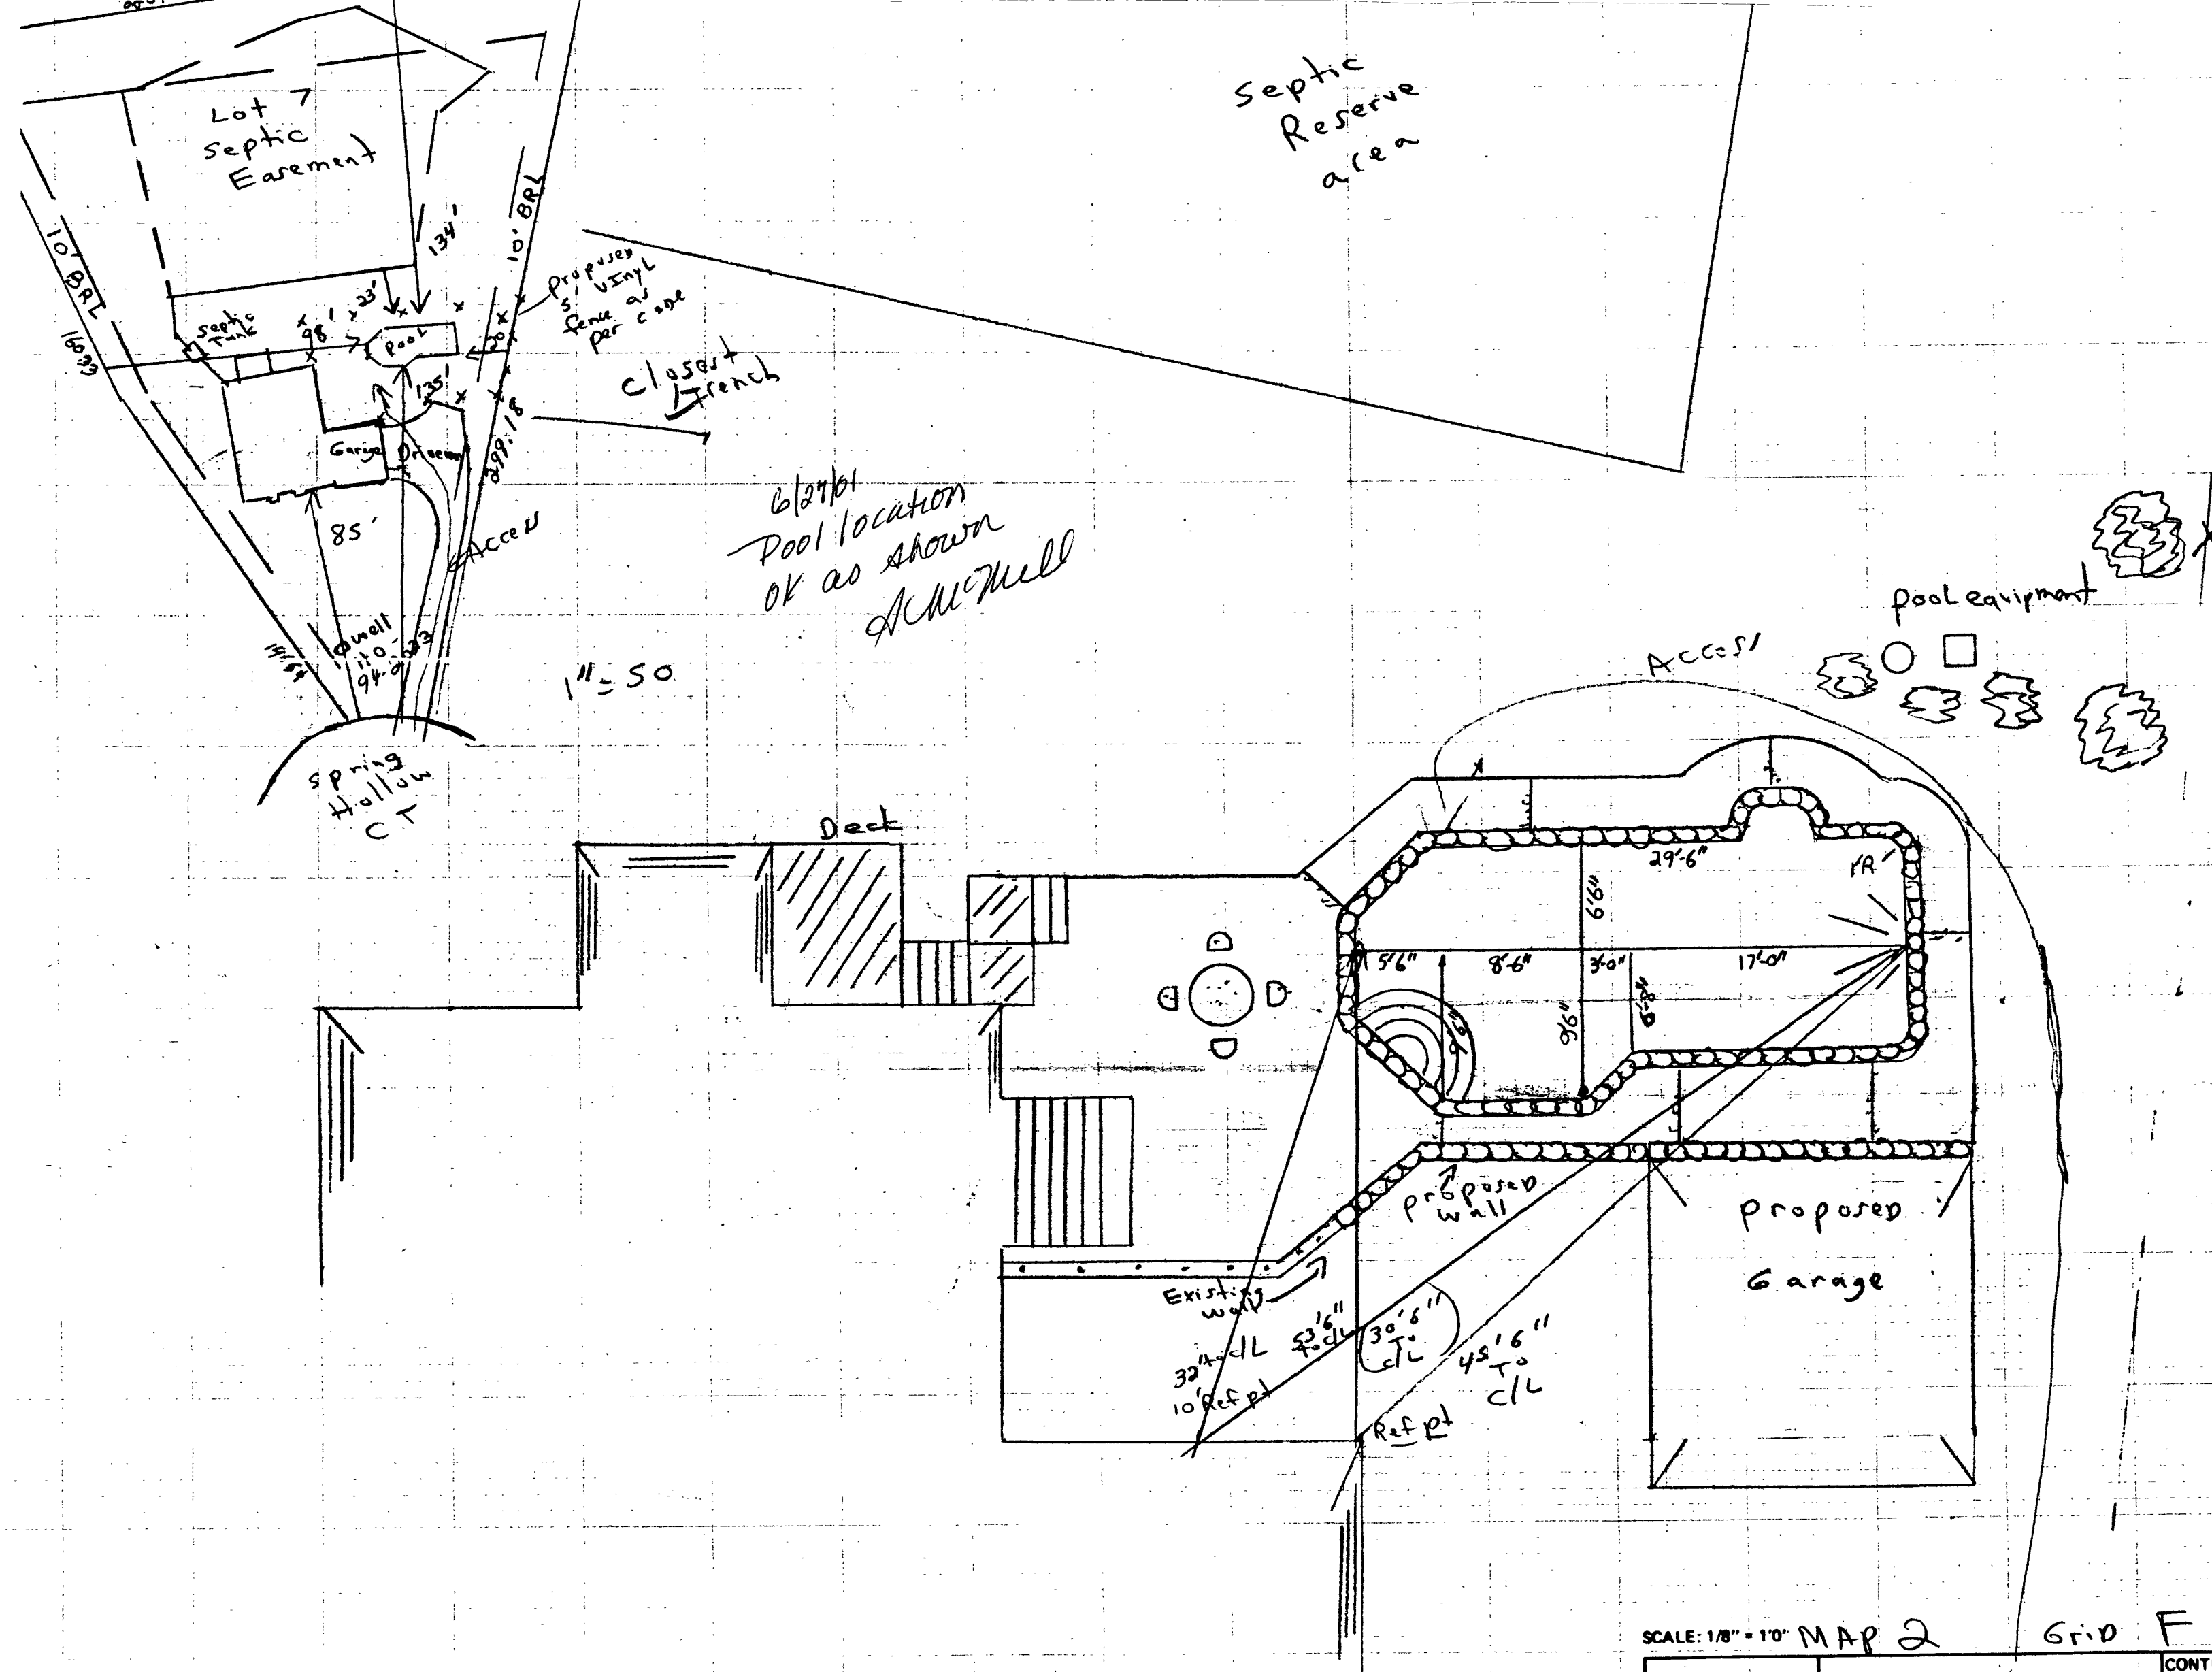

① RETURNS	_____	FENCE	4'
② AUTO. CLEANER	_____		
③ SPA RETURN	_____		
④ SPA BOTTOM DRAIN	_____		
⑤ AIR LINE	_____		
		CITY WATER	☐
		WELL WATER	☐
		SEWER	☐
		SEPTIC	☐

ANTHONY & SYLVAN

Where America Swims

NAME: Clay and Debbie Lay
SITE ADDRESS: 1725 Spring hollow ct
MAILING ADDRESS: Same
RES. PH. (410) 489 0281 OFF. PH. (410) 604-6
ACCT. NO. 01 030 MR. — MRS. —
MODEL: Barcelona DEPTH 3 TO 6
POOL SHAPE 16 LENGTH 34 PERIM. 96
POOL SQ. FT. 450 STEPS 4 CLASSIC SQ. F.
COZY CORNER SQ. FT. LOVE SEAT 4 X 2 = 8 SQ. F.
SPA SQ. FT. TOTAL WATER 458 SQ. F.
CAPACITY (GAL.) TURNOVER (HRS.)
COPING Flaestone TILE
INT. FINISH White plaster ROPE + FLOATS Yes
FILTER 60 B O F PUMP H.P.
SKIMMERS 2 RETURNS 2
BOTTOM DRAIN Dual LADDER No
LIGHT POOL OSAM WATTS LIGHT SPA — WATT
DIVING STAND BOARD LENGTH
VACUUM KIT Yes CLEANING KIT Yes
HEATER MODEL Heat pump BTU'S 113,000
SELF-CLEANER
INJECTORS SPA LOVE SEAT COZY CORNER
AIR BLOWER
SOLAR RECIRCULATING SYSTEM
TEMPORARY FENCE Yes FT.
EXT. 2ND STEP
WINTER COVER Safety mesh cover
Clear vinyl puncture Inl.
In Line Chlorinator Inl.

CABLE + UTILITY NO.
SITE CONDITIONS
GRADING: 1 HR Inl
DIRT HAUL — DIRT LEAVE ON 100
STUMPS: —
ELECTRIC BY: Anthony Sylvan FENCE BY: Owner
DECK BY: Anthony Sylvan WALL BY: —
GAS LINE BY: — VENTED BY: —

ADDITIONAL NOTES:
450' Bricken Concrete Inl
60 Linear feet of Drains Inl
2 2 water trucks Inl

CONST. OFF. Laurel PH. NO. 410 772
SALESMAN Anthony Sylvan MGR. —
SALES OFFICE Ellicott City PH. NO. 410 461-2
PERMIT OFFICE: Ellicott City COUNTY: Howard
PHONE NO. —

SPECIAL INSTRUCTIONS

CONTRACT DATE: 6-18
2001
OWN. BY: —
DATE: —
OK'D BY: —
DATE: —

SCALE: 1/8" = 10' MAP 2 Grid F 8

DIRECTIONS:	
1) RT 32 N	
2) I 70 west	
3) RT 94 South	
4) Right on RT. 144 west	
5) Left on Harry Rd	
6) Left on Spring Hollow CT	
7) Home is at end of Cul de sac	
BUYER: TO DETERMINE APPROXIMATE ELEVATION OF POOL ON DAY OF EXCAVATION.	
BUYER: TO WET DOWN CONCRETE SHELL AT LEAST TWICE DAILY FOR SEVEN DAYS	

APPROVED

WALK-THRU BUILDING PERMIT

BP# 00147998 A# 57610-G

APP. SAN KOB DATE: 5/6/04

DESC. OF WORK: Garage

