
WATER WELL ABANDONMENT-SEALING REPORT FORM

SUBMIT COPIES OF COMPLETED FORM TO:

- * COUNTY ENVIRONMENTAL AGENCY (contact MDE, WMA if address needed)
- * WELL OWNER
- * MDE, WATER MANAGEMENT ADMINISTRATION, WELL PROGRAM

Please Email
khattfield@khattfields
equipment.com

DATE WELL ABANDONED: 12/21/18 (month/day/year)

* PERMIT NUMBER OF ABANDONED WELL (if any) _____

* PERMIT NUMBER OF REPLACEMENT WELL: _____

* PERSON ABANDONING WELL: ROBERT CORSEY

WELL DRILLER'S LICENSE NUMBER: 161


CIRCLE: MWD / MSD / MGD

* OWNER'S NAME: GT FAMILY HOMES I LLC

* WELL LOCATION:

COUNTY: HOWARD
NEAREST TOWN: ELK RIDGE
TAX MAP 0038 BLOCK _____ PARCEL 0598
SUBDIVISION: 0900
SECTION: _____ LOT: _____
STREET ADDRESS: 5806 RACE RD

SITE LOCATION MAP

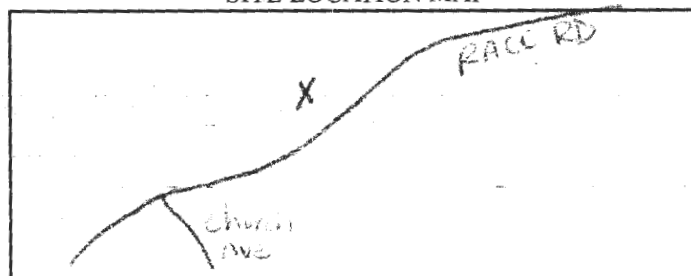

LATITUDE 39.210926

LONGITUDE 76.706830

LOG OF SEALING MATERIAL

MATERIAL	FEET	
	FROM	TO
Clean gravel	25	5
concrete	5	2
clean fill	2	0

* TYPE OF WELL BEING ABANDONED:

_____☐ DRILLED _____☐ JETTED
_____☐ BORED _____☒ HAND DUG
_____☐ OTHER (specify) _____

* USE CODE:

_____☒ DOMESTIC _____☐ MUNICIPAL/PUBLIC
_____☐ IRRIGATION _____☐ INDUSTRIAL
_____☐ TEST/OBSERVATION _____☐ GEOTHERMAL

VOLUME OF MATERIAL USED

* TYPE OF CASING:

_____☐ STEEL _____☐ PLASTIC
_____☐ CONCRETE _____☐ OTHER (specify) STONE

SIZE OF CASING: 36 INCHES IN DIAMETER

DEPTH OF WELL: 25 FEET DEEP

WAS ANY CASING REMOVED? YES ☒ NO ☐

If yes, length removed, in feet: _____

WAS CASING RIPPED OR PERFORATED? YES ☒ NO ☐

SIGNATURE-MASTER WELL DRILLER OR SUPERVISING SANITARIAN LICENSE#

MWD / MSD / MGS

CIRCLE ONE

DATE

OWNER

Pursuant to § 10-624 of the State Govt. Article of the Maryland Code, personal info requested on this form is used in processing this form pursuant to COMAR 26.04.04. Failure to provide the info may result in this form not being processed. You have the right to inspect, amend, or correct this form. The Maryland Department of the Environment is subject to the Maryland Public Information Act. This form may be made available on the Internet via MDE's website and is subject to inspection or copying, in whole or in part, by the public and other governmental agencies, if not protected by federal or State Law.

Oswald, Hank

From: Oswald, Hank
Sent: Monday, April 29, 2019 10:36 AM
To: Ken Hatfield
Cc: Wolf, Kevin
Subject: Well Abandonment Report_5806 Race Road

Hi Kenny:

I wanted to follow-up with you on the well abandonment report that you dropped off this morning. I thought you mentioned that it was connected to a demo permit but we don't have record of a demo request. Do you have a number for the owner, GT Family Homes. We would like to contact them.

Thanks,

Hank

Hank Oswald
Licensed Environmental Health Specialist
Howard County Health Department
Bureau of Environmental Health
Well & Septic Program
8930 Stanford Boulevard
Columbia, MD 21045
410.313.1786 (Office)
hoswald@howardcountymd.gov

CONFIDENTIALITY NOTICE

This message and the accompanying documents are intended only for the use of the individual or entity to which they are addressed and may contain information that is privileged, confidential, or exempt from disclosure under applicable law. If the reader of this email is not the intended recipient, you are hereby notified that you are strictly prohibited from reading, disseminating, distributing, or copying this communication. If you have received this email in error, please notify the sender immediately and destroy the original transmission.