

INDEXED PERMIT

SEWAGE DISPOSAL SYSTEM
HOWARD COUNTY HEALTH DEPARTMENT
BUREAU OF ENVIRONMENTAL HEALTH
410-313-2640

P 513554

A 57610-G

ISSUE DATE 4/21/2000

APPROVAL DATE 5/22/00

SK Backhoe & Septic Service

IS PERMITTED TO INSTALL ☒ ALTER ☐

ADDRESS 1220 FSK Highway, Keymar, MD 21757 PHONE 410-775-0562

SUBDIVISION Spring Hollow LOT NUMBER 7 ADDRESS 17125 Spring Hollow Court

PROPERTY OWNER CLAY LAU Trinity Builders PROPERTY OWNER'S ADDRESS 7320 Grace Drive

SEPTIC TANK CAPACITY 1500 GALLONS BUILDING PERMIT SIGNED Columbia, MD 21044

PUMP CHAMBER CAPACITY N/A GALLONS AND RETURNED

NUMBER OF BEDROOMS 5 5-604 B00147998-DETACHED GARAGE

SQUARE FEET PER BEDROOM 180

LINEAR FEET OF TRENCH REQUIRED 300

TRENCHES: Trenches to be 3 feet wide. Inlet 4 feet below original grade. Bottom maximum depth 6 feet below original grade. 2 feet of stone below distribution box.

LOCATION: From the bend in the left lot line, place the distribution box 25 feet down the left (160.33') lot line and 35 feet off this same lot line. Run trenches on contour to left side of lot. REQUIRED LAYOUT: 40', 60', 100', 100' right

OK/MR

PLANS APPROVED Mark Rifkin DATE 3-15-2000

PERMIT VOID AFTER 2 YEARS

NOTE: CONTRACTOR RESPONSIBLE FOR SCHEDULING A PRE-CONSTRUCTION INSPECTION FOR ALL INSTALLATIONS

NOTE: TOP OF SEPTIC TANKS ARE TO BE NO DEEPER THAN 3.0 FEET BELOW FINISH GRADE

NOTE: WATERTIGHT SEPTIC TANKS REQUIRED

NOTE: CLEANOUT REQUIRED EVERY 70 FEET OF SEWER LINE AND/OR AT 90° SWEEPS IN LINES FROM HOUSE TO DRAIN FIELDS, 90° ELBOWS ARE NOT ACCEPTABLE

NOTE: ALL PARTS OF SEPTIC SYSTEMS (I.E. TANK, DISTRIBUTION BOX, DRAINFIELDS) TO BE 100 FEET FROM ANY WATER WELL UNLESS OTHERWISE SPECIFICALLY AUTHORIZED

NOTE: NO ABSORPTION TRENCH TO EXCEED 100 FEET IN LENGTH UNLESS SPECIFICALLY AUTHORIZED

NOTE: ALL PIPE FROM HOUSE TO SEPTIC TANK MUST BE CAST IRON OR SCHEDULE 35/40 PVC OR ABS

NOTE: MANHOLE RISERS REQUIRED ON ALL SEPTIC TANKS AND PUMP CHAMBERS

NOTE: DISTRIBUTION BOXES MUST HAVE BAFFLES

NOTE: IF PUMPED SEPTIC SYSTEM REQUIRED, (1) SEPTIC PUMP DETAIL TO BE PROVIDED BY INSTALLER PRIOR TO ISSUANCE OF SEPTIC PERMIT (2) PUMP PERFORMANCE TEST IS NECESSARY PRIOR TO HEALTH DEPARTMENT APPROVAL OF SEPTIC PERMIT

NEITHER THE HOWARD COUNTY COUNCIL NOR THE HEALTH DEPARTMENT IS RESPONSIBLE FOR THE SUCCESSFUL OPERATION OF ANY SYSTEM
PERMITTEE RESPONSIBLE FOR OBTAINING FINAL APPROVAL ON THIS PERMIT
CALL 410-313-2640 FOR INSPECTION OF SEPTIC SYSTEM


BLDG. PERMIT SIGNED 800131154
AND RETURNED 6/27/01 pool

BLDG. PERMIT SIGNED
AND RETURNED 4/25/01

BLDG. PERMIT SIGNED 800129804 - deck
AND RETURNED 5/17/01 800130262 - pool

AS 7610 G

NOT TO SCALE

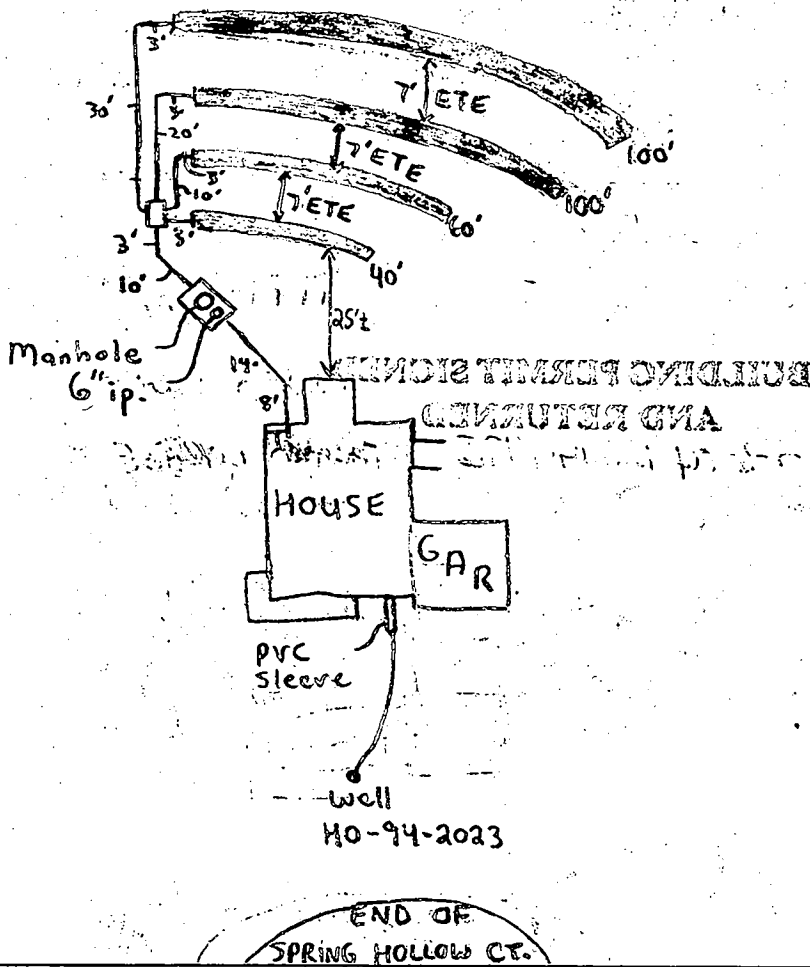

TRENCH DATA

TRENCH WIDTH 3'
TRENCH INLET DEPTH 4'
TRENCH BOTTOM DEPTH 6'
DEPTH OF STONE 2'
NUMBER OF TRENCHES 4
TOTAL TRENCH LENGTH 300
ABSORBENT AREA ft²
DISTRIBUTION BOX LEVEL ✓
BAFFLE IN DISTRIBUTION BOX ✓

SEPTIC TANK DATA

SEPTIC TANK 1500 T.S. GALLONS
MANHOLE RISER Yes on Tank
6 INCH INSPECTION PORT Yes on Tank

PUMP CHAMBER DATA

PUMP CHAMBER GALLONS N/A
MANHOLE RISER N/A
ALARM N/A
PUMP PERFORMANCE TEST N/A


PRE-CONSTRUCTION INSPECTION: _____

INSPECTION COMMENTS: 5/19/00-OK TO COVER FROM HOUSE TO TANK, TANK DBOX & 1ST 3 TRENCHES, RAINING FAIRLY HARD DURING SOME OF INSTALLATION. INSTRUCTED INSTALLER TO TRY TO KEEP STONE CLEAN WHEN PLACING IT IN TRENCHES, LAST TRENCH TO BE COMPLETED AT LATER DATE (SRK)
5/22/00-LAST TRENCH COMPLETE, OK TO COVER ALL WORK (SRK)

5/19/00-WPI OK (SRK)

INSPECTOR Steven R. Kries DATE SYSTEM APPROVED 5/22/00

SPRING HOLLOW COURT

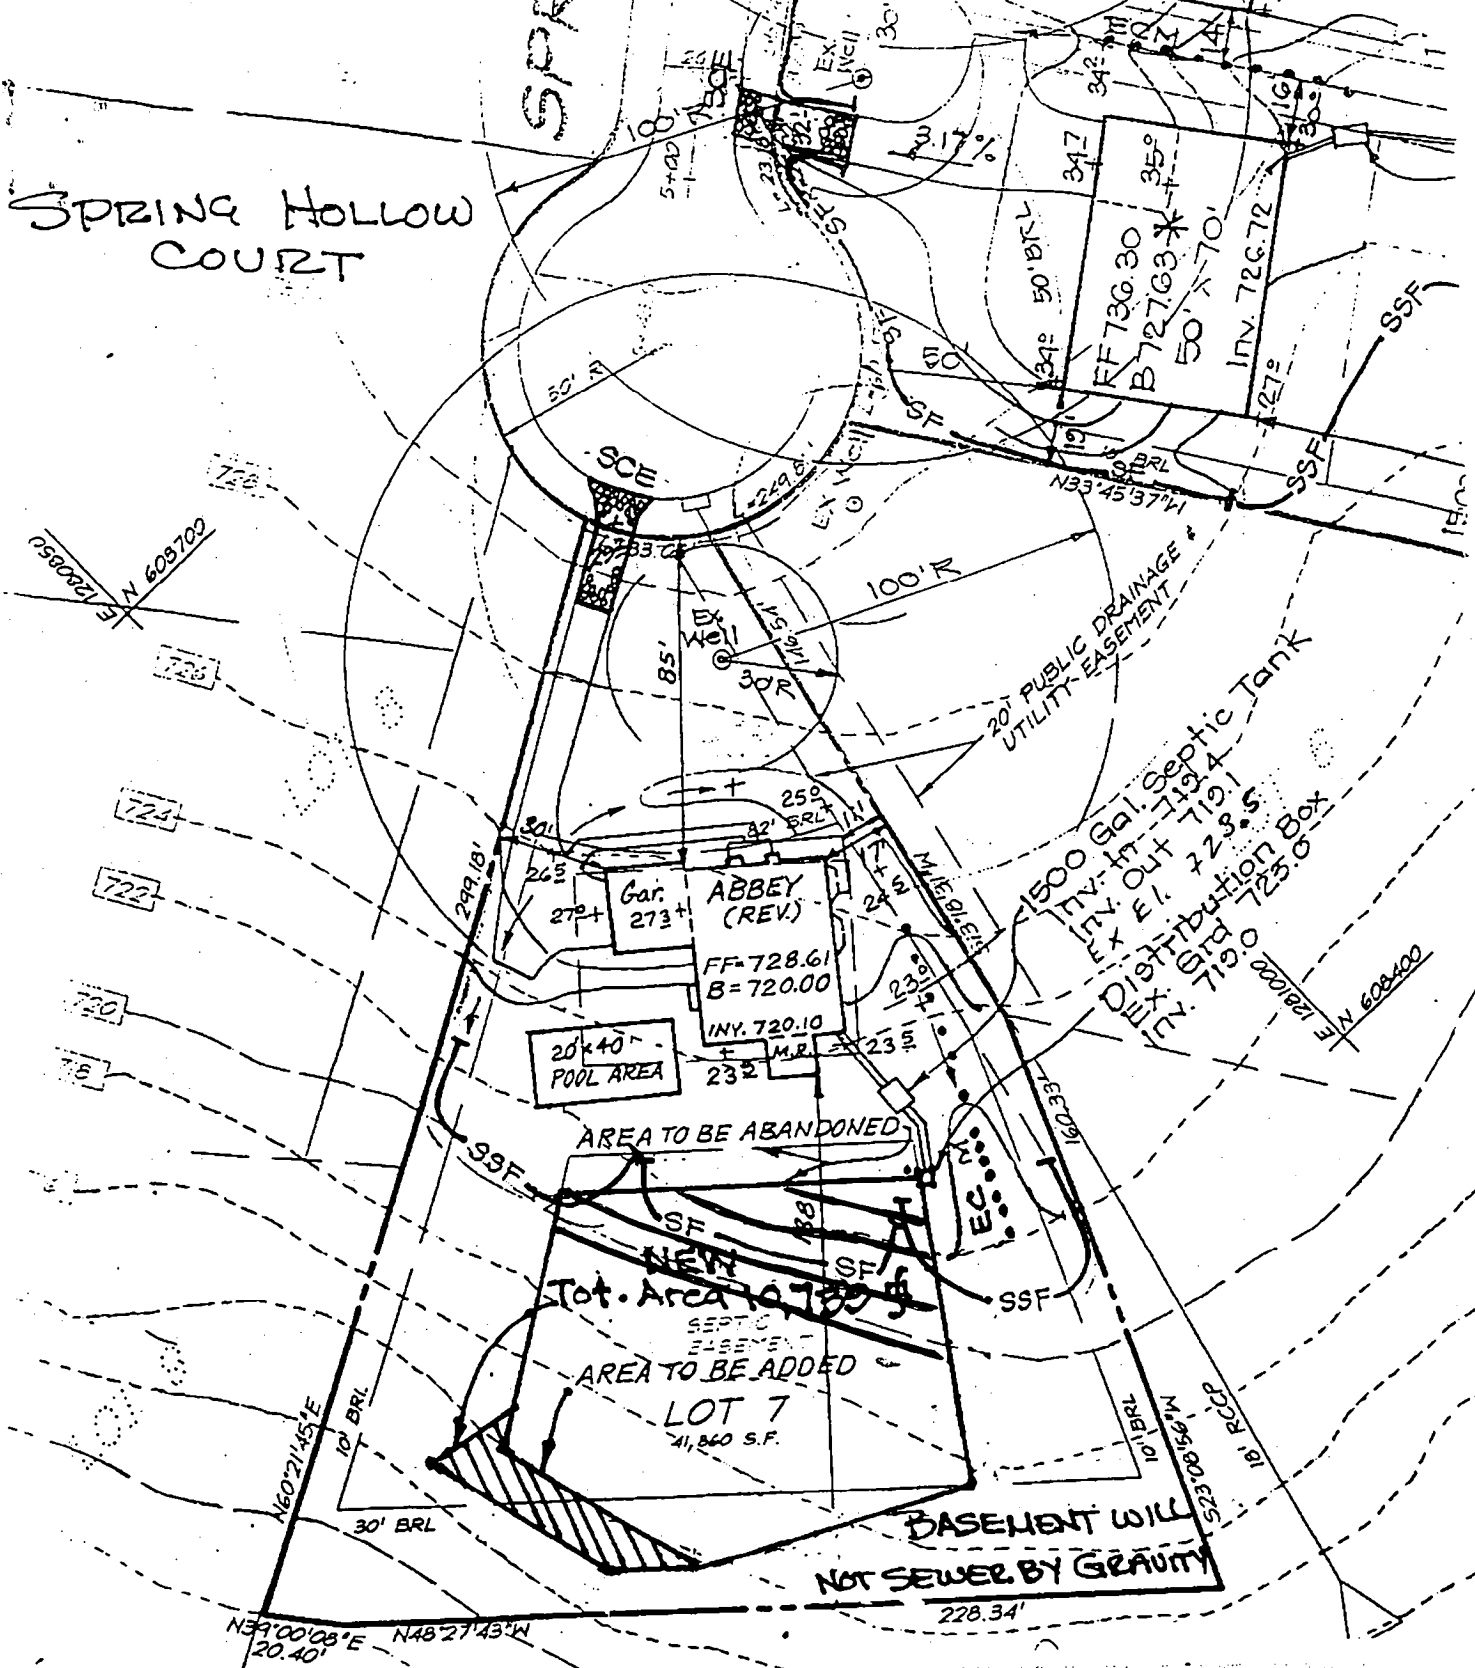

Approved Septic System Plan
Howard County Health Department

Total linear feet of trench
required 300 feet

3 SYSTEMS FIT IN AREA
HEALTH DEPT. ACCEPTS THIS
MODIFICATION TO THE PLATTED

Width of trench(es) 3 feet

Depth of trench(es) 6 feet

Signature Mark E. Riffin
Date 3/15/00

SEWAGE EASEMENT
Depth of stone required below
distribution pipe 2 feet

