

SITE INSPECTION SHEET

OWNER: MORGAN, DAVID J PHONE #: _____

ADDRESS: 8601 Reservoir Road CONTRACTOR: CARROLL WATER


FULTON MD 20759 WELL TAG #: _____

SUBDIVISION: MUNRO PROP LOT: 4 COUNTY #: (XIII)

PROPOSAL: RELOCATE WELL LINE $\geq$ 5' FROM PROP

GARAGE FOOTER. B20003186

(W) LOCATION DIAGRAM

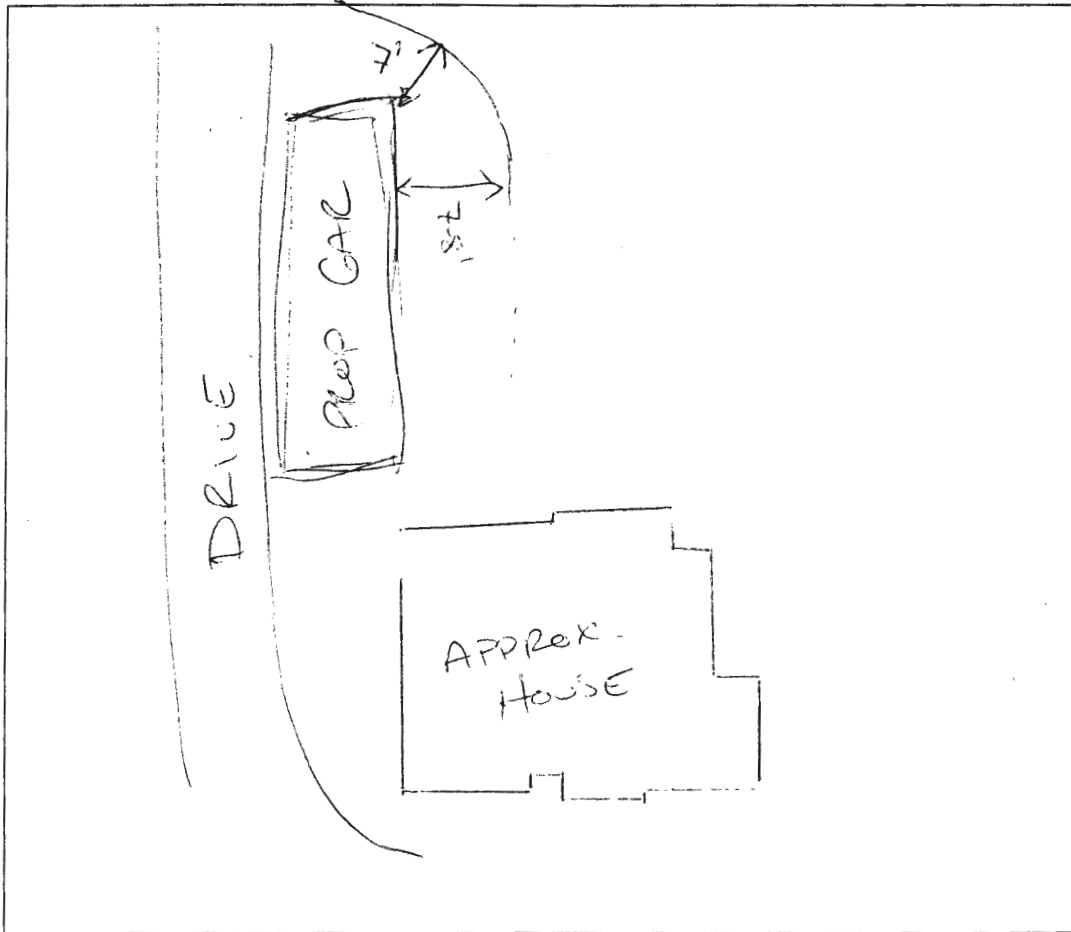

COMMENTS: RECOMMEND STOCKING WELL

TRENCH MEASURED 36" DEEP MEETING FROST
DEPTH.

DATE: 11/12/2020 INSPECTOR: CARROLL CC1997