

**COMPLETE THIS FORM WHEN DROPPING OFF ANY  
CORRESPONDENCE AND/OR PLANS TO THE HOWARD COUNTY  
DEPARTMENT OF INSPECTIONS, LICENSES AND PERMITS COUNTER:**

Date: December 2, 2021

To: Dana Bernard Health Department  
(Reviewer/Requestor's Name) (Division)

From: Kenneth Roethel 443-226-2788  
(Your Name, Company Name) (Phone Number)

Subject: Project name \_\_\_\_\_  
Project site address 2525 Sand Hill Rd, Ellicott City, MD 21042  
Permit # B20004285 SDP # \_\_\_\_\_  
Other information pertinent to this project \_\_\_\_\_

☒ Please check the attachments below that you are submitting with this transmittal:

- ☐ Letter of response to address plan review comment letter
- ☒ Revised plans and/or revised details: When submitting for a complete re-review, **duplicate sets shall be submitted.**
- ☐ Letter Summarizing Changes
- ☐ Energy conservation calculations
- ☐ Copies of \_\_\_\_\_ (be specific).  
☐ Health Department Request ☐ DPZ/ DED Request ☐ Applicant's Request
- ☐ Two sets of single-family model plans to be placed on permanent file: Model Name/ # \_\_\_\_\_
- ☐ Other \_\_\_\_\_

**Contact Person Information: (Required)**

Kenneth Roethel 443-226-2788  
Please Print Name Telephone No:  
E-Mail Address: kroethel@hotmail.com

**PLEASE ASSURE ALL DOCUMENTS AND/OR REVISIONS ARE APPROPRIATELY SIGNED AND SEALED, IF NECESSARY, BY A LICENSED ARCHITECT OR ENGINEER. PLEASE BE ADVISED THAT INSUFFICIENT INFORMATION MAY RESULT IN THE DELAY OF REVIEW BY THE PLANS EXAMINER. THE DEPARTMENT OF INSPECTIONS, LICENSES AND PERMITS WILL CONTACT YOU IF THERE IS A PROBLEM. IN ADDITION, ONCE THE BUILDING PERMIT IS APPROVED BY THE PLAN REVIEW DIVISION AND ALL OTHER REQUIRED SIGNATORY AGENCIES, AND THE BUILDING PERMIT IS READY FOR ISSUANCE, THE PERMIT DIVISION WILL NOTIFY THE APPROPRIATE CONTACT PERSON FOR PERMIT PICK UP. ALL PERMIT STATUS INQUIRIES SHALL BE DIRECTED TO THE PERMIT DIVISION AT 410-313-2455 OPTION #4 OR BY VISITING [MYHOWARD.INFO](http://MYHOWARD.INFO). CODE RELATED QUESTIONS AND PLAN REVIEW INQUIRIES SHALL BE DIRECTED TO THE PLAN REVIEW DIVISION AT 410-313-2436. PLEASE ALLOW A MINIMUM OF FIVE (5) WORKING DAYS FOR ANY PLAN SUBMITTALS TO BE REVIEWED. THANK YOU.**

Received by \_\_\_\_\_

**COMPLETE THIS FORM WHEN DROPPING OFF ANY  
CORRESPONDENCE AND/OR PLANS TO THE HOWARD COUNTY  
DEPARTMENT OF INSPECTIONS, LICENSES AND PERMITS COUNTER:**

Date: December 2, 2021

To: Dana Bernard Health Department  
(Reviewer/Requestor's Name) (Division)

From: Kenneth Roethel 443-226-2788  
(Your Name, Company Name) (Phone Number)

Subject: Project name \_\_\_\_\_  
Project site address 2525 Sand Hill Rd, Ellicott City, MD 21042  
Permit # B20004285 SDP # \_\_\_\_\_  
Other information pertinent to this project \_\_\_\_\_

✓ Please check the attachments below that you are submitting with this transmittal:


- ☐ Letter of response to address plan review comment letter
- ☒ Revised plans and/or revised details: When submitting for a complete re-review, **duplicate sets shall be submitted.**
- ☐ Letter Summarizing Changes
- ☐ Energy conservation calculations
- ☐ Copies of \_\_\_\_\_ (be specific).  
☐ Health Department Request ☐ DPZ/ DED Request ☐ Applicant's Request
- ☐ Two sets of single-family model plans to be placed on permanent file: Model Name/ # \_\_\_\_\_
- ☐ Other \_\_\_\_\_

**Contact Person Information: (Required)**

Kenneth Roethel 443-226-2788  
Please Print Name Telephone No:  
E-Mail Address: kroethel@hotmail.com

**PLEASE ASSURE ALL DOCUMENTS AND/OR REVISIONS ARE APPROPRIATELY SIGNED AND SEALED, IF NECESSARY, BY A LICENSED ARCHITECT OR ENGINEER. PLEASE BE ADVISED THAT INSUFFICIENT INFORMATION MAY RESULT IN THE DELAY OF REVIEW BY THE PLANS EXAMINER. THE DEPARTMENT OF INSPECTIONS, LICENSES AND PERMITS WILL CONTACT YOU IF THERE IS A PROBLEM. IN ADDITION, ONCE THE BUILDING PERMIT IS APPROVED BY THE PLAN REVIEW DIVISION AND ALL OTHER REQUIRED SIGNATORY AGENCIES, AND THE BUILDING PERMIT IS READY FOR ISSUANCE, THE PERMIT DIVISION WILL NOTIFY THE APPROPRIATE CONTACT PERSON FOR PERMIT PICK UP. ALL PERMIT STATUS INQUIRIES SHALL BE DIRECTED TO THE PERMIT DIVISION AT 410-313-2455 OPTION #4 OR BY VISITING MYHOWARD.INFO. CODE RELATED QUESTIONS AND PLAN REVIEW INQUIRIES SHALL BE DIRECTED TO THE PLAN REVIEW DIVISION AT 410-313-2436. PLEASE ALLOW A MINIMUM OF FIVE (5) WORKING DAYS FOR ANY PLAN SUBMITTALS TO BE REVIEWED. THANK YOU.**

Received by \_\_\_\_\_

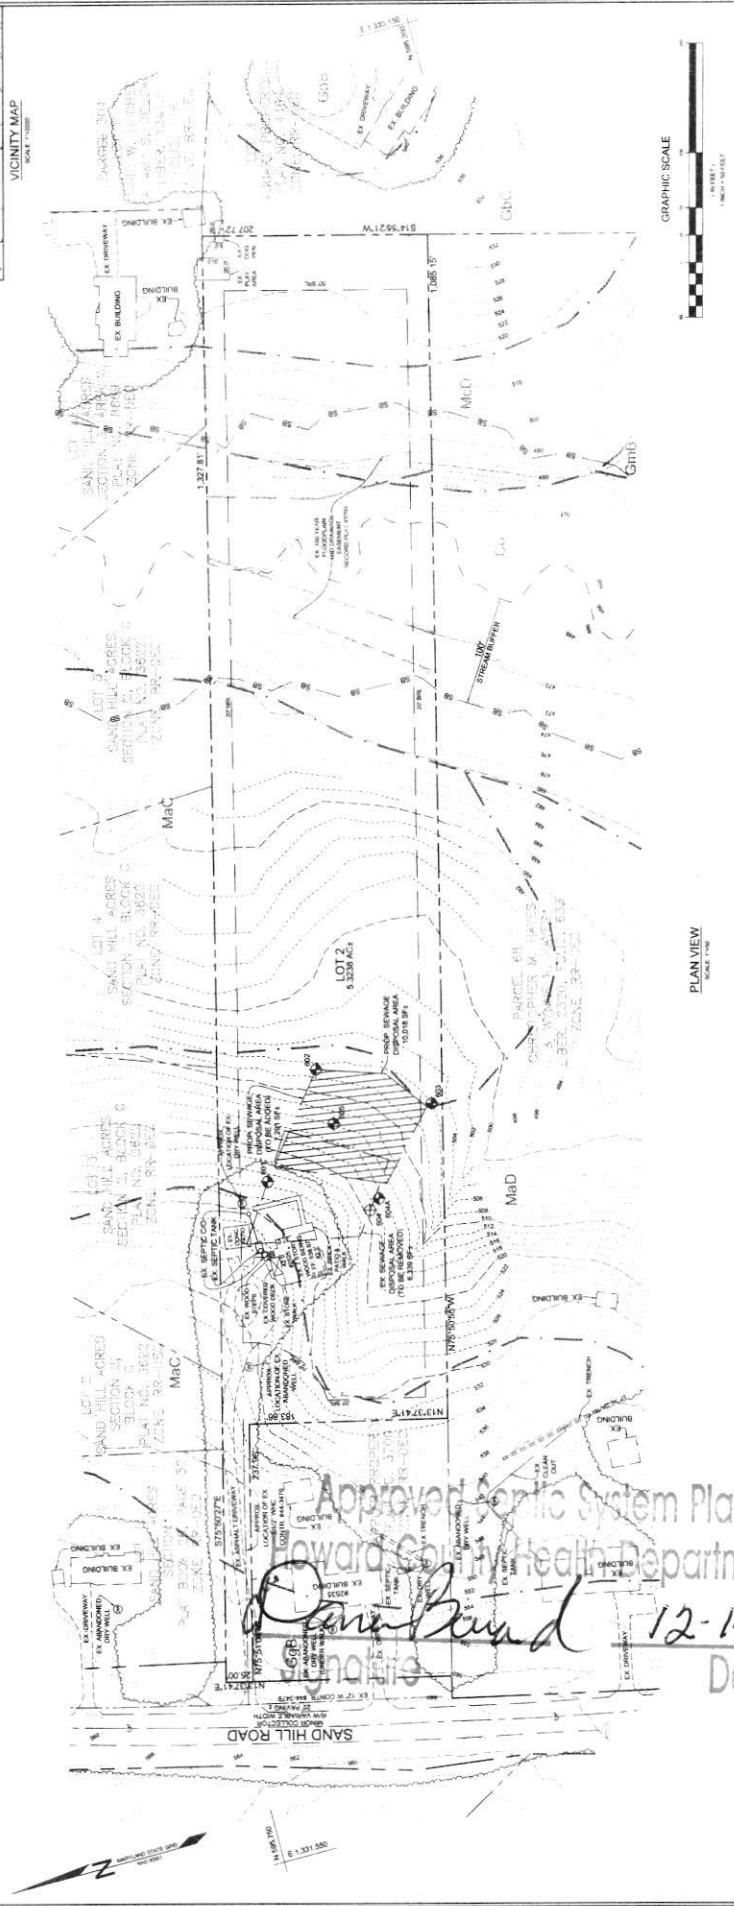[illegible][illegible]


PERCOLATION CERTIFICATION PLAN ROETHEL PROPERTY 2525 SAND HILL RD SAN MATEO COUNTY DISTRICT	146 SAN MATEO COUNTY DISTRICT 	BILL ENGINEERING GROUP, LLC 1460 S. 10th Street, Suite 200 San Mateo, CA 94401 Phone: 650.375.3500 Fax: 650.375.3501 E-mail: bill@billengr.com	146 SAN MATEO COUNTY DISTRICT
			146 SAN MATEO COUNTY DISTRICT

**OWNER/DEVELOPER**  
KENNETH ROETHL  
2929 SAND HILL RD  
ELLMORE CITY MD 21622-1241

APPROVED: [Signature] DATE: 6/1/71  
COUNTY CLERK: [Signature]  
JAMES C. HARRIS, JR., CLERK OF COURT  
COUNTY CLERK: [Signature] DATE: 6/1/71  
JAMES C. HARRIS, JR., CLERK OF COURT



Property Boundaries  
with newly approved  
sewage disposal area.  
House location and  
proposed deck shown  
in inset.

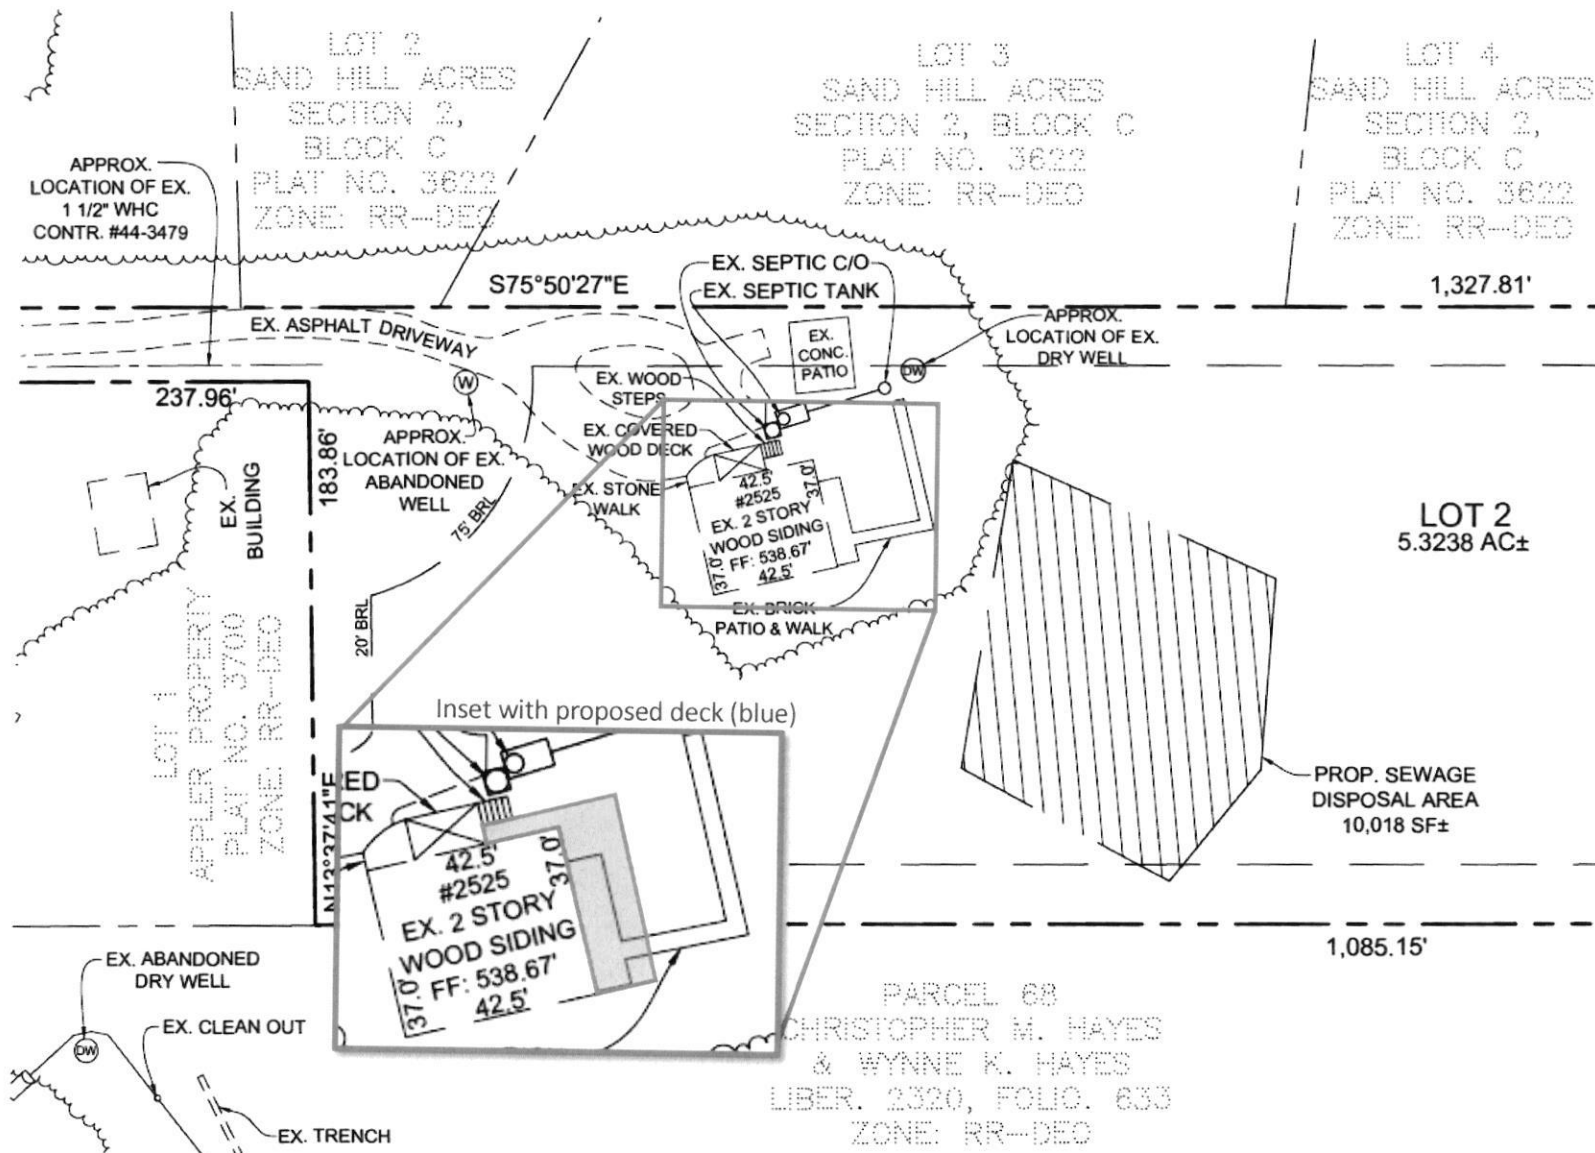

Property Boundaries  
with newly approved  
sewage disposal area.  
House location and  
proposed deck shown  
in inset.

