

DEPARTMENT OF INSPECTIONS, LICENSES AND PERMITS
3430 COURT HOUSE DRIVE
ELLICOTT CITY, MD 21043
PERMITS (410) 313-2455 INSPECTIONS (410) 313-1810
AUTOMATED INFORMATION (410) 313-3800

HOWARD COUNTY
PERMIT APPLICATION

PERMIT NUMBER
B00158467

Building Address: 10115 Starsfield Rd, 20723
Property Owner's Name: David Foston
Address: 10115 Starsfield Rd
City: Laurel, State: MD, Zip Code: 20723
Home Phone: 240-568-0998, Work Phone: 301-309-0556
Applicant's Name & Mailing Address, (if other than stated hereon):
Phone: 240-568-0998
Contractor Company: Shows Home Emp
Contact Person: John Shaw
Address: 3901 Baltimore St
City: Savage, State: MD, Zip Code: 20723
License No.: 40991
Phone: 301-490-5145 Fax:
Engineer or Architect Company:
Contact Person: N/A
Address:
City: State: Zip Code:
Phone: Fax:

BUILDING DESCRIPTION - COMMERCIAL
Building Characteristics
Height:
No. of stories:
Gross area, sq. ft. per floor:
Use group:
Construction type:
Reinforced Concrete
Structural Steel
Masonry
Wood Frame
State Certified Modular

Utilities
Water Supply:
Public
Private
Sewage Disposal:
Public
Private
Electric Yes No
Gas Yes No
Heating System:
Electric Oil
Natural Gas
Propane Gas
Sprinkler system: N/A
Full
Partial
Other Suppression
of Heads

BUILDING DESCRIPTION - RESIDENTIAL
Building Characteristics
SF Dwelling SF Townhouse
Depth Width
1st floor:
2nd floor:
Basement:
Finished Basement Unfinished Basement
Crawl space Slab on Grade
No. of Bedrooms
Height:
Multi-family dwellings:
No. of efficiency units:
No. of 1 BR units:
No. of 2 BR units:
No. of 3 BR units:
Other Structure:
Dimensions:
Footings:
Roof Height:
State Certified Modular
Manufactured Home

Utilities
Water Supply:
Public
Private
Sewage Disposal:
Public
Private
Electric Yes No
Gas Yes No
Heating System:
Electric Oil
Natural Gas
Propane Gas
Sprinkler system: N/A
NFPA #13D
NFPA #13R
Other:

THE UNDERSIGNED HEREBY CERTIFIES AND AGREES AS FOLLOWS: (1) THAT HE/SHE IS AUTHORIZED TO MAKE THIS APPLICATION; (2) THAT THE INFORMATION IS CORRECT; (3) THAT HE/SHE WILL COMPLY WITH ALL REGULATIONS OF HOWARD COUNTY WHICH ARE APPLICABLE THERETO; (4) THAT HE/SHE WILL PERFORM NO WORK ON THE ABOVE REFERENCED PROPERTY NOT SPECIFICALLY DESCRIBED IN THIS APPLICATION; (5) THAT HE/SHE GRANTS COUNTY OFFICIALS THE RIGHT TO ENTER ONTO THIS PROPERTY FOR THE PURPOSE OF INSPECTING THE WORK PERMITTED AND POSTING NOTICES.

Applicant's Signature: [Signature]
Title/Company: G/S W
Print Name: John F. Shaw
Date: 3/9/06
Checks payable to: DIRECTOR OF FINANCE OF HOWARD COUNTY
** PLEASE WRITE NEATLY AND LEGIBLY. **
- FOR OFFICE USE ONLY -


AGENCY DATE SIGNATURE APPROVAL
Land Development, DPZ 3/9/06 [Signature]
State Highways 3/9/06 [Signature]
Building Official 3/9/06 [Signature]
Dev. Engineering, DPZ 3/9/06 [Signature]
Health 3/9/06 [Signature]
Fire Protection
Is Sediment Control approval required prior to issuance? YES NO
CONTINGENCY CONSTRUCTION START: ONE STOP SHOP:
DPZ SETBACK INFORMATION
Front: 20'
Rear: 30'
Side: 7.5'
Side St: N/A
All minimum setbacks met? YES NO
Is Entrance Permit required? YES NO
Historic District? YES NO
Lot Coverage for NewTown Zone: N/A
SDP/Red-line approval date:
Filing fee \$ 25
Permit fee \$ 84
Excise tax \$ 374
Add'l per. fee \$ 9
TOTAL FEES \$ 482
Sub-total paid \$
Balance due \$ 974
Check # 2225
Validation # 107228
Accepted by: [Signature]

Plat is of benefit to a consumer only insofar as it is required by a lender or a title insurance company or its agent in connection with contemplated transfer, financing or re-financing. The plat is not to be relied upon for the establishment or location of fences, garages, buildings, or other existing or future improvements. The plat does not provide for the accurate identification of property boundary lines, but such identification may not be required for the transfer of title or securing financing or re-financing.

NOTE: The lot shown hereon does not lie within the limits of the 100 year flood plain as shown on FIRM Panel No. 43
Date of Map: 12-9-96
Flood Zone: "C"

NOTE: No property corners found or set unless otherwise noted.

NOTE: The accuracy of this survey and the apparent setback distances is 2 Ft. +/-

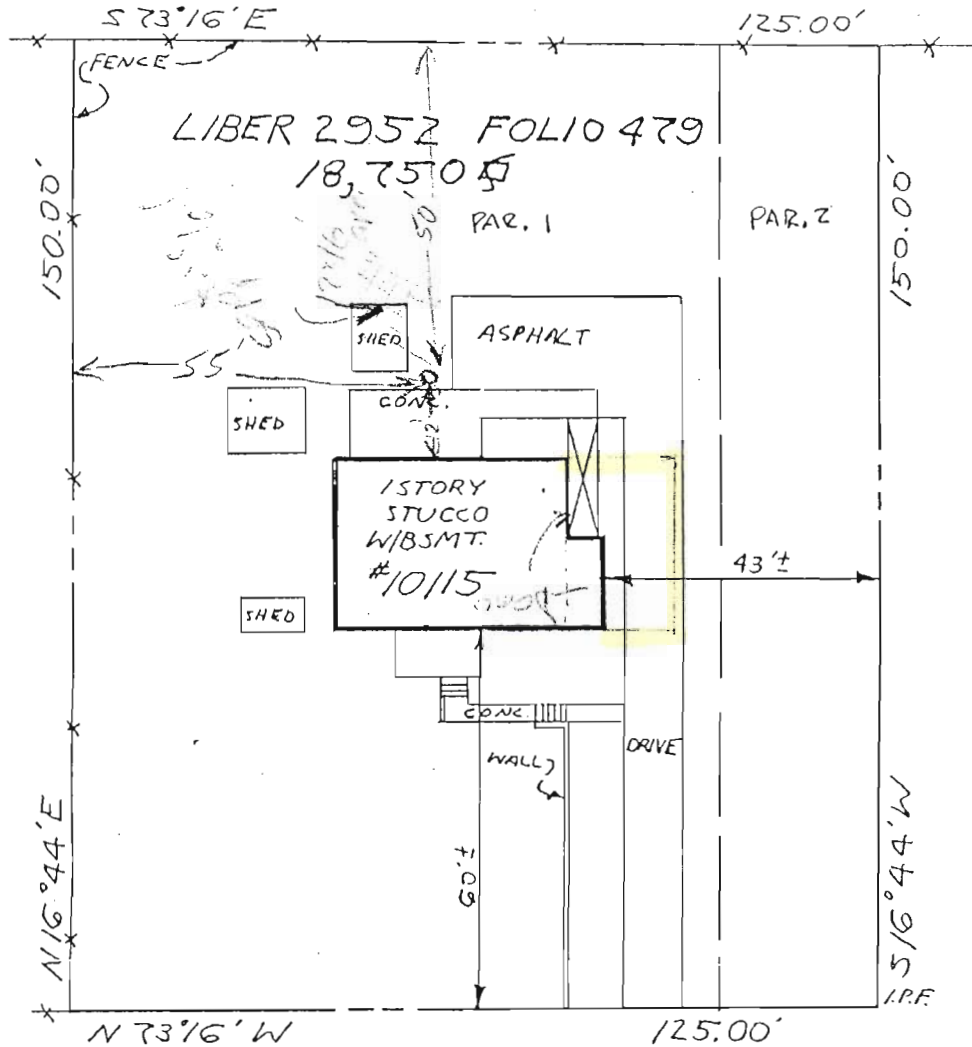

STANSFIELD ROAD

APPROVED

WALK-THRU BUILDING PERMIT
BP# B00158467 PA# 17172
APP. SAN KJB DATE: 3/4/06
DESC. OF WORK: SURVEYOR'S CERTIFICATE



LOCATION DRAWING
JOHNSON PROPERTY 18x26 add.
LIBER 2952 FOLIO 479
HOWARD COUNTY, MD.

I hereby certify that the property delineated hereon is in accordance with the Plat of Subdivision and/or deed of record, that the improvements were located by accepted field practices and include permanent visible structures and apparent encroachments, if any. This Plat is not for determining property lines or for construction of improvements, but prepared for exclusive use of present owners of property and also those who purchase, mortgage, or guarantee the title thereto.