


SITE INSPECTION SHEET

OWNER: Tierney Ahearn PHONE #: _____
ADDRESS: 15280 Sweetbay St CONTRACTOR: _____
Woodbine MD WELL TAG #: HO-95-0633
SUBDIVISION: Belle Haven LOT: 25 COUNTY #: 13
PROPOSAL: Sinking patches continue to appear in yard especially
after heavy rains

LOCATION DIAGRAM

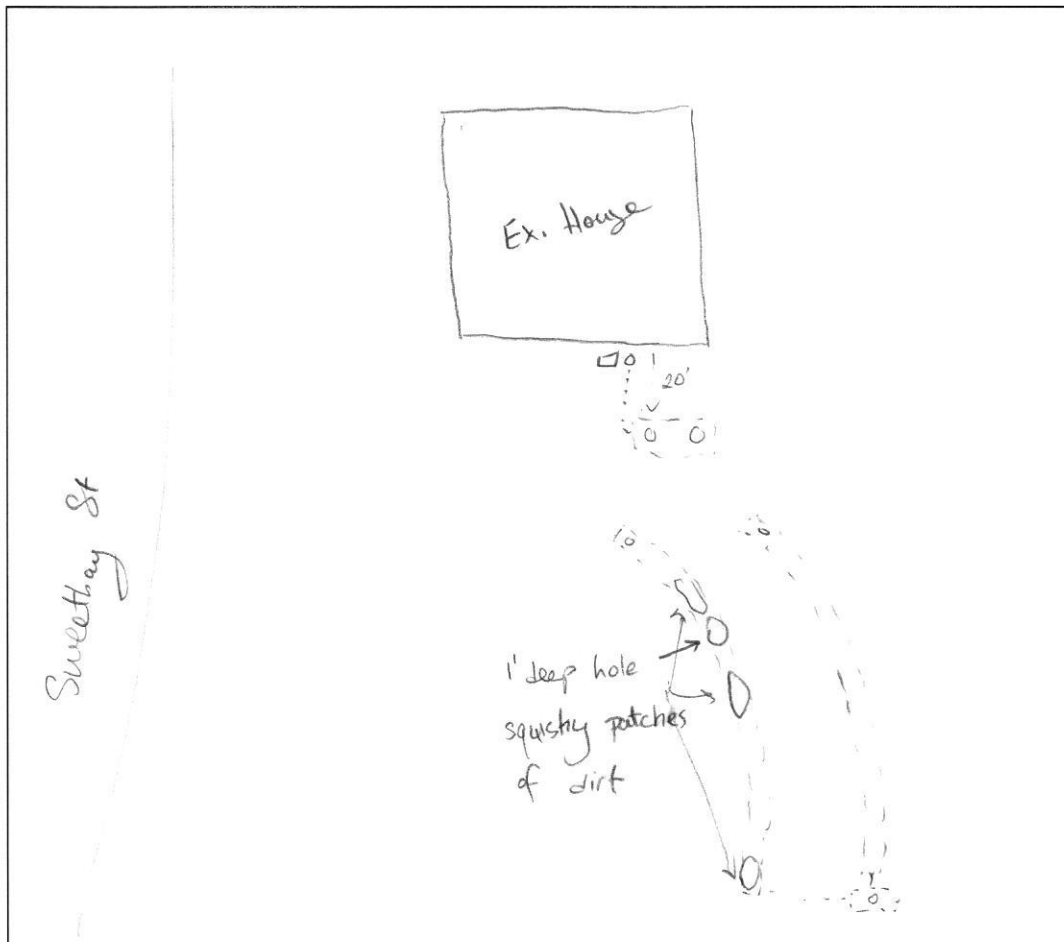

COMMENTS: Large patches of squishy soil along end of second trench. One
patch has 1'x1'x0.5' hole. Observation pipe of second trench has water
at the very bottom, first trench obs. pipe was dry. Lid of tank broken -
water level normal, HOOT observed to function. Mike Sample reports
HOOT last inspected on 4/16/21.

DATE: 9/2/21 INSPECTOR: Susan Thomas

9/2/21 spoke with owner and advised that patches are most
likely result of landscaping. No sign of system failure (SR)



