

Permits: 410-313-2455
Inspections: 410-313-1810
Automated Line: 410-313-3800

Howard County Building/Fire Permit Application
Department of Inspections, Licenses & Permits
3430 Court House Drive
Ellicott City, MD 21043

Permit Number:

B1200094

Building Address: 3625 Ten Oaks Road
13331 Ten Oaks Rd
Yorkville MD 21027
Suite/Apt. # SDP/WP/BA #:
Census Tract: Subdivision:
Section: Area: Lot:
Tax Map: Parcel: Grid:
Zoning: Map Coordinates: Lot Size:

Existing Use: SPD
Proposed Use: SPD
Estimated Construction Cost: \$
Description of Work: 1000 gal underground propane tank

Occupant or Tenant:
Was tenant space previously occupied? ☐ Yes ☐ No
Contact Name:
Address:
City: State: Zip Code:
Phone: Fax:
Email:

Property Owner's Name:
Address:
City: State: Zip Code: 21037
Home Phone: Work Phone:
Applicant's Name & Mailing Address, (If other than stated herein):

Phone: Fax:
Email:

Contractor Company:
Contact Person:
Address:
City: State: Zip Code:
License No.:
Phone: Fax:
Email:

Engineer/Architect Company:
Responsible Design Prof.:
Address:
City: State: Zip Code:
Phone: Fax:
Email:

BUILDING DESCRIPTION - COMMERCIAL	
Building Characteristics	Utilities
Height:	<u>Water Supply</u>
No. of stories:	☐ Public
Gross area, sq. ft./floor:	☐ Private
	<u>Sewage Disposal</u>
Area of construction (sq. ft.):	☐ Public
	☐ Private
Use group:	Electric: ☐ Yes ☐ No
	Gas: ☐ Yes ☐ No
<u>Construction type:</u>	<u>Heating System</u>
☐ Reinforced Concrete	☐ Electric ☐ Oil
☐ Structural Steel	☐ Natural Gas ☐ Propane Gas
☐ Masonry	<u>Sprinkler System:</u>
☐ Wood Frame	☐ N/A
☐ State Certified Modular	☐ Full
☒ Roadside Tree Project Permit	☐ Partial
☐ Yes ☐ No	☐ Other Suppression
Roadside Tree Project Permit #	No. of Heads: <u></u>

BUILDING DESCRIPTION - RESIDENTIAL	
Building Characteristics	Utilities
☐ SF Dwelling ☐ SF Townhouse	<u>Water Supply</u>
<u>Depth</u> <u>Width</u>	☐ Public
1 st floor:	☐ Private
2 nd floor:	<u>Sewage Disposal</u>
Basement:	☐ Public
☐ Finished Basement	☐ Private
☐ Unfinished Basement	Electric: ☐ Yes ☐ No
☐ Crawl Space	Gas: ☐ Yes ☐ No
☐ Slab on Grade	<u>Heating System</u>
No. of Bedrooms:	☐ Electric
<u>Multi-family Dwelling</u>	☐ Oil
No. of efficiency units:	☐ Natural Gas
No. of 1 BR units:	☐ Propane Gas
No. of 2 BR units:	
No. of 3 BR units:	
Other Structure:	
Dimensions:	
Footings:	☒ Roadside Tree Project Permit
Roof:	☐ Yes ☐ No
☐ State Certified Modular	<u>Roadside Tree Project Permit #</u>
☐ Manufactured Home	

THE UNDERSIGNED HEREBY CERTIFIES AND AGREES AS FOLLOWS: (1) THAT HE/SHE IS AUTHORIZED TO MAKE THIS APPLICATION; (2) THAT THE INFORMATION IS CORRECT; (3) THAT HE/SHE WILL COMPLY WITH ALL REGULATIONS OF HOWARD COUNTY WHICH ARE APPLICABLE THERETO; (4) THAT HE/SHE WILL PERFORM NO WORK ON THE ABOVE REFERENCED PROPERTY NOT SPECIFICALLY DESCRIBED IN THIS APPLICATION; (5) THAT HE/SHE GRANTS COUNTY OFFICIALS THE RIGHT TO ENTER ONTO THIS PROPERTY FOR THE PURPOSE OF INSPECTING THE WORK PERMITTED AND POSTING NOTICES.

Applicant's Signature
Email Address
Title/Company

Print Name
Date

Checks Payable to: DIRECTOR OF FINANCE OF HOWARD COUNTY
PLEASE WRITE NEATLY & LEGIBLY
-FOR OFFICE USE ONLY-


AGENCY	DATE	SIGNATURE OF APPROVAL
State Highways		
Building Officials		
PSZA (Zoning)		
PSZA (Engineering)		
Health	2-2-12	Wendy Satt
Fire Protection		


Is Sediment Control approval required for issuance? ☐ Yes ☐ No
☐ CONTINGENCY CONSTRUCTION START
☐ ONE STOP SHOP



DPZ SETBACK INFORMATION
Front:
Rear:
Side:
Side St.:
All minimum setbacks met? ☐ Yes ☐ No
Is Entrance Permit Required? ☐ Yes ☐ No
Historic District? ☐ Yes ☐ No
Lot Coverage for New Town Zone:
SDP/Red-line approval date:

Filing Fee	\$
Permit Fee	\$
Tech Fee	\$
Excise Tax	\$
PSFS	\$
Guaranty Fund	\$
Add'l per Fee	\$
Total Fees	\$
Sub- Total Paid	\$
Balance Due	\$

1 FT Resident

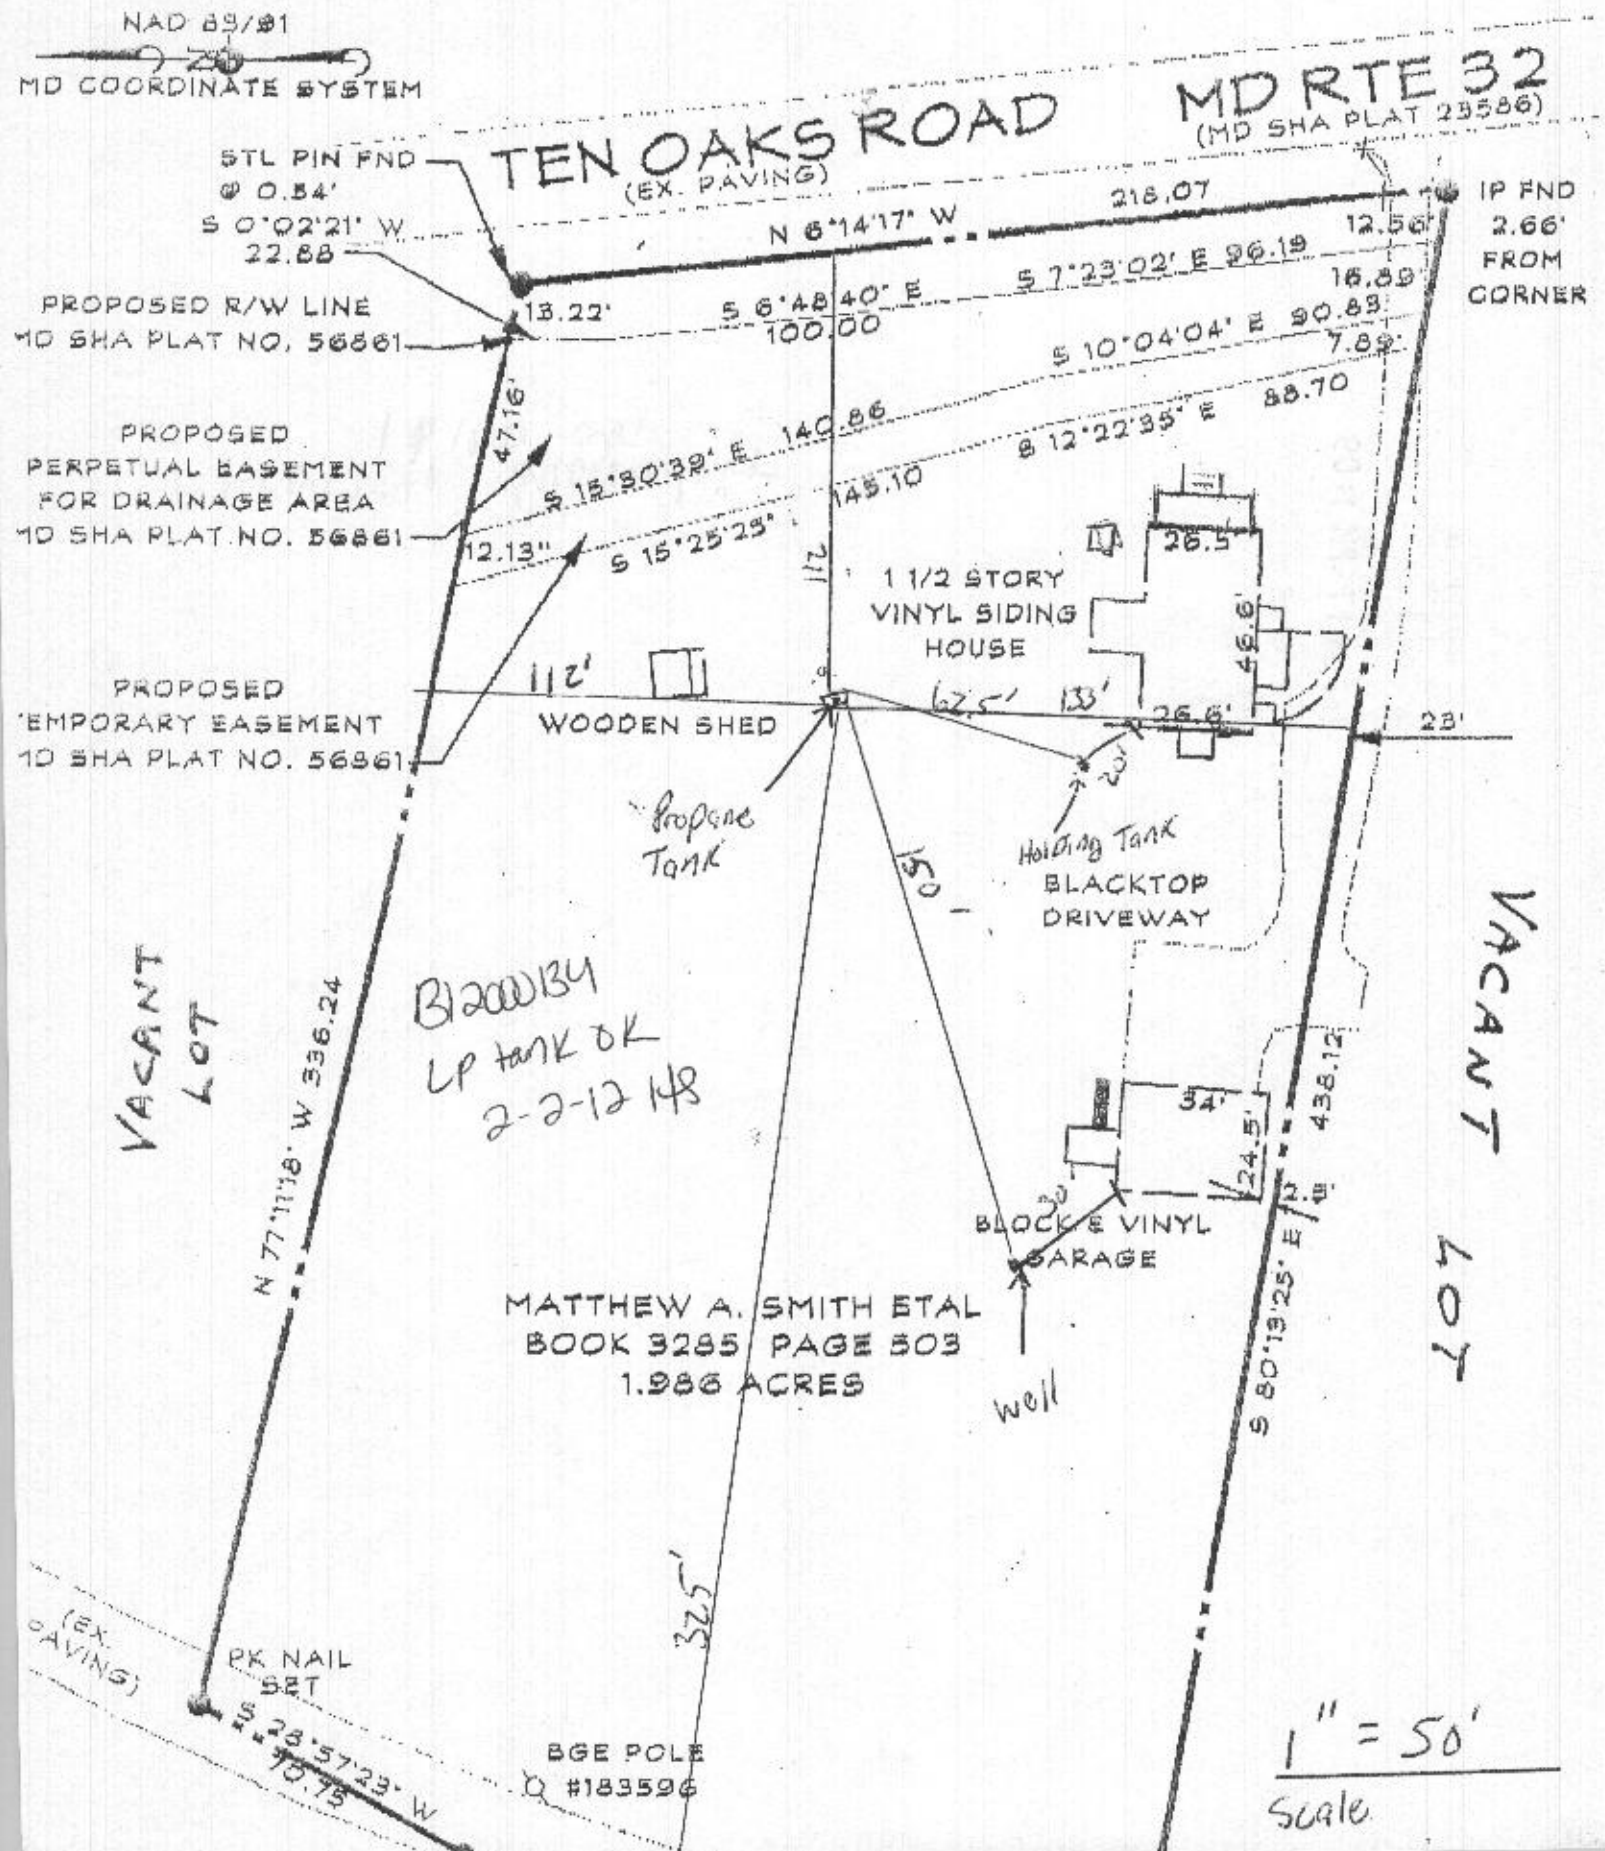

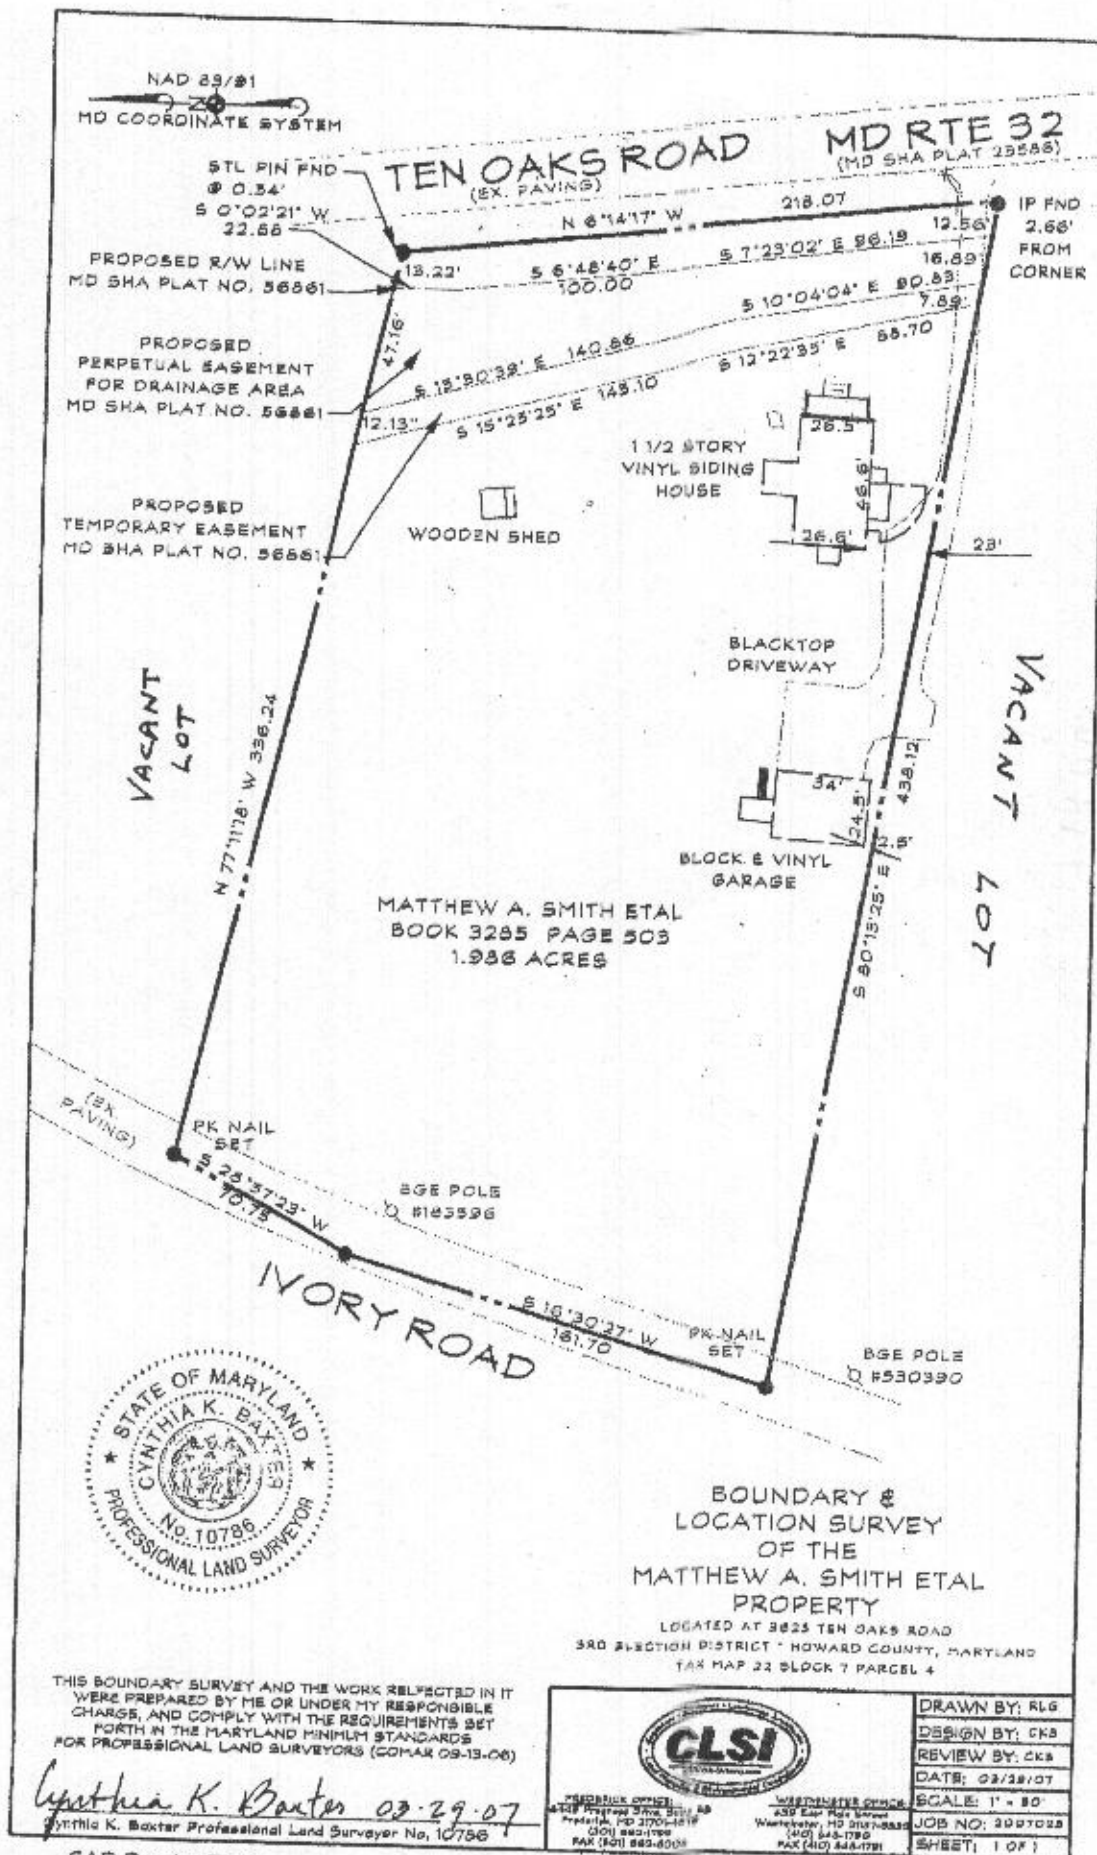

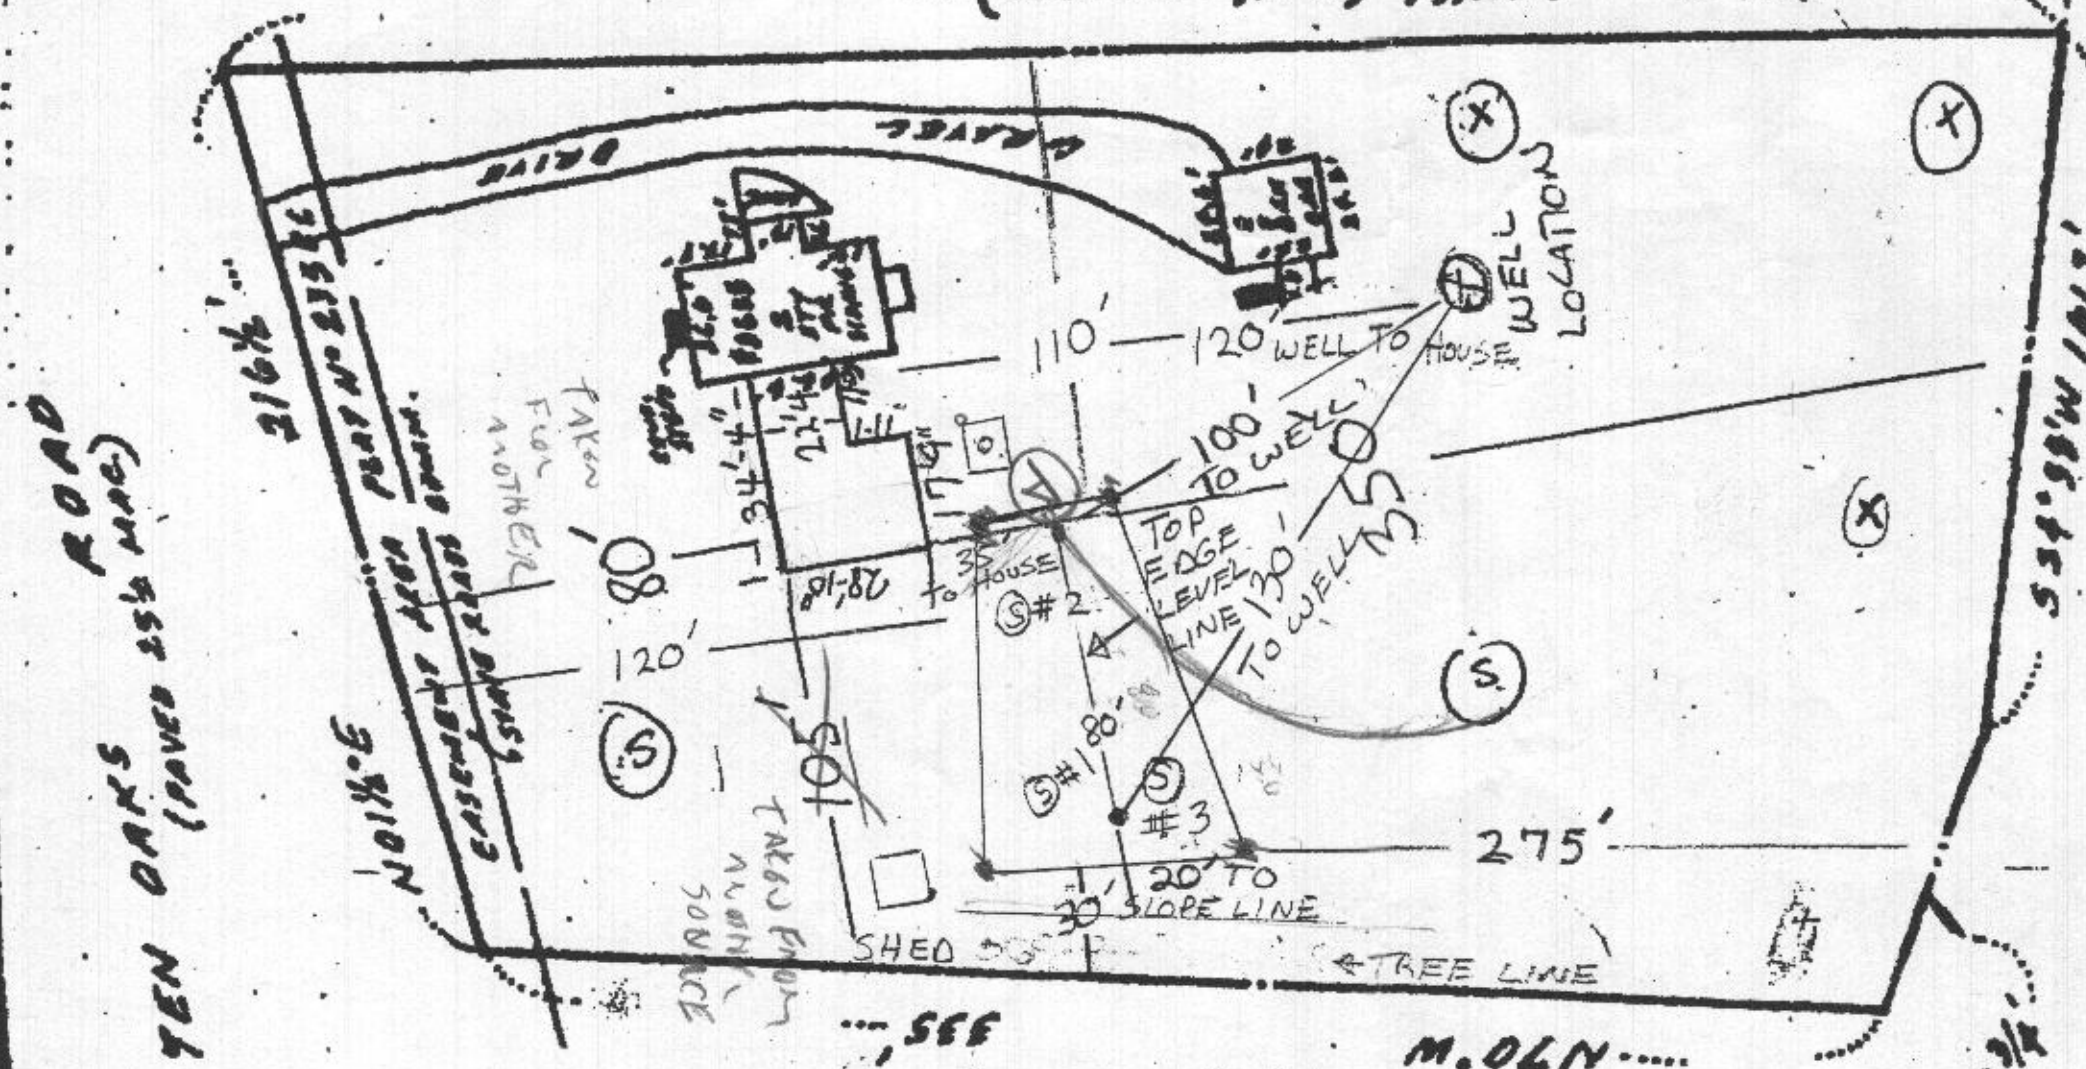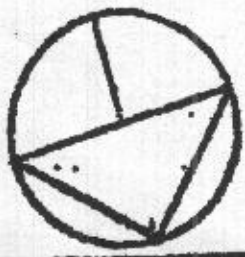

(3) X = CONVENTIONAL IE DIG TO 10-12' FOR H₂O OBS.
 539.5' (36% SLOPE)

(4) S = SAND MOUND
 DIG 5' FOR WATER TABLE & PROFILE


FLOOD INSURANCE RATE
 MAP ZONE: "C"

MATTHEW A. SMITH

3625 TEN OAKS RD.

GLEN ELG MD. 217307

SCALE
 PLANE
 X+B+C

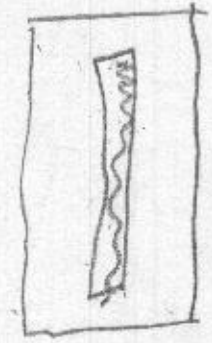

10-20' or all 51065
 10-50