

HOWARD COUNTY
PERMIT APPLICATION

PERMIT NUMBER

B080033M

Building Address 14078 Stearns Valley Ct
Glenwood, MD 21738

Property Owner's Name Stephen Martinec
Address 14078 Stearns Valley Ct

Suite/Apt. #: _____ SDP/WP/Petition #: _____

Census Tract 6040.02 Subdivision Glenlee Estates

City Glenwood State MD Zip Code 21738

Section 1 Area _____ Lot 4

Home Phone 410 485 5779 Work Phone 410 944 7660

Tax Map 21 Parcel 141 Grid 6

Applicant's Name & Mailing Address, (if other than stated hereon):

Zoning RR Map Coordinates _____ Lot size 1.15 Ac

Phone _____ Fax 410 944 5707

Existing Use SFO -

Contractor Company Petrlik Masonry

Proposed Use 3rd - Screened Porch

Contact Person Dave Petrlik

Estimated Construction Cost \$ 24,000

Address _____

Description of Work 20 x 24 L-shaped porch

City _____ State _____ Zip Code _____

Screened porch 16 x 16

License No. _____

Phone _____ Fax _____

Occupant or Tenant _____

Engineer or Architect Company _____

Contact Name _____

Contact Person _____

Address _____

Address _____

City _____ State _____ Zip Code _____

City _____ State _____ Zip Code _____

Phone _____ Fax _____

Phone _____ Fax _____

BUILDING DESCRIPTION - COMMERCIAL

BUILDING DESCRIPTION - RESIDENTIAL

Building Characteristics

Utilities

Height: _____

Water Supply:

No. of stories: _____

Public ☐
Private ☐

Gross area, sq. ft. per floor: _____

Sewage Disposal:

Use group: _____

Public ☐
Private ☐

Construction type:

Electric Yes ☐ No ☐
Gas Yes ☐ No ☐

Reinforced Concrete ☐
Structural Steel ☐
Masonry ☐
Wood Frame ☐

Heating System:

State Certified Modular ☐

Electric ☐ Oil ☐
Natural Gas ☐
Propane Gas ☐

Sprinkler system: N/A ☐

Full ☐
Partial ☐
Other Suppression ☐
of Heads _____

Building Characteristics

Utilities

SF Dwelling ☐ SF Townhouse ☐

Depth _____ Width _____

1st floor: _____

2nd floor: _____

Basement: _____

Finished Basement ☐ Unfinished Basement ☐

Crawl space ☐ Slab on Grade ☐

No. of Bedrooms _____

Height: _____

Multi-family dwellings:

No. of efficiency units: _____

No. of 1 BR units: _____

No. of 2 BR units: _____

No. of 3 BR units: _____

Other Structure: _____

Dimensions: _____

Footings: _____

Roof Height: _____

State Certified Modular ☐

Manufactured Home ☐

Water Supply:

Public ☐
Private ☐

Sewage Disposal:

Public ☐
Private ☐

Electric Yes ☐ No ☐
Gas Yes ☐ No ☐

Heating System:

Electric ☐ Oil ☐
Natural Gas ☐
Propane Gas ☐

Sprinkler system: N/A ☐

NFPA #13D ☐
NFPA #13R ☐

Other: _____

THE UNDERSIGNED HEREBY CERTIFIES AND AGREES AS FOLLOWS: (1) THAT HE/SHE IS AUTHORIZED TO MAKE THIS APPLICATION; (2) THAT THE INFORMATION IS CORRECT; (3) THAT HE/SHE WILL COMPLY WITH ALL REGULATIONS OF HOWARD COUNTY WHICH ARE APPLICABLE THERETO; (4) THAT HE/SHE WILL PERFORM NO WORK ON THE ABOVE REFERENCED PROPERTY NOT SPECIFICALLY DESCRIBED IN THIS APPLICATION; (5) THAT HE/SHE GRANTS COUNTY OFFICIALS THE RIGHT TO ENTER ONTO THIS PROPERTY FOR THE PURPOSE OF INSPECTING THE WORK PERMITTED AND POSTING NOTICES.

Stephen Martinec
Applicant's Signature

Stephen Martinec
Print Name

Title/Company _____

Date 11/12/08

Checks payable to: **DIRECTOR OF FINANCE OF HOWARD COUNTY**

** PLEASE WRITE NEATLY AND LEGIBLY. **

- FOR OFFICE USE ONLY -

AGENCY DATE SIGNATURE APPROVAL
Land Development, DPZ 11/12/08 Cheryl E. H.
State Highways _____
Building Official _____
Dev. Engineering, DPZ _____
Health 11/11/08 Jeffrey Smith
Fire Protection _____

Is Sediment Control approval required prior to issuance?

YES ☐ NO ☐

CONTINGENCY CONSTRUCTION START: ☐

ONE STOP SHOP: ☐

DPZ SETBACK INFORMATION

Front: 15 FT

Rear: 30 FT

Side: 10 FT

Side St.: N/A

All minimum setbacks met?

YES ☒ NO ☐

Is Entrance Permit required?

YES ☐ NO ☒

Historic District?

YES ☐ NO ☒

Lot Coverage for New Town Zone _____

SDP/Red-line approval date _____

PROPERTY ID#:

Filing fee \$ _____

Permit fee \$ _____

Excise tax \$ _____

Add'l per. fee \$ _____

TOTAL FEES \$ _____

Sub-total paid \$ _____

Balance due \$ _____

Check # 519

Validation # _____

Distribution of Copies-

White: Building Official

Green: LDD, DPZ

Yellow: DED, DPZ

Pink: Health

Gold: SHA

Accepted by _____

T:\forms\PERMIT.FRM

Rev. 11/4/04

DEED REFERENCE
682.666

LOT NO 4 BLOCK 'B'. SEC. 1.
'GWENLEE ESTATES'
(26.40 AND 41)

3RD AND 4TH ELECT DIST.
HOWARD CO., MD.


APPROVED

WALK-THRU BUILDING PERMIT

BP# _____ A# 18336

APP. SAN HS _____ DATE: 11/11/08

DESC. OF WORK: Screened porch
as shown 20' x 24'

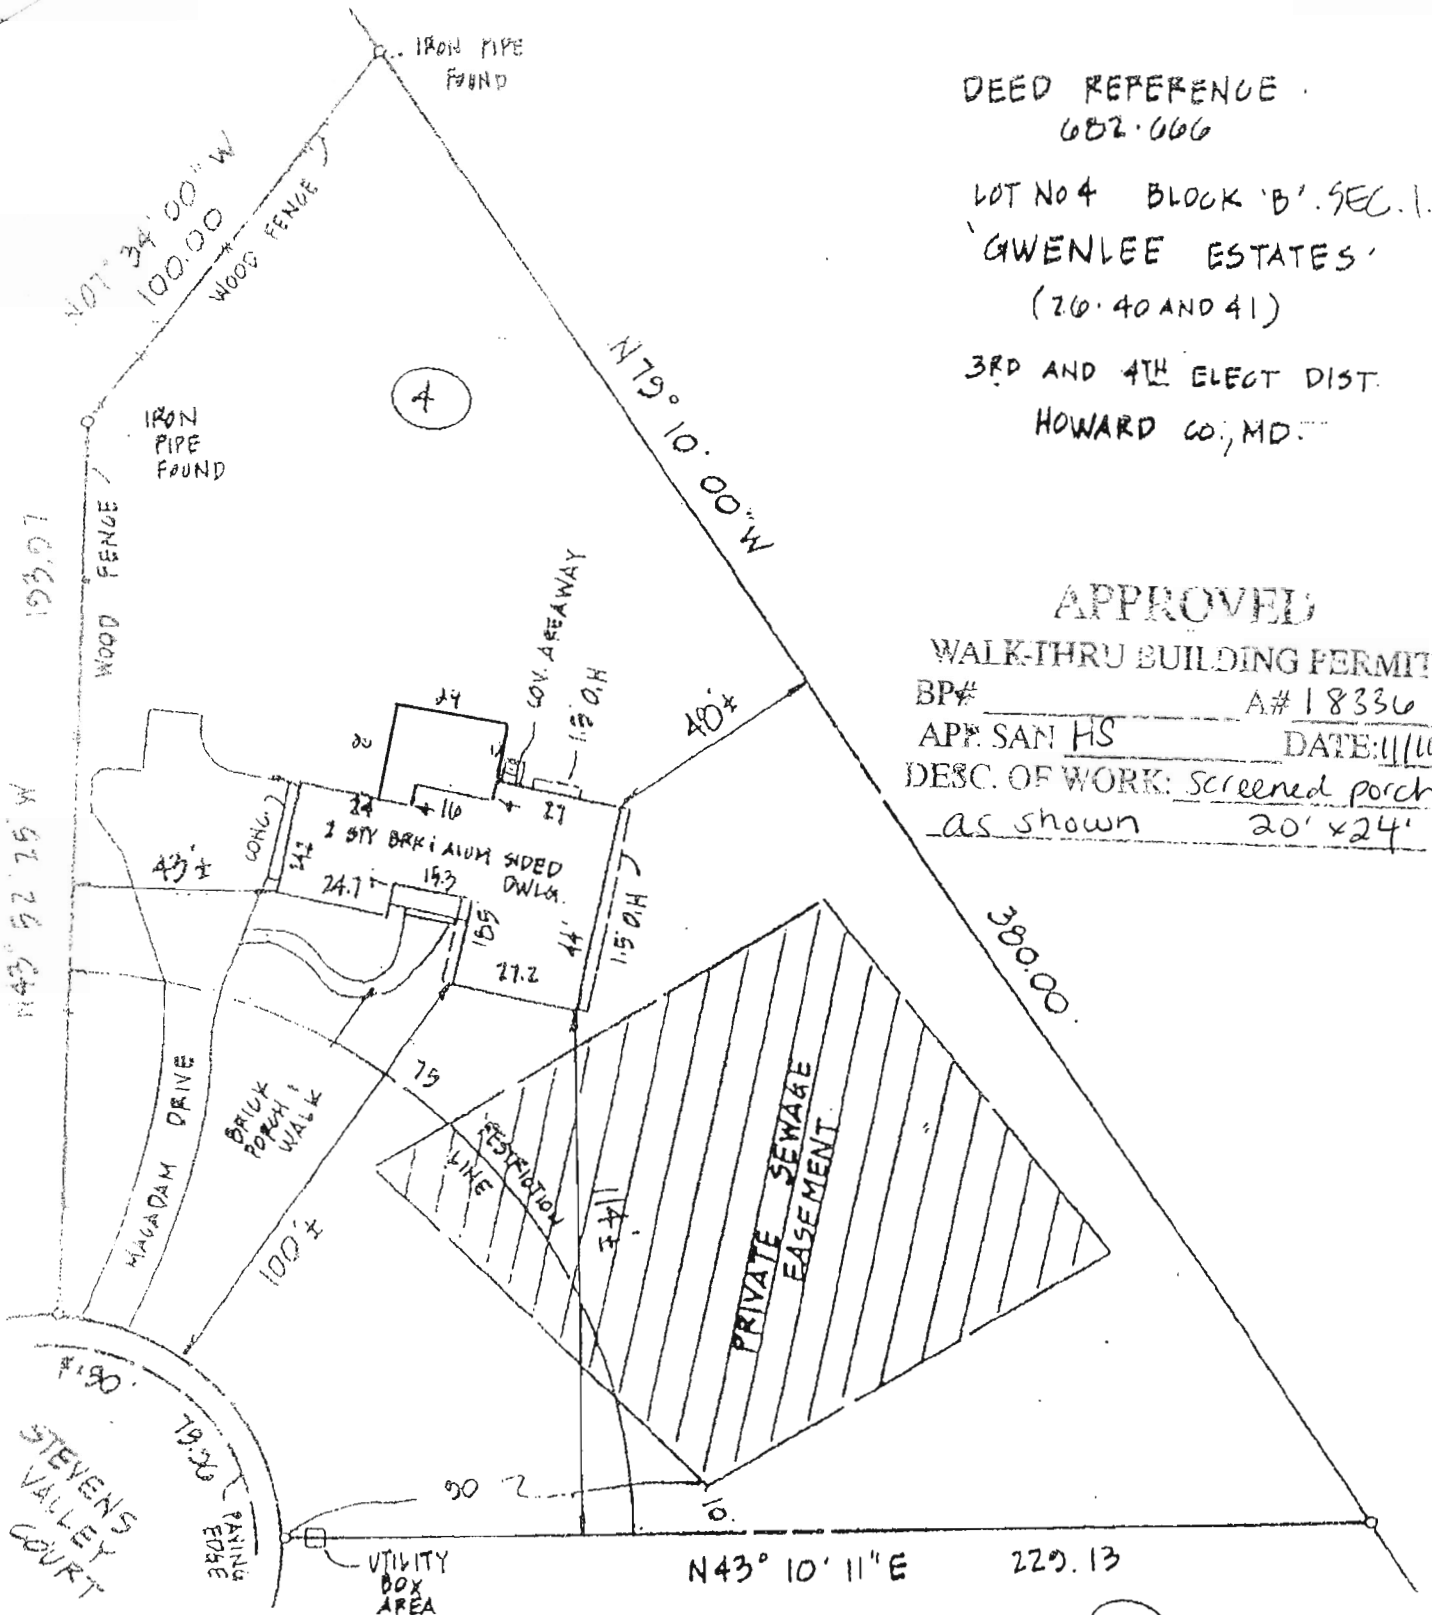

- 1.) The plat is of benefit to a consumer only insofar as it is required by a lender or a title insurance company or its agent in connection with contemplated transfer financing or re-financing.
- 2.) The plat is not to be relied upon for the establishment or location of fences, garages, buildings, or other existing or future improvements.
- 3.) The plat does not provide for the accurate identification of property boundary lines, but such identification may not be required for the transfer of title or securing financing or refinancing.

4.) I have examined Flood Insurance Rate Map Panel Number 240044/0020B

for the subject property and it appears to lie within Zone C per