



HOWARD COUNTY HEALTH DEPARTMENT

A533204

DATE
4/21/2010

Received
From

Mr. Anh Tran

PHONE # 410-977-5705

11226 Edison Park Pl, Apt 24, N. Bethesda MD 20852

For

Per Application

☐ CASH

☐ CHECK

Heritage Heights, Lot 3, 16117 Thompson Dr

NO.

816

Five hundred six and 00/100


Dollars

\$

506 00

Received By

Mary J. Briggs

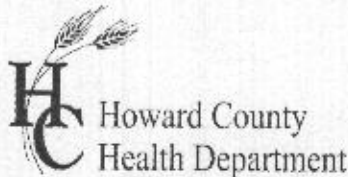

APPLICATION

FOR PERCOLATION TESTING AND SITE EVALUATION

TEST DATE(S) _____ TEST TIME _____ AP 533204
AGENCY REVIEW: _____ DATE 4/21/10

DO NOT WRITE ABOVE THIS LINE

I HEREBY APPLY FOR THE NECESSARY TESTING/EVALUATION PRIOR TO ISSUANCE OF SEWAGE DISPOSAL SYSTEM PERMIT(S) TO:

CHECK AS NEEDED:

- ☐ CONSTRUCT NEW SEPTIC SYSTEM(S)
☒ REPAIR/ADD TO AN EXISTING SEPTIC SYSTEM
☒ REPLACE AN EXISTING SEPTIC SYSTEM

CHECK ONE:

- ☐ CREATE NEW LOT(S)
☐ BUILD ON AN EXISTING LOT IN A SUBDIVISION
☐ BUILD ON AN EXISTING PARCEL OF RECORD

CHECK AS NEEDED:

- ☐ NEW STRUCTURE(S)
☒ ADDITION TO AN EXISTING STRUCTURE
☐ REPLACE AN EXISTING STRUCTURE

IS THE PROPERTY WITHIN 2500' OF ANY RESERVOIR?

- ☐ YES
☒ NO

THE TYPE OF STRUCTURE IS:

- ☒ RESIDENTIAL WITH 3 PROPOSED BEDROOMS IN THE COMPLETED STRUCTURE (NOTE **UNKNOWN** IF APPROPRIATE)
☐ COMMERCIAL (PROVIDE DETAIL OF NUMBERS AND TYPES OF EMPLOYEES/ CUSTOMERS ON ACCOMPANYING PLAN)
☐ INSTITUTIONAL/GOVERNMENT (PROVIDE DETAIL OF NUMBERS AND TYPES OF EMPLOYEES/USERS ON ACCOMPANYING PLAN)

PROPERTY OWNER(S) VU + DEBBIE TRAN

DAYTIME PHONE _____ CELL _____ FAX _____

MAILING ADDRESS _____
STREET CITY/TOWN STATE ZIP

APPLICANT JIM BRUMSTED

DAYTIME PHONE 410 977 5705 CELL 410 977 5705 FAX 410 381 1211

MAILING ADDRESS 10260 OLD COLUMBIA ROAD COLUMBIA MD. 21046
STREET CITY/TOWN STATE ZIP

APPLICANT'S ROLE: DEVELOPER BUILDER BUYER RELATIVE/FRIEND REALTOR CONSULTANT

PROPERTY LOCATION

SUBDIVISION/PROPERTY NAME HERITAGE HEIGHTS DRIVE LOT NO. 3

PROPERTY ADDRESS 6117 THOMPSON DRIVE CLARKSVILLE MD 21029
STREET TOWN/POST OFFICE

TAX MAP PAGE(S) 34 GRID 12 PARCEL(S) 203 ~~PERMITS~~ LOT SIZE 19,994


AS APPLICANT, I UNDERSTAND THE FOLLOWING: THE SYSTEM INSTALLED SUBSEQUENT TO THIS APPLICATION IS ACCEPTABLE ONLY UNTIL PUBLIC SEWERAGE IS AVAILABLE. THIS APPLICATION IS COMPLETE WHEN ALL APPLICABLE FEES AND A SUITABLE SITE PLAN HAVE BEEN RECEIVED. I ACCEPT THE RESPONSIBILITY FOR COMPLIANCE WITH ALL M.O.S.H.A. AND "MISS UTILITY" REQUIREMENTS. APPROVAL IS BASED UPON SATISFACTORY REVIEW OF A PERC CERTIFICATION PLAN.

TEST RESULTS WILL BE MAILED TO APPLICANT.

SIGNATURE OF APPLICANT

HOWARD COUNTY HEALTH DEPARTMENT, BUREAU OF ENVIRONMENTAL HEALTH, WELL AND SEPTIC PROGRAM
1718 COLUMBIA GATEWAY DRIVE COLUMBIA, MARYLAND 21046 (410) 313-2640 FAX (410) 313-2648
TDD (410) 313-2323 TOLL FREE 1-877-4MD-DHMH

AP

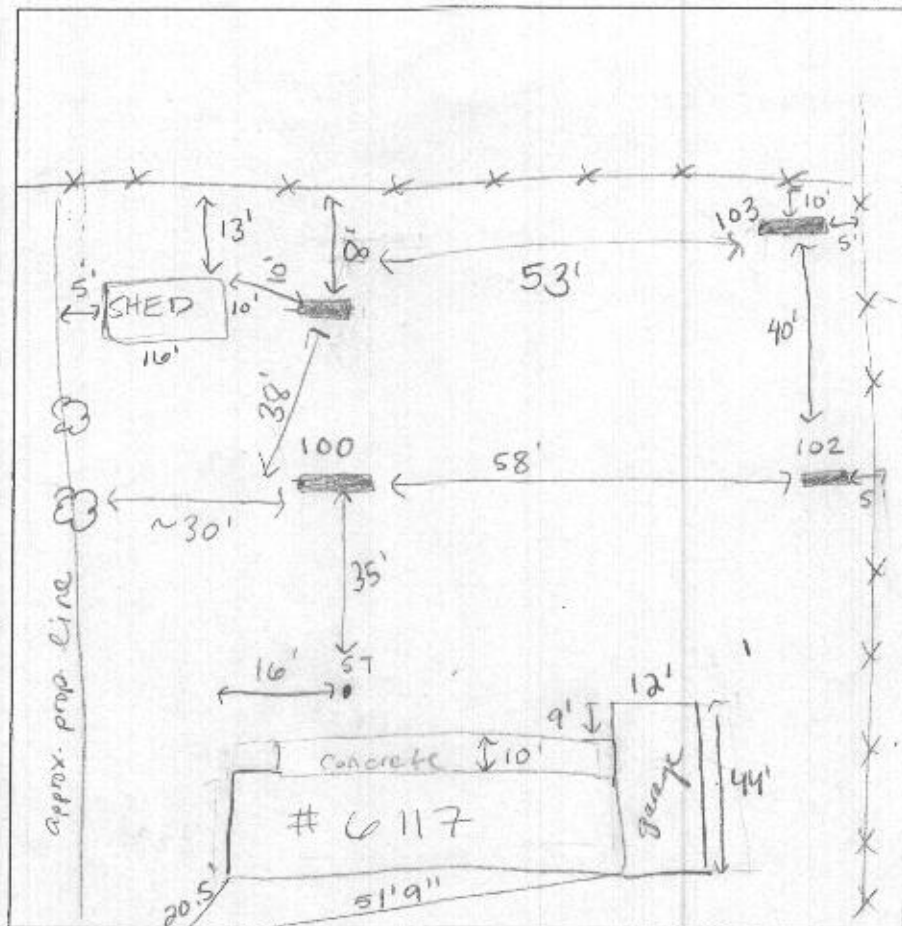

Well @ buried

[illegible]

REMARKS holes consistent, pit well exposed (buried)

SANITARIAN HS BACKHOE Whitworth Ex OTHERS Jim, owner

TEST HOLES USED IN SDA 4 AVG. PERC TIME _____ SQ. FT/BR _____

TRENCH WIDTH 2 INLET DEPTH 3 MAX. BOT DEPTH 8' EFFECTIVE S/W 2'-3'

• 44 sidewall

Quintus




field work performed by me or under my direct supervision,
Mike Sunde 5/18/2010

"Approved For Private Water and Private Sewage Systems"

B. Nelson for Peter Bejkenson 5/26/10
Health Officer, Howard County. Date

5/26/10
Date

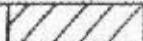- This plan is in support of a 2nd story addition with >250 sq. ft. of living space (no footprint change)
- Any changes to a private sewage easement shall require a revised percolation certification plan.
- The topography is taken from county GIS and is verified to accurately represent the relative changes on the subject property.
- All wells & septic systems located within 100' of the property boundaries and 200' down gradient of any wells and or septic systems have been shown.
- The existing well will be updated to current code prior to building permit approval.
-  This area designates a private sewage area as required by the Maryland State Dept. of the Environment for individual sewage disposal. For lots created after March of 1972 it provides at least enough area to accommodate an initial and two replacement septic systems as required by Howard County Health Dept. Improvements of any nature in this area is restricted until public sewage is available. This area shall become null and void upon connection to a public sewage system. The county Health Officer shall have the authority to grant adjustments to the private sewage area. Recordation of a modified sewage area shall not be necessary.