

DEPARTMENT OF INSPECTIONS, LICENSING AND PERMITS 3000 COURT HOUSE DRIVE ELICOTT CITY, MD 21043 PERMITS (410) 313-2400 INSPECTIONS (410) 313-1810 AUTOMATED INFORMATION (410) 313-3800		HOWARD COUNTY PERMIT APPLICATION		PERMIT NUMBER BO8002032	
Building Address <u>13263 Styer Ct</u> <u>Highland, MO 20777</u>			Property Owner's Name <u>Earl + Ellen Laver</u>		
Suite/Apt. #: _____ SDP/WP/Petition #: _____			Address <u>13263 Styer Ct</u>		
Census Tract _____ Subdivision _____			City <u>Highland</u> State <u>MD</u> Zip Code <u>20777</u>		
Section _____ Area _____ Lot <u>3</u>			Phone <u>410-531-2109</u>		
Tax Map <u>34</u> Parcel <u>374</u> Grid <u>15</u>			Applicant's Name & Mailing Address, (if other than stated hereon): _____		
Zoning _____ Map Coordinates _____ Lot size _____			Phone _____ Fax _____		
Existing Use <u>SFD</u>			Contractor Company <u>Probit Construction, Inc</u>		
Proposed Use <u>SFD w/ deck + screen porch</u>			Contact Person <u>Edward Pacylowski</u>		
Estimated Construction Cost \$ <u>38,510</u>			Address <u>13330 clarksville Pike</u>		
Description of Work <u>build approx. 11x29</u> <u>deck, includes screen porch and</u> <u>12x14 separate deck w/</u> <u>steps to grade</u>			City <u>Highland</u> State <u>MD</u> Zip Code <u>20777</u>		
Occupant or Tenant _____			License No. <u>208017</u>		
Contact Name _____			Phone <u>301-854-0511</u> Fax <u>301-854-9632</u>		
Address _____			Engineer or Architect Company _____		
City _____ State _____ Zip Code _____			Contact Person _____		
Phone _____ Fax _____			Address _____		
City _____ State _____ Zip Code _____			City _____ State _____ Zip Code _____		
Phone _____ Fax _____			Phone _____ Fax _____		

BUILDING DESCRIPTION - <u>COMMERCIAL</u>		BUILDING DESCRIPTION - <u>RESIDENTIAL</u>	
Building Characteristics Height: _____ No. of stories: _____ Gross area, sq. ft. per floor: _____ Use group: _____ Construction type: ☐ Reinforced Concrete ☐ Structural Steel ☐ Masonry ☐ Wood Frame ☐ State Certified Modular	Utilities Water Supply: ☐ Public ☐ Private Sewage Disposal: ☐ Public ☐ Private Electric Yes ☐ No ☐ Gas Yes ☐ No ☐ Heating System: ☐ Electric ☐ Oil ☐ ☐ Natural Gas ☐ ☐ Propane Gas ☐ Sprinkler system: N/A ☐ ☐ Full ☐ Partial ☐ Other Suppression ☐ # of Heads	Building Characteristics SF Dwelling ☒ SF Townhouse ☐ <u>Depth</u> <u>Width</u> 1st floor: _____ 2nd floor: _____ Basement: _____ ☐ Finished Basement ☐ Unfinished Basement ☐ Crawlspace ☐ Slab on Grade ☐ No. of Bedrooms: _____ Height: _____ Multi-family dwellings: No. of efficiency units: _____ No. of 1 BR units: _____ No. of 2 BR units: _____ No. of 3 BR units: _____ Other Structure: _____ Dimensions: _____ Footings: <u>POST + PIERS</u> Roof Height: _____ ☐ State Certified Modular ☐ Manufactured Home	Utilities Water Supply: ☐ Public ☒ Private Sewage Disposal: ☐ Public ☒ Private Electric Yes ☐ No ☐ Gas Yes ☐ No ☐ Heating System: ☐ Electric ☐ Oil ☐ ☐ Natural Gas ☐ ☐ Propane Gas ☐ Sprinkler system: N/A ☐ ☐ NFPA #13D ☐ NFPA #13R ☐ Other:


THE UNDERSIGNED HEREBY CERTIFIES AND AGREES AS FOLLOWS: (1) THAT HE/SHE IS AUTHORIZED TO MAKE THIS APPLICATION; (2) THAT THE INFORMATION IS CORRECT; (3) THAT HE/SHE WILL COMPLY WITH ALL REGULATIONS OF HOWARD COUNTY WHICH ARE APPLICABLE THERETO; (4) THAT HE/SHE WILL PERFORM NO WORK ON THE ABOVE REFERENCED PROPERTY NOT SPECIFICALLY DESCRIBED IN THIS APPLICATION; (5) THAT HE/SHE GRANTS COUNTY OFFICIALS THE RIGHT TO ENTER ONTO THIS PROPERTY FOR THE PURPOSE OF INSPECTING THE WORK PERMITTED AND POSTING NOTICES.

Signature
President
 Title/Company

Edward Pacylowski
 Print Name
7/9/08
 Date

Checks payable to: **DIRECTOR OF FINANCE OF HOWARD COUNTY**
 ** PLEASE WRITE NEATLY AND LEGIBLY. **
 - FOR OFFICE USE ONLY -

AGENCY	DATE	SIGNATURE APPROVAL	DPZ SETBACK INFORMATION	PROPERTY ID#
Land Development, DPZ			Front: _____	Filing fee \$ _____
State Highways			Rear: _____	Permit fee \$ _____
Building Official			Side: _____	Excise tax \$ _____
Dev. Engineering, DPZ			Side St: _____	Add'l per. fee \$ _____
Health	<u>7/9/08</u>	<u>[Signature]</u>	All minimum setbacks met?	TOTAL FEES \$ _____
Fire Protection			YES ☐ NO ☐	Sub-total paid \$ _____
Is Sediment Control approval required prior to issuance?			Is Entrance Permit required?	Balance due \$ _____
YES ☐ NO ☐			YES ☐ NO ☐	Check # _____
CONTINGENCY CONSTRUCTION START: ☐			Historic District?	Validation # _____
ONE STOP SHOP: ☐			YES ☐ NO ☐	
			Lot Coverage for NewTown Zone _____	
			SDP/Red-line approval date _____	Accepted by _____
Distribution of Copies: White: Building Official Green: LDD, DPZ Yellow: DED, DPZ Pink: Health Gold: SHA				
T:\format\PERMIT.FRM Rev. 11/4/04				

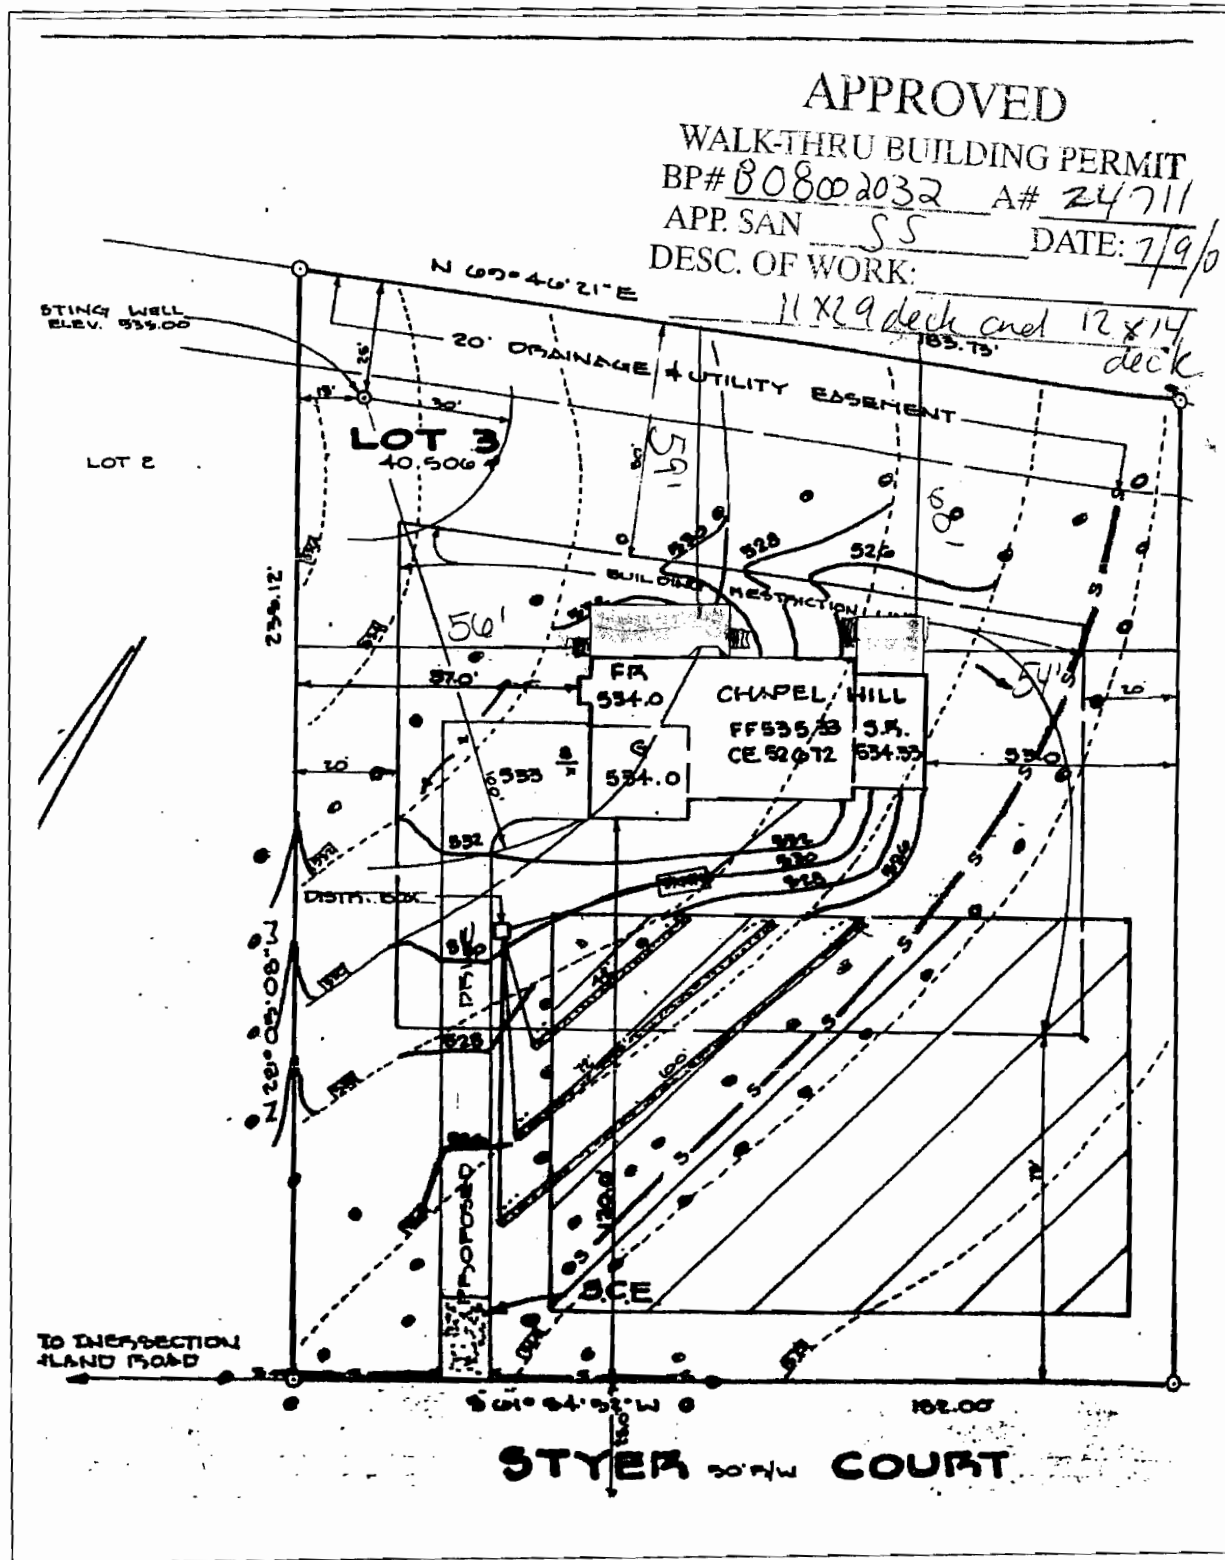

A# 24711

APPROVED
 WALK-THRU BUILDING PERMIT
 BP# 808002032 A# 24711
 APP. SAN SS DATE: 7/9/08
 DESC. OF WORK: 11x29 deck and 12x14 deck

<i>Designworks</i> PROBUILT CONSTRUCTION, INC.	General Contractor Pro-Built Construction, Inc 13330 Clarksville Pike Highland, MD 20777 www.probuiltconstruction.com	Project Title Earl Lauer 13263 Styer Court Highland, MD, 20777	Project Manager Michael Pacylowski	Drawing Title Site Plan
			Drawn By Brandon Hebard	Scale 1" = 40'0"
			PRO-BUILT CONSTRUCTION, INC. RETAINS SOLE OWNERSHIP OF ALL DOCUMENTS PROVIDED FOR THE EXPRESS BENEFIT OF ITS CLIENTS, AND PROSPECTIVE CLIENTS. DISTRIBUTION OF THESE MATERIALS WITHOUT WRITTEN CONSENT IS STRICTLY PROHIBITED.	

