
DEPT. OF INSPECTIONS, LICENSES AND PERMITS
3430 COURT HOUSE DRIVE
ELLICOTT CITY, MD 21043
PERMITS (410) 313-2455
INSPECTIONS (410) 313-1810

HOWARD COUNTY PERMIT APPLICATION

B09000529 PERMIT NUMBER

INSPECTIONS (410) 313-1810 AUTOMATED INFORMATION (410) 313-3800 PERMIT AP		PLICATION PERMIT NUMBER		
Building Address 13271 574	ER CT	Property Owner's	s Name WELSH	, WILLIAM & KAREN
HIGHLAND MID 20777		City / State MO 7 in Code 2027		
Suite/Apt. #: SDP/WP/Petition #:		City HIGHLAND State MO Zip Code 30777 Phone 30/854-3454 Phone		
		Applicant's Name & Mailing Address, (if other than		
Census Tract Subdivision AllNUTT FARMS EST.		stated herein):		
Section 3 Area Lot 5				
Section C Area Lot 5				
Tax Map 34 Parcel 374 Grid 15				
		Phone Fax		
Zoning Map Coordinates Lot Size \(\psi_1\) 946		Contractor Company Pata Enclosures Imc.		
Existing Use SFD & HEATED SUN PORCH		Contractor Comp	Dany Tatio O	relosures Imc.
Estimated Construction Cost \$ 30,000		Address 224 8th AVE NW		
Description of Work CONSTRUCT 15 x 13		City Stan Burnie State mo Zip Code 21061		
		Licerise No. 12744		
HEATED SUN ROOM ON NEW		Phone 410 760 1919 Fax		
WOOD FOUNDATION ON REAR				
Occupant or Tenant OWNER		Engineer or Architect Company		
Contact Name		Contact Parson		
Contact Name		Contact Person		
Address		Address		
CityStateZi	p Code	City	State	Zip Code
Phone Fax		Phone	Fax	
A WA			A WA	
BUILDING DESCRIPTION – C	BUILDING	DESCRIPTIO	N – <u>RESIDENTIAL</u>	
Building Characteristics Height: Water Supply	<u>Utilities</u>	Building Chai SF Dwelling SF SF	racteristics	Utilities Water Supply:
Public		Depth Wid	lth	Public
No. of stories: Private Sewage Disp		1 st floor: /5' ×	13	Private Sewage Disposal:
Gross area, sq. ft. per floor: Public			95 SF)	Public
Use group:		Finished Basement D U	. /	Private
Electric Y	es □ No □	Crawl space Some Some Some Some Some Some Some Som	lab on Grade 🗆	Electric Yes No □
Construction type: Gas Y Reinforced Concrete	'es □ No □	87 70.22		Gas Yes 🗆 No 📭
Structural Steel Veating Syste		Multi-family dwellin No. of efficiency uni	igs: ts:	Heating System.
Masonry Electric □ Wood Frame Natural Gas	Oil 🗆	No. of 1 BR units:		Electric Oil Oil Natural Gas
State Certified Modular Propane Gas		No. of 2 BR units: _ No. of 3 BR units: _		Propane Gas □
Sprinkler syst	tem: N/A □			Sprinkler system: N/A
- Full Partial		Other Structure: Dimensions:		NFPA #13D NFPA #13R
Other S	uppression	Footings:	FD	Other:
# of He	ads		_	*
		State Certified Manufactured 1	Home //~	
THE UNDERSIGNED HEREBY CERTIFIES AND AGREES AS FOLLOWS: (1) THAT HE/SHE IS AUTHORIZED TO MAKE THIS APPLICATION: (2) THAT THE INFORMATION IS CORRECT; (3) THAT HE/SHE WILL COMPLY WITH ALL REGULATIONS OF HOWARD COUNTY WHICH ARE APPLICABLE THERETO; (4) THAT HE/SHE WILL PERFORM				
NO WORK ON THE ABOVE REFERENCED PROPERTY NOT SPECIFICALLY DESCRIBED IN THIS APPLICATION; (5) THAT HE/SHE GRANTS COUNTY OFFICIALS THE RIGHT TO ENTER ONTO THIS PROPERTY FOR THE PURPOSE OF INSPECTING THE WORK PERMITTED AND POSTING NOTIFIES.				
(hegay It feetter (good) GREGORY I-1. FALTER				
Applicant's Signature Print Name				
	e			
Title/Compan	у		Date	
Checks payable to: DIRECTOR OF FINANCE OF HOWARD COUNTY				
PLEASE WRITE NEATLY AND LEGIBLY.				
- FOR OFFICE USE ONLY -				
AGENCY DATE SIGNATE Land Development, DPZ	FURE APPROVAL	DPZ SETBACK IN		PROPERTY ID#
State Highways	" Constitution of the Cons	Front:		Filing fee \$ Permit fee \$
Building Officials Dev. Engineering, DPZ 3-25-09 Dec	ing Brance of	Side:		Excise tax \$
Health		All minimum setback	COLUMN ASSESSMENT OF THE PARTY	Add'l per fee \$TOTAL FEES \$
Fire Protection Is Sediment Control approval required prior to issuance?		YES □ NO □ Is Entrance Permit		Sub-total paid \$
YES D NO D		YES D NO D	cquireu?	Balance due \$
		Historic District?		Validation #
CONTINGENCY CONSTRUCTION START: □ ONE STOP SHOP: □		Lot Coverage for Ne	w Town Zone	
		SDP/Red-line approv	val date	No. of the Control of the Marie Control of
Distribution of Copies - White: Building Officials Green: LDD, DPZ Yellow: DED, DPZ Pink: Health Gold: SHA T:forms/buildingpermitapplication REV 10/28/04				

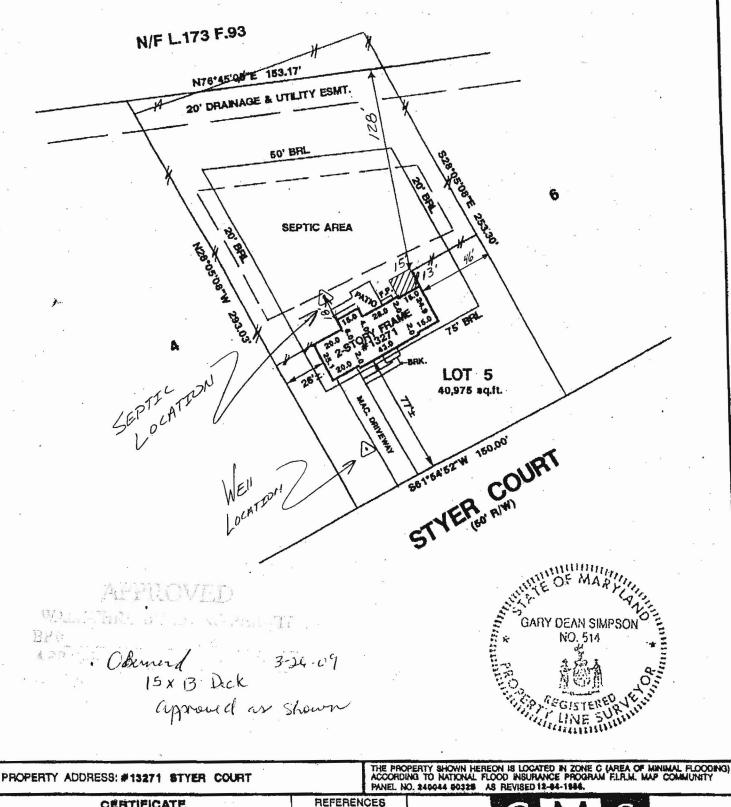

CENTIFICATE

I HEREBY DECLARE THAT THE POSITION OF ALL THE
VISIBLE EXISTING IMPROVEMENTS SHOWN ON THE
ABOVE DESCRIBED PROPERTY HAVE BEEN ESTABLISHED
BY PROPER FIELD METHODS. REFERENCES PLAT BK. PLAT. NO. CMP 3884 CENTRAL MARYLAND SURVEYORS 4315 Northview Drive (381) 262-2500 FAX (301) 262-9878 Bowle, MD 20716 LIBER DATES: SCALE: 1"=80" WALL CHECK: DRAWN BY: GOS **FOLIO** GARY DEAN SIMPSON Reg. WARYLAND RLS. No. 514 HSE. LOC .: 08-16-92 JOB NO: 2583-92 BOUNDARY: