DEPARTMENT OF INSPECTIONS, LICENSES AND PERMITS 3430 COURT HOUSE DRIVE ELLICOTT CITY, MO 21043 PERMITS (410) 313-2455 INSPECTIONS (410) 313-1810

Distribution of Copies-T:Yorme/PERMIT.FRM White: Building Official Green: LDD, DPZ

HOWARD COUNTY PERMIT APPLICATION

PERMIT	NUMBER
I F-I ZIAII I	110mb


Pinic Health

Gold: SHA

Rev. 11/4//04

Yellow: DED, DPZ

AUTOMATED NEORMATION (410) 313-3800	PERMIT API	PLICATION 180800011	9
Building Address 2930 Suv	nmer HIID	Property Owner's NameCark	Case
West FriendshipMD21012		Address 2930 Summer Hill D	
Suite/Apt. #: SDP/WP/Petition #:		city W. Friendship state	10 = 01 21ALD
Census TractSubdivision		• • • • • • • • • • • • • • • • • • •	
Section Area Lot		Home Phone 4/637/16/4 Work Phone	
Tax Map Parcel Grid		Karen Klayman	
Zoning Map Coordinates Lot size		Phone410 Sc7 770 S Fax	
Existing Use			
Proposed Use		CO ANTHONY & SYLVAN POOLS	
Description of Work 30 X 50' Inground gunte		556-E Ritchie Highway Severna Park, Md, 21146	
pool, lence by owner, filled by		Ad Severna Park, Md. 21146	
Arveh, Lepth 3'to9'		Cit M.H.I.C. 19347	
		Pt 125678	
Occupant or Tenant		Engineer or Architect Company	
Contact Name		Contact Person	
Address		Address	
City State Zip Code			
Phone Fax		City State	Zip Code
		Phone Fax	
BUILDING DESCRIPTION - COMMERCIAL		BUILDING DESCRIPTION - RESIDENTIAL	
Building Characteristics	<u>Utilities</u>	Building Characteristics	<u>Utilities</u>
Height:	Water Supply:Public	SF Dwelling SF Townhouse Depth Width	Water Supply: Public
No. of stories:	Private Sewage Disposal:	1st floor: 2nd floor:	Sewage Disposal:
Gross area, sq. ft. per floor:	Public Private	Basement:	Private
Use group:	Electric Yes □ No □	Finished Basement \(\text{\tin}\text{\texi}\text{\text{\text{\text{\texit{\text{\texi}\text{\texicr{\text{\texi}\text{\text{\texi}\tittt{\text{\texit{\text{\text{\texit{\text{\texi}\text{\tex	Electric Yes I No II Gas Yes II No II
SSS group.	1	Height: Multi-family dwellings: No. of efficiency units:	Heating System:
Construction type:	Heating System: Electric □ Oil □	No. of 1 BR units: No. of 2 BR units:	Electric Oil Natural Gas
Reinforced Concrete Structural Steel	Natural Gas □ Propane Gas □	No. of 3 BR units:	Propane Gas
Masonry Wood Frame	Sprinkler system: N/A 🗆	Other Structure: Dimensions:	Sprinkler system: N/A NFPA #13D
	Full Partial	Footings:Roof Height:	NFPA #13R Other:
State Certified Modular	Other Suppression # of Heads	State Certified Modular Manufactured Home	
HOWARD COUNTY WHICH ARE APPLICABLE THERETO; (4) THAT HE	SHE WILL PERFORM NO WORK ON THE ABOVE REFE	PLICATION; (2) THAT THE INFORMATION IS CORRECT; (3) THAT HE/SHE INFORMATION TO SPECIFICALLY DESCRIBED IN THIS APPLICATION.	
THE RIGHT TO ENTER ONTO THIS PROPERTY FOR THE PURPOSE OF	INSPECTING THE WORK PERMITTED AND POSTING I	Karen Klayn	104
Applicant's Signature		Print Name	
Title/Company		Date	
		F FINANCE OF HOWARD COUNTY EATLY AND LEGIBLY. **	
AGENCY DATE	- FOR OFFI SIGNATURE APPROVAL	CE USE ONLY - DPZ SETBACK INFORMATION	PROPERTY ID#.
Land Development, DPZ	Sangaraka (1908-1908) dan kacamatan basar kacamatan basar kacamatan basar kacamatan basar kacamatan basar kacam Kacamatan basar kacamatan basar kacamatan basar kacamatan basar kacamatan basar kacamatan basar kacamatan basa	Front: Film	g fee <u>\$</u>
State Highways Building Official		Keer:	mit fee S <u>.</u> ise tex 5
Dev. Engineering, DPZ		Side St.: Add	Piper, fee \$
Health 1/14/08 2. Fire Protection	capa. X		FAL FEES \$
Is Sediment Control approval required prior to issuance?		ls Entrance Permit required? Bala	ince due \$
YES D NO D		YES NO Che Historic District? Val	ick (see en ee # <u>ee en ee ee</u> datton
CONTINGENCY CONSTRUCTION START: ONE STOP SHOP:		YES D NO D	
		Lot Coverage for NewTown Zone	Accepted by

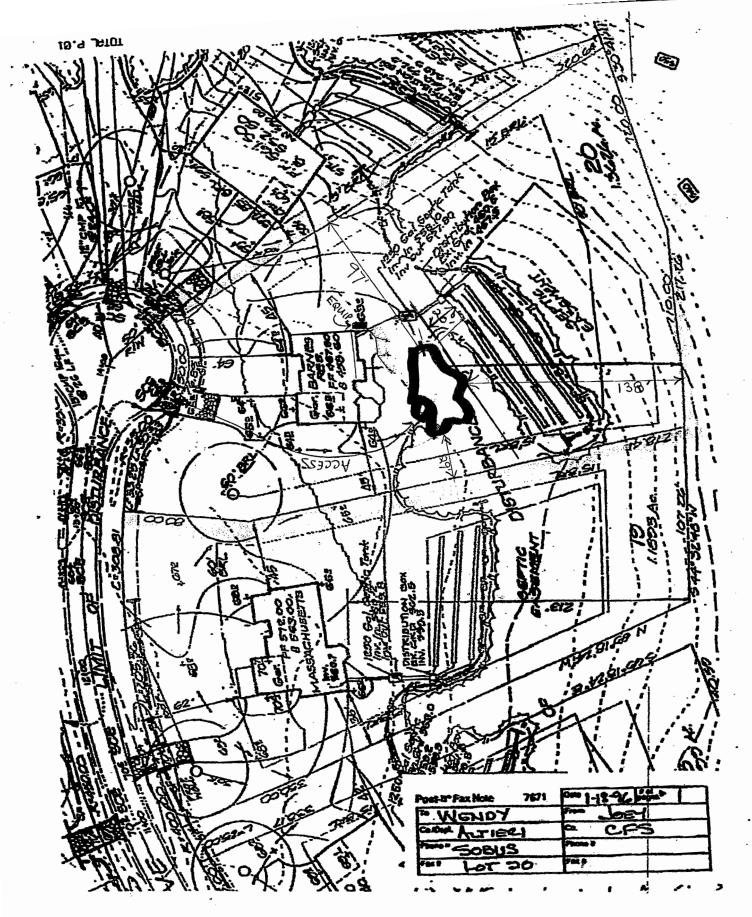

APPROVED

WALK-THRU BUILDING PERMIT

BP#_B08000[]Q A#_A56973A

APP. SAN GAC DATE: 1/14/08

DESC. OF WORK: pool inground

