

MARYLAND DEPARTMENT OF THE ENVIRONMENT, WATER MANAGEMENT ADMINISTRATION
1800 Washington Blvd., Baltimore, Maryland 21230 (410) 537-3784

WATER WELL ABANDONMENT-SEALING REPORT FORM

SUBMIT COPIES OF COMPLETED FORM TO:

- * COUNTY ENVIRONMENTAL AGENCY (contact MDE, WMA if address needed)
- * WELL OWNER
- * MDE, WATER MANAGEMENT ADMINISTRATION, WELL PROGRAM

DATE WELL ABANDONED: 10-19-21 (month/day/year)

* PERMIT NUMBER OF ABANDONED WELL (if any) None

* PERMIT NUMBER OF REPLACEMENT WELL:

* PERSON ABANDONING WELL: Andrew Houseman WELL DRILLER'S LICENSE NUMBER: 224

* OWNER'S NAME: Howard County Park + Rec CIRCLE: MWD / MSD / MGD

* WELL LOCATION:

COUNTY: Howard

NEAREST TOWN: Mariottsville

TAX MAP 0010 BLOCK 0019 PARCEL 0015

SUBDIVISION: Shipley's Choice


SECTION: LOT: Parcel B

STREET ADDRESS: 12195 Old Frederick Rd

LATITUDE 3 9.318633

LONGITUDE 7 6.935540

SITE LOCATION MAP

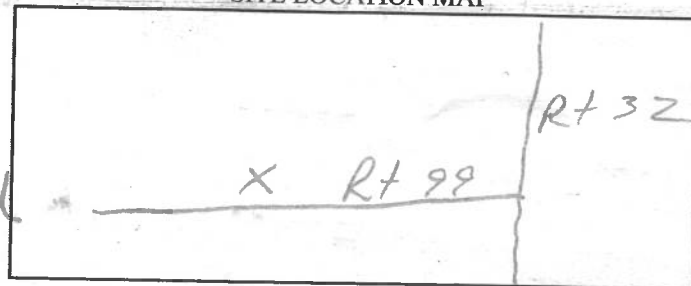

LOG OF SEALING MATERIAL

MATERIAL	FEET	
	FROM	TO
Stone	27	6
Concrete	6	1
VOLUME OF MATERIAL USED		
Stone 10 tons Concrete 2.5 yds		

* TYPE OF WELL BEING ABANDONED:

 DRILLED JETTED
 BORED HAND DUG
 OTHER (specify)

* USE CODE:

 DOMESTIC MUNICIPAL/PUBLIC
 IRRIGATION INDUSTRIAL
 TEST/OBSERVATION GEOTHERMAL

* TYPE OF CASING:

 STEEL PLASTIC
 CONCRETE OTHER (specify)

SIZE OF CASING: 3.5 INCHES IN DIAMETER

DEPTH OF WELL: 27 FEET DEEP

WAS ANY CASING REMOVED? YES NO

If yes, length removed, in feet:

WAS CASING RIPPED OR PERFORATED? YES NO

SIGNATURE-MASTER WELL DRILLER OR SUPERVISING SANITARIAN LICENSE#

COUNTY

Pursuant to § 10-624 of the State Govt. Article of the Maryland Code, personal info requested on this form is used in processing this form pursuant to COMAR 26.04.04. Failure to provide the info may result in this form not being processed. You have the right to inspect, amend, or correct this form. The Maryland Department of the Environment is subject to the Maryland Public Information Act. This form may be made available on the Internet via MDE's website and is subject to inspection or copying, in whole or in part, by the public and other governmental agencies, if not protected by federal or State Law.

CIRCLE ONE MWD / MSD / MGS

DATE 10-19-21

Real Property Data Search (w2)

Search Result for HOWARD COUNTY

View Map		View GroundRent Redemption		View GroundRent Registration	
Special Tax Recapture: None					
Account Identifier:		District - 03 Account Number - 295885			
Owner Information					
Owner Name:	HOWARD COUNTY MARYLAND DEPT OF PUBLIC WORKS		Use:	EXEMPT	
Mailing Address:	3430 COURT HOUSE DR ELLCOTT CITY MD 21043-		Principal Residence:	NO	
			Deed Reference:	/19549/ 00203	
Location & Structure Information					
Premises Address:	12195 OLD FREDERICK RD MARRIOTTSVILLE 21104-0000		Legal Description:	PAR B 11.3175 A. & IMPS 12195 OLD FREDERICK RD SHIPLEYS CHOICE	
Map:	Grid:	Parcel:	Neighborhood:	Subdivision:	Section:
0010	0019	0015	3010104.14	0004	
					Block:
					Lot:
					Assessment Year:
					Plat No:
					Plat Ref:
Town: None					
Primary Structure Built		Above Grade Living Area		Finished Basement Area	
1915		1,750 SF		11.3175 AC	
Stories	Basement	Type	Exterior	Quality	Full/Half Bath
2	YES	STANDARD UNIT	ASBESTOS SHINGLE/	4	1 full
					Garage
					Last Notice of Major Improvements
Value Information					
	Base Value		Value		Phase-in Assessments
			As of		As of
			01/01/2019		07/01/2021
					As of
					07/01/2022
Land:	474,500		474,500		
Improvements	126,700		126,700		
Total:	601,200		601,200		601,200
Preferential Land:	0				
Transfer Information					
Seller: COLES CHARLES M JR		Date: 07/21/2020		Price: \$984,000	
Type: NON-ARMS LENGTH OTHER		Deed1: /19549/ 00203		Deed2:	
Seller: COLE CHARLES M JR		Date: 12/16/2019		Price: \$0	
Type: NON-ARMS LENGTH OTHER		Deed1: /19069/ 00073		Deed2:	
Seller: FISHER RUTH		Date: 11/30/2012		Price: \$0	
Type: NON-ARMS LENGTH OTHER		Deed1: /14491/ 00446		Deed2:	
Exemption Information					
Partial Exempt Assessments:	Class		07/01/2021		07/01/2022
County:	500		601,200.00		
State:	500		601,200.00		
Municipal:	500		0.00		0.00
Special Tax Recapture: None					
Homestead Application Information					
Homestead Application Status: No Application					
Homeowners' Tax Credit Application Information					
Homeowners' Tax Credit Application Status: No Application			Date:		

1. This screen allows you to search the Real Property database and display property records.