

MARYLAND DEPARTMENT OF THE ENVIRONMENT, WATER MANAGEMENT ADMINISTRATION
1800 Washington Blvd., Baltimore, Maryland 21230 (410) 537-3784

WATER WELL ABANDONMENT-SEALING REPORT FORM

SUBMIT COPIES OF COMPLETED FORM TO:

- * COUNTY ENVIRONMENTAL AGENCY (contact MDE, WMA if address needed)
- * WELL OWNER
- * MDE, WATER MANAGEMENT ADMINISTRATION, WELL PROGRAM

DATE WELL ABANDONED: 9/8/21 (month/day/year)

* PERMIT NUMBER OF ABANDONED WELL (if any)

* PERMIT NUMBER OF REPLACEMENT WELL:

* PERSON ABANDONING WELL: Andrew Houseman WELL DRILLER'S LICENSE NUMBER: 224

CIRCLE: MWD / MSD / MGD

* OWNER'S NAME: Kendi Joshua

* WELL LOCATION:

COUNTY: Howard

NEAREST TOWN: Eikridge

TAX MAP 0043 BLOCK 0006 PARCEL 0311

SUBDIVISION: Lennox Park


SECTION: 237 LOT: 237

STREET ADDRESS: 6909 Linden Ave

LATITUDE 3 9.177460

LONGITUDE 7 6.749026

SITE LOCATION MAP

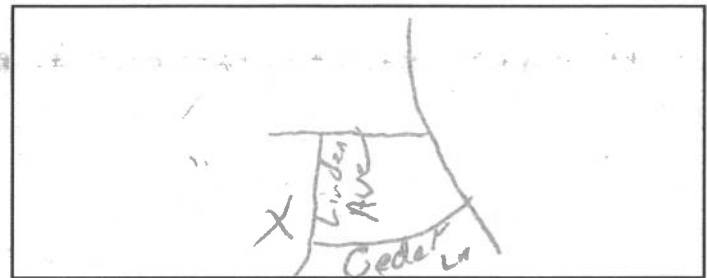

LOG OF SEALING MATERIAL

MATERIAL	FEET	
	FROM	TO
<u>Stone</u>	<u>2.5</u>	<u>6</u>
<u>Cement</u>	<u>6</u>	<u>1</u>

VOLUME OF MATERIAL USED

Stone 6 yds Cement 3 1/4 yds

* TYPE OF WELL BEING ABANDONED:

- ☐ DRILLED ☐ JETTED
- ☐ BORED ☒ HAND DUG
- ☐ OTHER (specify) _____

* USE CODE:

- ☒ DOMESTIC ☐ MUNICIPAL/PUBLIC
- ☐ IRRIGATION ☐ INDUSTRIAL
- ☐ TEST/OBSERVATION ☐ GEOTHERMAL

* TYPE OF CASING:

- ☐ STEEL ☐ PLASTIC
- ☒ CONCRETE ☐ OTHER (specify) _____

SIZE OF CASING: 3.5" INCHES IN DIAMETER

DEPTH OF WELL: 2.5 FEET DEEP

WAS ANY CASING REMOVED? ☐ YES ☒ NO

If yes, length removed, in feet: _____

WAS CASING RIPPED OR PERFORATED? ☐ YES ☒ NO

SIGNATURE-MASTER WELL DRILLER OR SUPERVISING SANITARIAN Andrew Houseman LICENSE# 224

MWD / MSD / MGS 9-8-21
CIRCLE ONE DATE

COUNTY

Pursuant to § 10-624 of the State Govt. Article of the Maryland Code, personal info requested on this form is used in processing this form pursuant to COMAR 26.04.04. Failure to provide the info may result in this form not being processed. You have the right to inspect, amend, or correct this form. The Maryland Department of the Environment is subject to the Maryland Public Information Act. This form may be made available on the Internet via MDE's website and is subject to inspection or copying, in whole or in part, by the public and other governmental agencies, if not protected by federal or State Law.

Real Property Data Search (w2)

Search Result for HOWARD COUNTY

View Map	View GroundRent Redemption	View GroundRent Registration
Special Tax Recapture: None		
Account Identifier: District - 01 Account Number - 166603		
Owner Information		
Owner Name:	JOSHUA PROPERTIES LLC	Use: RESIDENTIAL
Mailing Address:	9801 LANHAM SERVERN RD UNIT 712 LANHAM MD 20703-	Principal Residence: NO Deed Reference: /18438/ 00167
Location & Structure Information		
Premises Address:	6909 LINDEN AVE ELKRIDGE 21075-0000	Legal Description: LOT 237 6909 LINDEN AVE LENNOX PARK
Map: 0043	Grid: 0006	Parcel: 0311
Neighborhood: 1020202.14	Subdivision: 2002	Section:
Block:	Lot: 237	Assessment Year: 2021
Plat No:	Plat Ref:	
Town: None		
Primary Structure Built 1908	Above Grade Living Area 1,456 SF	Finished Basement Area 6,000 SF
Property Land Area 6,000 SF	County Use	
Stories 2	Basement YES	Type STANDARD UNIT
Exterior SIDING/	Quality 4	Full/Half Bath 3 full/ 1 half
Garage	Last Notice of Major Improvements	
Value Information		
	Base Value	Value
		As of 01/01/2021
		As of 07/01/2021
		As of 07/01/2022
Land:	121,000	139,500
Improvements	92,400	175,100
Total:	213,400	314,600
Preferential Land:	0	0
		247,133
		280,867
Transfer Information		
Seller: TEGGES N KENNETH JR	Date: 11/05/2018	Price: \$105,000
Type: NON-ARMS LENGTH OTHER	Deed1: /18438/ 00167	Deed2:
Seller: TEGGES PATRICIA ANN	Date: 06/30/2005	Price: \$0
Type: NON-ARMS LENGTH OTHER	Deed1: /00000/ 00000	Deed2:
Seller: GEORGE RUBY LEE	Date: 04/21/2004	Price: \$0
Type: NON-ARMS LENGTH OTHER	Deed1: /08246/ 00252	Deed2:
Exemption Information		
Partial Exempt Assessments:	Class	07/01/2021
County:	000	0.00
State:	000	0.00
Municipal:	000	0.00 0.00
Special Tax Recapture: None		
Homestead Application Information		
Homestead Application Status: No Application		
Homeowners' Tax Credit Application Information		
Homeowners' Tax Credit Application Status: No Application		
Date:		

1. This screen allows you to search the Real Property database and display property records.
2. Click [here](#) for a glossary of terms.