

MARYLAND DEPARTMENT OF THE ENVIRONMENT, WATER MANAGEMENT ADMINISTRATION
1800 Washington Blvd., Baltimore, Maryland 21230 (410) 537-3784

WATER WELL ABANDONMENT-SEALING REPORT FORM

SUBMIT COPIES OF COMPLETED FORM TO:

- * COUNTY ENVIRONMENTAL AGENCY (contact MDE, WMA if address needed)
- * WELL OWNER
- * MDE, WATER MANAGEMENT ADMINISTRATION, WELL PROGRAM

APPROVED
10/26/2021 *[Signature]*

DATE WELL ABANDONED: 9-16-21 (month/day/year)

* PERMIT NUMBER OF ABANDONED WELL (if any) _____

* PERMIT NUMBER OF REPLACEMENT WELL: _____


* PERSON ABANDONING WELL: John Greer WELL DRILLER'S LICENSE NUMBER: 086

CIRCLE: MWD / MSD / MGD

* OWNER'S NAME: MLT MAPLELAWN LLC

SITE LOCATION MAP

* WELL LOCATION:
COUNTY: Howard County
NEAREST TOWN: FULTON
TAX MAP _____ BLOCK _____ PARCEL _____
SUBDIVISION: _____
SECTION: _____ LOT: _____
STREET ADDRESS: 11475 South Maryland 216

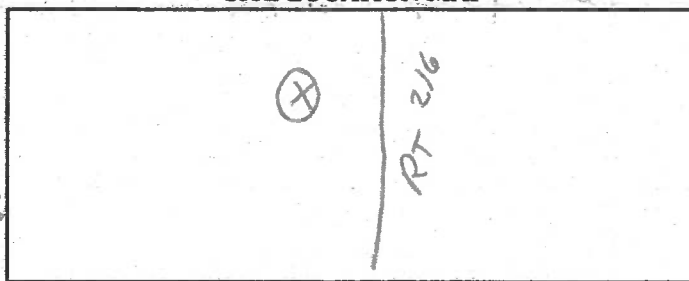

LATITUDE 3 9.144561

LONGITUDE 7 6.896512

LOG OF SEALING MATERIAL

MATERIAL	FEET	
	FROM	TO
Bentonite CLAY	85	1
Backfill	1	—
VOLUME OF MATERIAL USED		
600 LBS OF Bentonite Clay		

* TYPE OF WELL BEING ABANDONED:

☒ DRILLED ☐ JETTED
☐ BORED ☐ HAND DUG
☐ OTHER (specify) _____

* USE CODE:

☒ DOMESTIC ☐ MUNICIPAL/PUBLIC
☐ IRRIGATION ☐ INDUSTRIAL
☐ TEST/OBSERVATION ☐ GEOTHERMAL

* TYPE OF CASING:

☒ STEEL ☐ PLASTIC
☐ CONCRETE ☐ OTHER (specify) _____

SIZE OF CASING: 6 INCHES IN DIAMETER

DEPTH OF WELL: 85 FEET DEEP

WAS ANY CASING REMOVED? ☒ YES ☐ NO

If yes, length removed, in feet: 2

WAS CASING RIPPED OR PERFORATED? ☐ YES ☒ NO

Pursuant to § 10-624 of the State Govt. Article of the Maryland Code, personal info requested on this form is used in processing this form pursuant to COMAR 26.04.04. Failure to provide the info may result in this form not being processed. You have the right to inspect, amend, or correct this form. The Maryland Department of the Environment is subject to the Maryland Public Information Act. This form may be made available on the Internet via MDE's website and is subject to inspection or copying, in whole or in part, by the public and other governmental agencies, if not protected by federal or State Law.

SIGNATURE-MASTER WELL DRILLER OR SUPERVISING SANITARIAN LICENSE#

086 MWD / MSD / MGS

DATE

9-17-21

COUNTY

Real Property Data Search (w2)

Search Result for HOWARD COUNTY

View Map		View GroundRent Redemption		View GroundRent Registration	
Special Tax Recapture: None					
Account Identifier:		District - 05 Account Number - 342260			
Owner Information					
Owner Name:		MLT MAPLE LAWN LLC		Use:	RESIDENTIAL
Mailing Address:		1202 SHADY CREEK RD MARRIOTTSTVILLE MD 21104-		Principal Residence:	NO
				Deed Reference:	/18909/ 00397
Location & Structure Information					
Premises Address:		11475 ROUTE 216 FULTON 20759-2205		Legal Description:	3.718 A 11475 ROUTE 216 FULTON
Map:	Grid:	Parcel:	Neighborhood:	Subdivision:	Section:
0046	0003	0282	5020201.14	2001	
					Block:
					Lot:
					Assessment Year:
					2020
					Plat No:
					Plat Ref:
Town: None					
Primary Structure Built		Above Grade Living Area		Finished Basement Area	
				Property Land Area	
				3.7100 AC	
Stories	Basement	Type	Exterior	Quality	Full/Half Bath
			/		
Garage					
Last Notice of Major Improvements					
Value Information					
		Base Value		Value	
				As of	
				01/01/2020	
				Phase-in Assessments	
				As of	
				07/01/2021	
				As of	
				07/01/2022	
Land:		256,800		275,300	
Improvements		0		0	
Total:		256,800		275,300	269,133
Preferential Land:		0		0	275,300
Transfer Information					
Seller: MEADOWOOD MAPLE LAWN LLC		Date: 09/25/2019		Price: \$0	
Type: NON-ARMS LENGTH OTHER		Deed1: /18909/ 00397		Deed2:	
Seller: BOSLEY MARVIN F		Date: 11/03/2017		Price: \$2,000,000	
Type: NON-ARMS LENGTH OTHER		Deed1: /17901/ 00299		Deed2:	
Seller: ALMQUIST LORETTA ETAL		Date: 04/10/1984		Price: \$132,000	
Type: ARMS LENGTH IMPROVED		Deed1: /01241/ 00138		Deed2:	
Exemption Information					
Partial Exempt Assessments:		Class		07/01/2021	
County:		000		0.00	
State:		000		0.00	
Municipal:		000		0.00 0.00	
				0.00 0.00	
Special Tax Recapture: None					
Homestead Application Information					
Homestead Application Status: No Application					
Homeowners' Tax Credit Application Information					
Homeowners' Tax Credit Application Status: No Application				Date:	

1. This screen allows you to search the Real Property database and display property records.
2. Click [here](#) for a glossary of terms.
3. Deleted accounts can only be selected by Property Account Identifier.