

MARYLAND DEPARTMENT OF THE ENVIRONMENT, WATER MANAGEMENT ADMINISTRATION
1800 Washington Blvd., Baltimore, Maryland 21230 (410) 537-3784

WATER WELL ABANDONMENT-SEALING REPORT FORM

SUBMIT COPIES OF COMPLETED FORM TO:

- * COUNTY ENVIRONMENTAL AGENCY (contact MDE, WMA if address needed)
- * WELL OWNER
- * MDE, WATER MANAGEMENT ADMINISTRATION, WELL PROGRAM

DATE WELL ABANDONED: 12-19-19 (month/day/year)

* PERMIT NUMBER OF ABANDONED WELL (if any)

HO - 73 - 3014

* PERMIT NUMBER OF REPLACEMENT WELL:

- N/A -

* PERSON ABANDONING WELL: Allen Compton

WELL DRILLER'S LICENSE NUMBER:

CIRCLE: MWD / MSD / MGD

* OWNER'S NAME: Trinity Homes

SITE LOCATION MAP

* WELL LOCATION:

COUNTY: Howard


NEAREST TOWN: Laurel

TAX MAP 0050 BLOCK 0002 PARCEL 0100

SUBDIVISION:

SECTION: LOT:

STREET ADDRESS: 9438 Old Scaggsville Rd

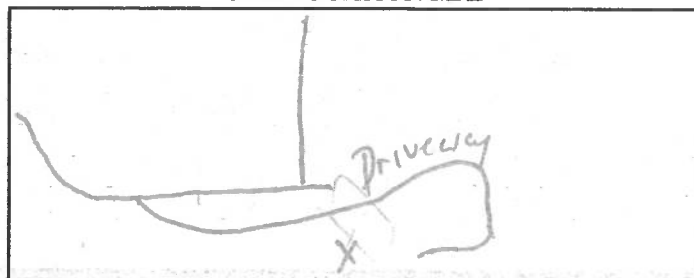

LATITUDE 39.112185

LONGITUDE 76.857482

LOG OF SEALING MATERIAL

* TYPE OF WELL BEING ABANDONED:

☒ DRILLED ☐ JETTED
☐ BORED ☐ HAND DUG
☐ OTHER (specify) _____

* USE CODE:

☒ DOMESTIC ☐ MUNICIPAL/PUBLIC
☐ IRRIGATION ☐ INDUSTRIAL
☐ TEST/OBSERVATION ☐ GEOTHERMAL

* TYPE OF CASING:

☒ STEEL ☐ PLASTIC
☐ CONCRETE ☐ OTHER (specify) _____

| MATERIAL | FEET | |
|-------------------------|------|-----|
| | FROM | TO |
| Bentonite | 0 | 110 |
| VOLUME OF MATERIAL USED | | |
| 11 bags | | |

SIZE OF CASING: 6 INCHES IN DIAMETER

DEPTH OF WELL: 700 FEET DEEP

WAS ANY CASING REMOVED? YES NO

If yes, length removed, in feet: 2'

WAS CASING RIPPED OR PERFORATED? YES NO

SIGNATURE-MASTER WELL DRILLER OR SUPERVISING SANITARIAN LICENSE#

MWD / MSD / MGS

CIRCLE ONE

DATE

COUNTY

Pursuant to § 10-624 of the State Govt. Article of the Maryland Code, personal info requested on this form is used in processing this form pursuant to COMAR 26.04.04. Failure to provide the info may result in this form not being processed. You have the right to inspect, amend, or correct this form. The Maryland Department of the Environment is subject to the Maryland Public Information Act. This form may be made available on the Internet via MDE's website and is subject to inspection or copying, in whole or in part, by the public and other governmental agencies, if not protected by federal or State Law.

Search Result for HOWARD COUNTY

| View Map | | View GroundRent Redemption | | View GroundRent Registration | |
|---|--|---------------------------------------|---------------|------------------------------|---|
| Special Tax Recapture: None | | | | | |
| Account Identifier: | | District - 06 Account Number - 393926 | | | |
| Owner Information | | | | | |
| Owner Name: | FALCON PLACE HOMEOWNERS ASSOCIATION INC | | | Use: Principal Residence: | RESIDENTIAL NO |
| Mailing Address: | 3675 PARK AVE STE 301 ELLCOTT CITY MD 21043- | | | Deed Reference: | /19285/ 00093 |
| Location & Structure Information | | | | | |
| Premises Address: | CLOVIS PL LAUREL 20723-0000 | | | Legal Description: | LOT 11 2.2282 A. OPEN SPACE HOA CLOVIS PL FALCON PLACE |
| Map: | Grid: | Parcel: | Neighborhood: | Subdivision: | Section: |
| 0050 | 0002 | 0100 | 6020202.14 | 2217 | |
| | | | | | Block: |
| | | | | | 11 |
| | | | | | Lot: |
| | | | | | 2020 |
| | | | | | Assessment Year: |
| | | | | | Plat No: |
| | | | | | Plat Ref: |
| Town: None | | | | | |
| Primary Structure Built | | Above Grade Living Area | | Finished Basement Area | |
| | | | | Property Land Area | |
| | | | | 2.2282 AC | |
| County Use | | | | | |
| Stories | Basement | Type | Exterior | Quality | Full/Half Bath |
| | | | / | | |
| Garage | | | | | |
| Last Notice of Major Improvements | | | | | |
| Value Information | | | | | |
| | | Base Value | | Value | |
| | | | | As of | |
| | | | | 01/01/2020 | |
| | | | | Phase-in Assessments | |
| | | | | As of | |
| | | | | 07/01/2021 | |
| | | | | As of | |
| | | | | 07/01/2022 | |
| Land: | | 0 | | 0 | |
| Improvements | | 0 | | 0 | |
| Total: | | 0 | | 0 | 0 |
| Preferential Land: | | 0 | | 0 | 0 |
| Transfer Information | | | | | |
| Seller: MAGNOLIA MANOR LLC | | Date: 04/09/2020 | | Price: \$0 | |
| Type: NON-ARMS LENGTH OTHER | | Deed1: /19285/ 00093 | | Deed2: | |
| Seller: GIDDINGS NORMAN E | | Date: 11/21/2019 | | Price: \$475,000 | |
| Type: NON-ARMS LENGTH OTHER | | Deed1: /19028/ 00257 | | Deed2: | |
| Seller: NORMAN EDWARD GIDDINGS | | Date: 02/17/2016 | | Price: \$0 | |
| Type: NON-ARMS LENGTH OTHER | | Deed1: /16697/ 00114 | | Deed2: | |
| Exemption Information | | | | | |
| Partial Exempt Assessments: | Class | | | 07/01/2021 | 07/01/2022 |
| County: | 000 | | | 0.00 | |
| State: | 000 | | | 0.00 | |
| Municipal: | 000 | | | 0.00 0.00 | 0.00 0.00 |
| Special Tax Recapture: None | | | | | |
| Homestead Application Information | | | | | |
| Homestead Application Status: No Application | | | | | |
| Homeowners' Tax Credit Application Information | | | | | |
| Homeowners' Tax Credit Application Status: No Application | | | | | |
| Date: | | | | | |