

P 32634
A 29160

PERMIT

SEWAGE DISPOSAL SYSTEM

MARYLAND STATE DEPARTMENT OF HEALTH

HOWARD COUNTY
BUREAU OF ENVIRONMENTAL HEALTH
992-2330

03-307867

INDEX

ELLICOTT CITY
DISTRICT 3rd.

DATE 4/7/83

Dick Larrick IS PERMITTED TO INSTALL X ALTER

ADDRESS PHONE 795-6807

SUBDIVISION Sunset Valley ROAD 915 Sunset Valley Dr. LOT 2, Section 1

PROPERTY OWNER Daniel R. Ennis
2803 Chenoak Avenue

ADDRESS Baltimore, Maryland 21234

IF GARBAGE GRINDER IS USED INCREASE SEPTIC TANK CAPACITY BY 50% AND ABSORPTION AREA BY 22%.

GARBAGE GRINDER? YES NO X

SEPTIC TANK CAPACITY 1000 GALLONS NUMBER OF BEDROOMS 3

207
13
57627
125

TRENCHES - 209 sq.ft. per bedroom. Minimum total sq.ft. is 627 sq. ft. of absorbant side-wall area. Trench to be 2 ft. wide. Inlet 4 1/4 ft. below original grade. Maximum depth 9 1/4 ft. below original grade. Effective area begins at 4 1/4 ft. below original grade. 5 ft. of stone below distribution pipe. NOTE: (1) no trench to exceed 100 ft. in length, (2) If more than one trench used, a distribution box is required (3) Trenches to be installed on level ground. LOCATION: Start the first trench 60 feet from the front lot line and 75 feet from the left side line, as seen when facing the lot from Sunset Valley Drive. Continue to dig trench on level ground towards the left side of lot. Space parallel trenches 10 feet apart. Call for inspection of trench(es) before gravel is installed.

**BUILDING PERMIT SIGNED
AND RETURNED**

32305 B00152815 - FAMILY ROOM
5-1205 B00153718 - 16 POOL

BLDG. PERMIT SIGNED
AND RETURNED 8/21/96
Serial # B00101917
1-Story addition
M. Ben + M. Barb.

BLDG. PERMIT SIGNED
AND RETURNED 11/30/93
Serial # 57431
family room
DATE 1/5/83

PLANS APPROVED BY Frank Skinner

COVER NO WORK UNTIL INSPECTED AND APPROVED.

NEITHER THE HOWARD COUNTY COUNCIL NOR THE HEALTH DEPARTMENT IS RESPONSIBLE FOR THE SUCCESSFUL OPERATION OF ANY SYSTEM.

NOTE: IF TRENCH IS USED CALL FOR INSPECTION BEFORE AND AFTER PLACING GRAVEL IN TRENCH.

NOTE: NO DRY WELL SHALL EXCEED 15 FOOT IN DIAMETER. NO ABSORPTION TRENCH TO EXCEED 100 FEET IN LENGTH.

NOTE: ALL PIPE FROM HOUSE TO SEPTIC TANK MUST BE CAST IRON OR SCHEDULE 40 PVC OR ABS.

PERMIT VOID AFTER THREE YEARS.

NOTE: INSTALL STAND PIPE ON SEPTIC TANK AND DRY WELL. STAND PIPES MUST BE 6 INCHES IN DIAMETER. CAST IRON, CONCRETE OR TERRA COTTA, OR PVC OR ABS ACCEPTED, IF TOP OF SEPTIC TANK IS DEEPER THAN 3 FEET MANHOLE TO GRADE REQUIRED.

***INSTALLER IS RESPONSIBLE FOR OBTAINING FINAL APPROVAL ON THIS PERMIT**

*CALL 992-2330 FOR INSPECTION OF SEPTIC SYSTEMS.

EH - 2-1082

A
29160

250	50	100	150	200	250
200					200
150					150
100					100
50					50

INDICATE NORTH. — NAME ADJOINING ROADWAY AS BASE LINE.

PERMIT CARD _____

SEPTIC TANK, LEVEL _____

CLEANOUTS _____

DISTRIBUTION BOX, LEVEL _____

TILE FIELD, DEPTH _____ FT. TRENCH WIDTH _____ FT.

GRAVEL DEPTH _____ IN. TOTAL LENGTH _____ FT.

NUMBER OF TRENCHES _____ TOTAL BOTTOM AREA _____

SEEPAGE PITS, INSIDE DIAMETER _____ FT. DEPTH BELOW INLET _____ FT.

ABSORBENT AREA _____ SQ. FT.

REMARKS *See other sheet* _____

DATE SYSTEM APPROVED _____ INSPECTOR _____

3/30/83
perm

approved 4/21/83
Stayer

PERMIT

SEWAGE DISPOSAL SYSTEM

MARYLAND STATE DEPARTMENT OF HEALTH*

HOWARD COUNTY

BUREAU OF ENVIRONMENTAL HEALTH
992-2330

ELLICOTT CITY

DISTRICT _____

DATE _____

_____ IS PERMITTED TO INSTALL _____ ALTER _____

ADDRESS _____ PHONE _____

SUBDIVISION SUNSET VALLEY ROAD _____ LOT 2

PROPERTY OWNER DANIEL ENNIS

ADDRESS 2803 CHENOWETH AVE. BALT. 661-6205

IF GARBAGE GRINDER IS USED INCREASE SEPTIC TANK CAPACITY BY 50% AND ABSORPTION AREA BY 22%.

GARBAGE GRINDER? YES _____ NO _____

SEPTIC TANK CAPACITY _____ GALLONS NUMBER OF BEDROOMS _____

PLANS APPROVED BY _____ DATE _____

COVER NO WORK UNTIL INSPECTED AND APPROVED.

NEITHER THE HOWARD COUNTY COUNCIL NOR THE HEALTH DEPARTMENT IS RESPONSIBLE FOR THE SUCCESSFUL OPERATION OF ANY SYSTEM.

NOTE: IF TRENCH IS USED CALL FOR INSPECTION BEFORE AND AFTER PLACING GRAVEL IN TRENCH.

NOTE: NO DRY WELL SHALL EXCEED 15 FOOT IN DIAMETER. NO ABSORPTION TRENCH TO EXCEED 100 FEET IN LENGTH.

NOTE: ALL PIPE FROM HOUSE TO SEPTIC TANK MUST BE CAST IRON OR SCHEDULE 40 PVC OR ABS.

PERMIT VOID AFTER THREE YEARS.


NOTE: INSTALL STAND PIPE ON SEPTIC TANK AND DRY WELL. STAND PIPES MUST BE 6 INCHES IN DIAMETER. CAST IRON, CONCRETE OR TERRA COTTA, OR PVC OR ABS ACCEPTED. IF TOP OF SEPTIC TANK IS DEEPER THAN 3 FEET MANHOLE TO GRADE REQUIRED.

***INSTALLER IS RESPONSIBLE FOR OBTAINING FINAL APPROVAL ON THIS PERMIT**

***CALL 992-2330 FOR INSPECTION OF SEPTIC SYSTEMS.**

EH - 2-1082

FOR THE RD

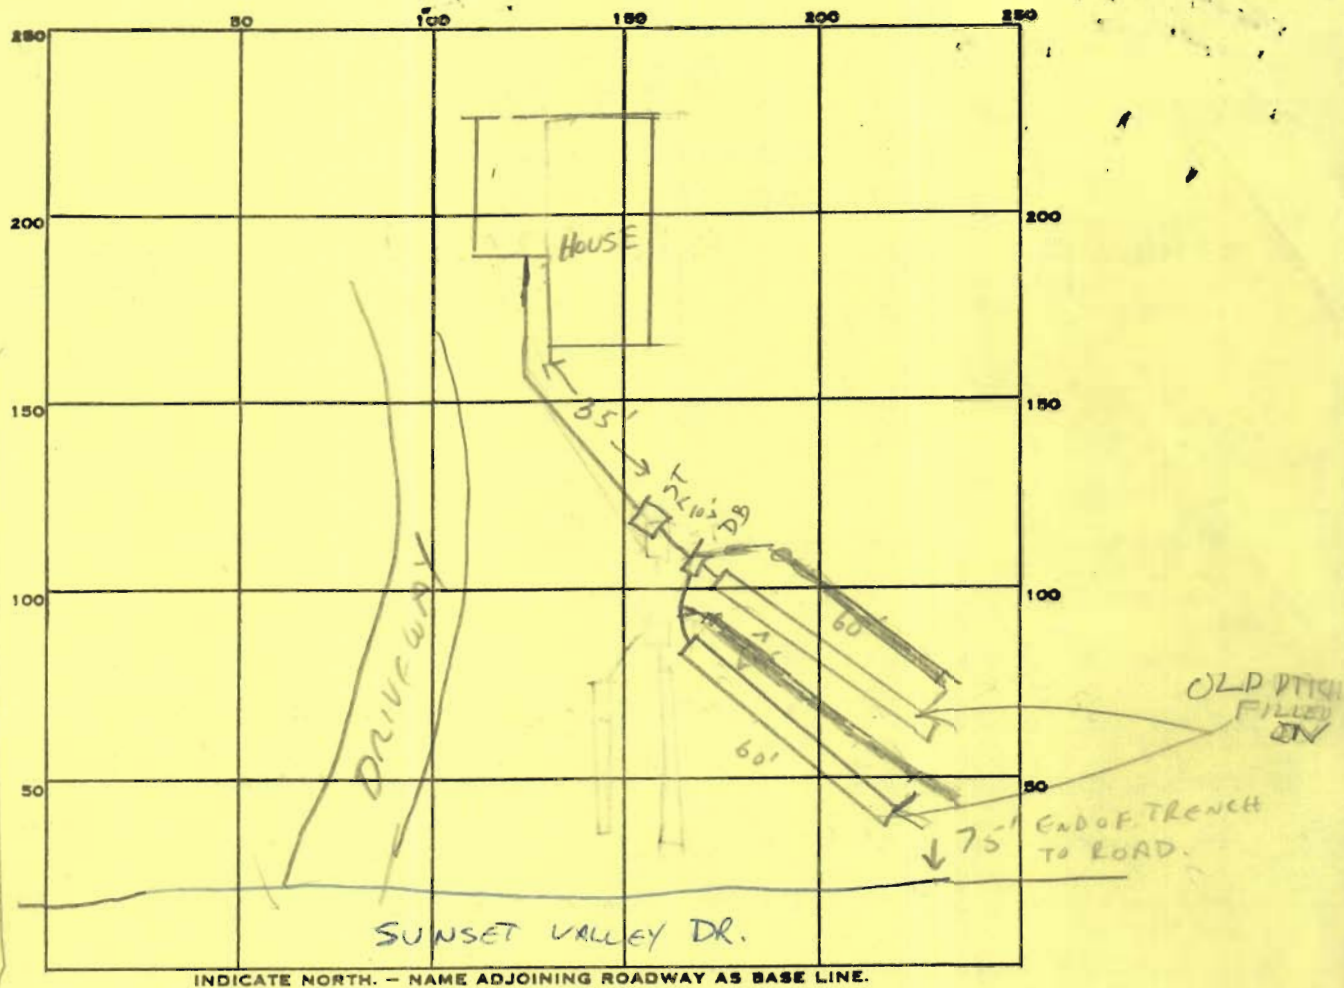

PERMIT CARD _____

SEPTIC TANK, LEVEL OK TOP LF7 B06

CLEANOUTS _____

DISTRIBUTION BOX, LEVEL ✓

TILE FIELD, DEPTH 10 1/2 FT. TRENCH WIDTH 2 FT.

GRAVEL DEPTH 5 IN. TOTAL LENGTH 70 1/2 FT.

NUMBER OF TRENCHES 2 TOTAL BOTTOM AREA 635

SEEPAGE PITS, INSIDE DIAMETER _____ FT. DEPTH BELOW INLET _____ FT.

ABSORBENT AREA 635 SQ. FT.

REMARKS _____

2 TRENCHES DUG APPROX 760 FT EACH. 9 1/2' DEEP 3-30-83 CW

★ - DIRT COLLAPSED INTO TRENCHES - NEED TO BE DUG OUT. HOUSE CONNECTION NOT VISIBLE DUE TO COLLAPSED DIRT,

TRENCHES NEED TO BE LONGER. 4-6-83 CW

NEW TRENCHES 13 FT TO 18 FT APART. OLD TRENCHES FILLED IN

ADD STONE TO DITCHES UNCOVER PART OF HOUSE SEWER NEAR HOUSE & PUT CLEANOUT ON TANK R.H. 4/21/83 OK & cover trenches. House connection OK.

DATE SYSTEM APPROVED 4/21/83

INSPECTOR Stacy

Subdivision: Sunset Valley

Lot #2, sec. 1

TRENCHES209 sq ft / bdrm

	<u>Septic Tank</u>	<u>Minimum Total Sq. ft.</u>
3 bdrm	1000 GAL.	<u>627 SQ. FT.</u>
4 bdrm	1250 GAL.	<u>836 SQ. FT.</u>
5 bdrm	1500 GAL.	<u> </u>


Trench 2 widthInlet 4 1/2 ft below original GRADEMaximum Depth 9 1/2 ft below original GRADEEffective AREA begins at 4 1/2 ft below orig. gd.5 ft of stone below distribution pipe.NOTE: ① NO TRENCH TO EXCEED 100 ft in length

② If MORE than ONE TRENCH USED, a distribution box is REQUIRED

③ TRENCHES To be installed on LEVEL ground.LOCATION: Start the first trench 60 feet from the front lotline and ~~125~~⁷⁵ feet from the left side line, as seen when facing the lot from Sunset Valley Drive. Continue to dig trench on level ground towards the left side of lot. Space parallel trenches 10 feet apart. Call for inspection of trenches before gravel is installed.

11/5/83 J. Shinn

ORIGINAL ELEV. TIME OF PERC TEST EXISTING ELEVATION	96.50 96.50
---	----------------

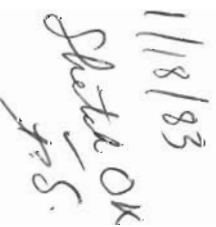

Amos E. Allen
signed.

Distribution Box 92.00

INJECT ELV. (CORR) SEPTICTANK 92.75

INVERT SW OUT OF HOUSE 93.50

HOUSE
1ST FLOOR 103.75
Basement elev 94.75

Σεμινάριο
Disposici

Sunset Valley Rd

Sunset Valley
Sun Engineering & Construction, Inc.
Sam. Eckw
875-2775

00 62
09 60
45

52
061
386

0588
70
55

REC'D
HOWARD COUNTY
HEALTH DEPT.
JUN 18 10 37 AM '87
DIVISION OF
ENVIRONMENTAL
HEALTH