DEPARTMENT OF INSPECTIONS, LICENSES AND PERMITS 3430 COURT HOUSE DRIVE ELLICOTT CITY, MO 21043 PERMITS (410) 313-485 INSPECTIONS (410) 313-1810 AUTOMATED INFORMATION (410) 313-3800

HOWARD COUNTY PERMIT APPLICATION

PERMIT NUMBER

| Building Address O D SULSET Valley Property Owner's Name Address SuiteApt. #: SDPM/P/Petition #: Census Tract Subdivision J Saction Area | 1 M a | | | 10 21 25 |
|--|--|--|--|--|
| Suite/Apt. #: SDPMP/Petition #: Census Tract Subdivision | Building Address / U.D.D. SUN | SET Valley | Property Owner's Name | 1. C. |
| Suiter/Apt. #: SDPWP/Petition #: Subdivision City | Drye Salewille | M9 31714 | Address | |
| Section Area Lot Apricant's Name & Mailing Address, (if other than stated hereon): Applicant's Name & Mailing Address, (if other than stated hereon): Applicant's Name & Mailing Address, (if other than stated hereon): Applicant's Name & Mailing Address, (if other than stated hereon): Applicant's Name & Mailing Address, (if other than stated hereon): Address Contractor Company Contact Person Orange Orange Orange Orange Contact Person Occupant or Tenant Contact Name Address City State Engineer or Architect Company Contact Person Address City State Engineer or Architect Company Contact Person Address City State Engineer or Architect Company Contact Person Address City State Engineer or Architect Company Contact Person Address City State Engineer or Architect Company Contact Person Address City State Engineer or Architect Company Contact Person Address City State Engineer or Architect Company Contact Person Address City State Engineer or Architect Company | Tax Map Parcel Grid Phone Fax Contractor Company Contact Person Josepha Josep | Census Tract Subdivision | n | City State _ | Zip Code |
| Tax Map Parcel Grid Phone Fax Contractor Company Contact Person Josepha Josep | Section Area | Lot | | |
| Contractor Company | | | Applicant's Name & Mailing Address, (if our | er than stated hereon). |
| Proposed Use Estimated Construction Cost \$ Description of Work | Zoning Map Coordinates | Lot size | Phone Fax | , _{NO.20} , Variable |
| Description of Work Address Address | Existing Use State Control of the Co | many the first of | Contractor Company | |
| Address Addr | | | Contact Person | o., |
| Covered entry Holoric Storage above City | | | 32 77 2003 | |
| City State Zip Code City State Zip Code Contact Name Contact Name Address City State Zip Code Engineer or Architect Company Contact Person Address City State Zip Code Phone Fax BUILDING DESCRIPTION - COMMERCIAL Building Characteristics Water Supply: Public Private Savage Disposal: Public Private Savage Disposal: Public Private Savage Disposal: Public Private Electric Savage Disposal: Public Private Electric Savage Disposal: Public Private Electric Oil Sasement Unfinished Basement Disposal: Public Private Electric Oil Sasement Savage Mascorry Wood Frame Sprinkler system: Electric Oil Savage Mascorry Wood Frame Sprinkler system: N/A Disposal: Propane Gas Disposal: Propan | | | Address | |
| Cocupant or Tenant Contact Name Contact Name Contact Name Contact Name Contact Name Contact Person | alta ched 2-con gara | 20 Storale above | City State | Zip Code |
| Contact Name | | 22 / 3/2 9 | License No. | |
| Contact Name | | | | <u> </u> |
| Address | | and the same of the same | | <u> </u> |
| Address City | Contact Name | | Contact Person | <u> </u> |
| Phone Fax BuilLDING DESCRIPTION - COMMERCIAL BuilLDING DESCRIPTION - RESIDENTIAL | | 7in Codo | Address | |
| Phone Fax Phone Fax Phone Fax Phone Fax | Oity State_ | Zip Code | City State | 7in Code |
| BUILDING DESCRIPTION - COMMERCIAL Building Characteristics Height: No. of stories: Gross area, sq. ft. per floor: Use group: Construction type: Reinforced Concrete Structural Steel Structural Steel Masonry Wood Frame Building Characteristics Utilities Building Characteristics Building Characteristics SF Dwelling S SF Townhouse Depth Width Ist floor: 2nd floor: Basement: Finished Basement: Finished Basement: Craw space Slab on Grade Slab on Grade Craw space Craw space Slab on Grade Craw space Craw space Slab on Grade Craw space Slab on Grade Craw space Craw space Slab on Grade Craw space Slab on Grade Craw space Craw space Slab on Grade Craw space | Phone Fax | | 16.7 | 2p code |
| Building Characteristics Building Characteristics Building Characteristics Building Characteristics Utilities Building Characteristics Utilities Water Supply: | BUILDING DESCRIPTIO | N - COMMERCIAI | | ION - PESIDENTIAL |
| Height: No. of stories: Water Supply: | | T | | |
| No. of stories: Private Sewage Disposal: | | Water Supply: | | |
| Sewage Disposal: Public Private Electric Yes □ No □ Gas Yes □ No □ Multi-family dwellings: Multi-family dwellings: Mo. of 1 BR units: Mo. of 2 BR units: Mo. of 3 BR units: Mosorry Wood Frame Sewage Disposal: Public Private Electric Yes □ No □ Gas Yes □ No □ Gas Yes □ No □ Heating System: Electric □ Oil □ No. of 2 BR units: No. of 3 BR units: Wood Frame Sprinkler system: N/A □ Full Partial Other Suppression State Certified Modular Sewage Disposal: Public Private Electric □ Private Electric □ Private Electric Yes □ No □ Gas Yes □ No □ Heating System: Electric □ Oil □ No. of 1 BR units: No. of 3 BR units: Propane Gas □ No. of 3 BR units: No. of 3 BR units | | I Public | Depth Width | |
| Gross area, sq. ft. per floor: Private | No. of stories: | | | N Private |
| Use group: Electric Yes No | No. of stories: | Private Sewage Disposal: | 1st floor: | Sewage Disposal: |
| Use group: Crawl space Slab on Grade | | Private Sewage Disposal: Public | 1st floor: 2nd floor: | Sewage Disposal: Public |
| Use group: Gas Yes No Height: Heating System: Electric Oil No. of efficiency units: No. of 1 BR units: Electric Oil Natural Gas No. of 3 BR units: No. of 4 BR units: No. of 1 BR units: No. of 2 BR units: No. of 3 BR unit | | Private Sewage Disposal: Public | 1st floor: 2nd floor: Basement: | Sewage Disposal: Public |
| Construction type: Reinforced Concrete Structural Steel Masonry Wood Frame Stract Certified Modular Heating System: Electric □ Oil □ Natural Gas □ No. of 1 BR units: No. of 2 BR units: No. of 3 BR units: No. of 1 BR units: No. of 1 BR units: No. of 2 BR units: No. of 3 BR units: No. of 2 BR units: No. of 2 BR units: No. of 3 BR units: No. of 1 BR units: No. of 2 BR units: No. of 2 BR units: No. of 3 BR units: No. of 1 BR units: No. of 2 BR units: No. of 2 BR units: No. of 3 BR units: No. of 1 BR units: No. of 2 BR units: No. of 1 BR units: No. of 1 BR units: No. of 2 BR units: No. of 1 BR units: No. of 2 BR units: No. of 1 BR units: No. of 2 BR units: No. of 3 BR units: No. of 1 BR units: No. of 2 BR units: No. of 2 BR units: No. of 1 BR units: No. of 2 BR units: No. of 3 BR units: No. of 2 BR units: No. of 3 BR uni | | Private Sewage Disposal: Public Private | 1st floor: 2nd floor: Basement: Finished Basement □ Unfinished Basement□ Crawl space □ Slab on Grade □ | Sewage Disposal: Public Private |
| Construction type: Reinforced Concrete Structural Steel Masonry Wood Frame State Certified Modular Electric Oil No. of 1 BR units: No. of 2 BR units: No. of 3 BR units: No. of 2 BR units: No. of 3 BR units: No. of 2 BR units: No. of 3 BR units: No. of 2 BR units: No. of 3 BR units: No. of 2 BR units: No. of 3 BR units: No. of 2 BR units: No. of 3 BR units: No. of 4 BR units: No. of 2 BR units: No. of 2 BR units: No. of 2 BR units: No. of 3 BR u | Gross area, sq. ft. per floor: | Private Sewage Disposal: Public Private Electric Yes No | 1st floor: 2nd floor: Basement: Finished Basement □ Unfinished Basement□ Crawl space □ Slab on Grade □ No. of Bedrooms Height: | Sewage Disposal: Public Private Electric Yes 🗅 No 🗆 |
| Reinforced Concrete Structural Steel Structural Steel Masonry Wood Frame Sprinkler system: N/A Partial Partial Other Suppression State Certified Modular No. of 3 BR units: No. of 3 B | Gross area, sq. ft. per floor: | Private Sewage Disposal: Public Private Electric Yes No Gas Yes No | 1st floor: 2nd floor: Basement: Finished Basement □ Unfinished Basement□ Crawl space □ Slab on Grade □ No. of Bedrooms Height: Multi-family dwellings: | Sewage Disposal: Public Private Electric Yes D No D Gas Yes No D |
| Structural Steel Masonry Wood Frame Sprinkler system: N/A Dimensions: Full Partial Other Suppression State Certified Modular Other Suppression State Certified Modular Other Suppression State Certified Modular | Gross area, sq. ft. per floor: Use group: Construction type: | Private Sewage Disposal: Public Private Electric Yes No Gas Yes No Heating System: | 1st floor: 2nd floor: Basement: Finished Basement □ Unfinished Basement□ Crawl space □ Slab on Grade □ No. of Bedrooms Height: Multi-farmily dwellings: No. of efficiency units: No. of 1 BR units: | Sewage Disposal: Public Private Electric Yes I No I Gas Yes No I Heating System: Electric I Oil I |
| Wood Frame Sprinkler system: N/A Dimensions: Full Partial Other Suppression # of Heads Sprinkler system: N/A Dimensions: Footings: Roof Height: State Certified Modular State Certified Modular Sprinkler system: N/A Dimensions: NFPA #13D NFPA #13R Other: | Gross area, sq. ft. per floor: Use group: Construction type: Reinforced Concrete | Private Sewage Disposal: Public Private Electric Yes No Gas Yes No Heating System: Electric Oil Natural Gas | 1st floor: 2nd floor: Basement: Finished Basement □ Unfinished Basement□ Crawl space □ Slab on Grade □ No. of Bedrooms Height: Multi-family dwellings: No. of efficiency units: No. of 1 BR units: No. of 2 BR units: | Sewage Disposal: Public Private Electric Yes D No D Gas Yes No D Heating System: Electric D Oil D Natural Gas |
| State Certified Modular Full Footings: NFPA #13D NFPA #13R Other: Other: Other: | Gross area, sq. ft. per floor: Use group: Construction type: Reinforced Concrete Structural Steel | Private Sewage Disposal: Public Private Electric Yes No Gas Yes No Heating System: Electric Oil Natural Gas | 1st floor: 2nd floor: Basement: Finished Basement □ Unfinished Basement□ Crawl space □ Slab on Grade □ No. of Bedrooms Height: Multi-family dwellings: No. of efficiency units: No. of 1 BR units: No. of 2 BR units: No. of 3 BR units: | Sewage Disposal: Public Private Electric Yes I No I Gas Yes No I Heating System: Electric I Oil I Natural Gas I |
| State Certified Modular | Gross area, sq. ft. per floor: Use group: Construction type: Reinforced Concrete Structural Steel Masonry | Private Sewage Disposal: Public Private Electric Yes No Gas Yes No Heating System: Electric Oil Natural Gas Propane Gas | 1st floor: 2nd floor: Basement: Finished Basement □ Unfinished Basement□ Crawl space □ Slab on Grade □ No. of Bedrooms Height: Multi-family dwellings: No. of efficiency units: No. of 1 BR units: No. of 2 BR units: No. of 3 BR units: | Sewage Disposal: Public Private Electric Yes I No I Gas Yes No I Heating System: Electric I Oil I Natural Gas I Propane Gas I Sprinkler system: N/A |
| State Certified Modular Other Suppression State Certified Modular State Certified Modular | Gross area, sq. ft. per floor: Use group: Construction type: Reinforced Concrete Structural Steel Masonry | Private Sewage Disposal: Public Private Electric Yes No Gas Yes No Heating System: Electric Oil Natural Gas Propane Gas Sprinkler system: N/A | 1st floor: 2nd floor: Basement: Finished Basement Crawl space Slab on Grade No. of Bedrooms Height: Multi-family dwellings: No. of efficiency units: No. of 1 BR units: No. of 2 BR units: No. of 3 BR units: Cother Structure: Dimensions: Footings: | Sewage Disposal: Public Private Electric Yes I No I Gas Yes No I Heating System: Electric I Oil I Natural Gas I Propane Gas I Sprinkler system: N/A I NFPA #13D |
| · · · · · · · · · · · · · · · · · · · | Gross area, sq. ft. per floor: Use group: Construction type: Reinforced Concrete Structural Steel Masonry Wood Frame | Private Sewage Disposal: Public Private Electric Yes No Gas Yes No Heating System: Electric Oil Natural Gas Propane Gas Sprinkler system: N/A Full | 1st floor: 2nd floor: Basement: Finished Basement Crawl space Slab on Grade No. of Bedrooms Height: Multi-family dwellings: No. of efficiency units: No. of 1 BR units: No. of 2 BR units: No. of 3 BR units: Cother Structure: Dimensions: Footings: | Sewage Disposal: Public Private Electric Yes D No D Gas Yes No D Heating System: Electric D Oil D Natural Gas D Propane Gas D Sprinkler system: N/A D NFPA #13D NFPA #13R |
| | Gross area, sq. ft. per floor: Use group: Construction type: Reinforced Concrete Structural Steel Masonry Wood Frame State Certified Modular The undersigned hierery certifies and agrees as follows: | Private Sewage Disposal: Public Private Electric Yes No Gas Yes No Heating System: Electric Oil Natural Gas Propane Gas Sprinkler system: N/A Full Partial Other Suppression # of Heads | 1st floor: 2nd floor: Basement: Finished Basement | Sewage Disposal: Public Private Electric Yes No Gas Yes No Gas Yes No Gas Heating System: Electric Gold Gas |
| TOTAL DOCUMENT OF THE APPLICATION AND ACTION AND THE ABOVE REFERENCED PROPERTY NOT SPECIFICALLY DESCRIPED IN THIS ADDITION (S) THAT WE CAN DESCRIPED AND ACTION | Gross area, sq. ft. per floor: Use group: Construction type: Reinforced Concrete Structural Steel Masonry Wood Frame State Certified Modular The undersigned hereby certifies and agrees as follows howard County which are applicable thereto; (4) that he | Private Sewage Disposal: — Public — Private Electric Yes □ No □ Gas Yes □ No □ Heating System: Electric □ Oil □ Natural Gas □ Propane Gas □ Sprinkler system: N/A □ — Full — Partial — Other Suppression — # of Heads | 1st floor: 2nd floor: Basement: Finished Basement Crawl space Slab on Grade No. of Bedrooms Height: Multi-family dwellings: No. of efficiency units: No. of 1 BR units: No. of 2 BR units: No. of 3 BR units: Cother Structure: Dimensions: Footings: Roof Height: State Certified Modular Manufactured Home PPLICATION; (2)THAT THE INFORMATION IS CORRECT; (3) THAT HE/SHE CARRICED PROPERTY NOT SPECIFICALLY DESCRIPTED IN THE APPLICATION; | Sewage Disposal: Public Private Electric Yes No Gas Yes No Gas Yes No Gas Heating System: Electric Gold Gas |
| HOWARD COUNTY WHICH ARE APPLICABLE THERETO; (4) THAT HE/SHE WILL PERFORM NO WORK ON THE ABOVE REFERENCED PROPERTY NOT SPECIFICALLY DESCRIBED IN THIS APPLICATION; (5) THAT HE/SHE GRANTS COUNTY OFFICIALS THE RIGHT TO ENTER ONTO THIS PROPERTY FOR THE PURPOSE OF INSPECTING THE WORK PERMITTED AND POSTING NOTICES. | Gross area, sq. ft. per floor: Use group: Construction type: Reinforced Concrete Structural Steel Masonry Wood Frame State Certified Modular The undersigned hereby certifies and agrees as follows howard County which are applicable thereto; (4) that he | Private Sewage Disposal: — Public — Private Electric Yes □ No □ Gas Yes □ No □ Heating System: Electric □ Oil □ Natural Gas □ Propane Gas □ Sprinkler system: N/A □ — Full — Partial — Other Suppression — # of Heads | 1st floor: 2nd floor: Basement: Finished Basement Crawl space Slab on Grade No. of Bedrooms Height: Multi-family dwellings: No. of efficiency units: No. of 1 BR units: No. of 2 BR units: No. of 3 BR units: Cother Structure: Dimensions: Footings: Roof Height: State Certified Modular Manufactured Home PPLICATION; (2)THAT THE INFORMATION IS CORRECT; (3) THAT HE/SHE CARRICED PROPERTY NOT SPECIFICALLY DESCRIPTED IN THE APPLICATION; | Sewage Disposal: Public Private Electric Yes No Gas Yes No Gas Yes No Gas Heating System: Electric Gold Gas |
| THE RIGHT TO ENTER ONTO THIS PROPERTY FOR THE PURPOSE OF INSPECTING THE WORK PERMITTED AND POSTING NOTICES. | Gross area, sq. ft. per floor: Use group: Construction type: Reinforced Concrete Structural Steel Masoriry Wood Frame State Certified Modular The undersigned hereby certifies and agrees as follows thoward County which are applicable thereto, (4) that he the right to enter onto this property for the purpose of the right to enter onto this property for the purpose of the right. | Private Sewage Disposal: — Public — Private Electric Yes □ No □ Gas Yes □ No □ Heating System: Electric □ Oil □ Natural Gas □ Propane Gas □ Sprinkler system: N/A □ — Full — Partial — Other Suppression — # of Heads | 1st floor: 2nd floor: Basement: Finished Basement | Sewage Disposal: Public Private Electric Yes No Gas Yes No Gas Yes No Gas Heating System: Electric Gold Gas |
| TO THE ABOVE REFERENCED PROPERTY AND REPORT AND ALL PERFORM NO WORK ON THE ABOVE REFERENCED PROPERTY AND REPORTED IN THIS ADDITION (S) THAT WE (NEVER COLUMN | Gross area, sq. ft. per floor: Use group: Construction type: Reinforced Concrete Structural Steel Masoriry Wood Frame State Certified Modular The undersigned hereby certifies and agrees as follows thoward County which are applicable thereto, (4) that he the right to enter onto this property for the purpose of the right to enter onto this property for the purpose of the right. | Private Sewage Disposal: — Public — Private Electric Yes □ No □ Gas Yes □ No □ Heating System: Electric □ Oil □ Natural Gas □ Propane Gas □ Sprinkler system: N/A □ — Full — Partial — Other Suppression — # of Heads | 1st floor: 2nd floor: Basement: Finished Basement | Sewage Disposal: Public Private Electric Yes No Gas Yes No Gas Yes No Gas Heating System: Electric Gold Gas |
| THE RIGHT TO ENTER ONTO THIS PROPERTY FOR THE PURPOSE OF INSPECTING THE WORK PERMITTED AND POSTING NOTICES. Applicant's Signature Print Name Title/Company Date | Gross area, sq. ft. per floor: Use group: Construction type: Reinforced Concrete Structural Steel Masonry Wood Frame State Certified Modular The undersigned hereby certifies and agrees as follows howard County which are applicable Thereto, (4) that he the right to enter onto this property for the purpose of Applicant's Signature | Private Sewage Disposal: Public Private Electric Yes No Gas Yes No Heating System: Electric Oil Natural Gas Propane Gas Sprinkler system: N/A Full Partial Other Suppression # of Heads Estate with Perform No Work on the Above Ref | 1st floor: 2nd floor: Basement: Finished Basement | Sewage Disposal: Public Private Electric Yes No Gas Yes No Gas Yes No Gas Heating System: Electric Gold Gas |
| THE RIGHT TO ENTER ONTO THIS PROPERTY FOR THE PURPOSE OF INSPECTING THE WORK PERMITTED AND POSTING NOTICES. Applicant's Signature Print Name | Gross area, sq. ft. per floor: Use group: Construction type: Reinforced Concrete Structural Steel Masonry Wood Frame State Certified Modular The undersigned hereby certifies and agrees as follows howard County which are applicable Thereto, (4) that he the right to enter onto this property for the purpose of Applicant's Signature | Private Sewage Disposal: Public Private Electric Yes No Gas Yes No Heating System: Electric Oil Natural Gas Propane Gas Sprinkler system: N/A Full Partial Other Suppression # of Heads Finspecting the work on the above reference of the properties of the properti | 1st floor: 2nd floor: Basement: Finished Basement | Sewage Disposal: Public Private Electric Yes In No In |
| THE RIGHT TO ENTER ONTO THIS PROPERTY FOR THE PURPOSE OF INSPECTING THE WORK PERMITTED AND POSTING NOTICES. Applicant's Signature Print Name Checks payable to: DIRECTOR OF FINANCE OF HOWARD COUNTY ** PLEASE WRITE NEATLY AND LEGIBLY. ** FOR OFFICE USE-OWAY. | Gross area, sq. ft. per floor: Use group: Construction type: Reinforced Concrete Structural Steel Masonry Wood Frame State Certified Modular The undersigned hereby certifies and agrees as follows howard County which are applicable Thereto, (4) that he the right to enter onto this property for the purpose of Applicant's Signature | Private Sewage Disposal: Public Private Electric Yes No Gas Yes No Heating System: Electric Oil Natural Gas Propane Gas Sprinkler system: N/A Full Partial Other Suppression # of Heads For Heads Finspecting the Work on the Above Reference of the Person No Work on the Ab | 1st floor: 2nd floor: Basement: Finished Basement | Sewage Disposal: Public Private Electric Yes In No In |
| THE RIGHT TO ENTER ONTO THIS PROPERTY FOR THE PURPOSE OF INSPECTING THE WORK PERMITTED AND POSTING NOTICES. Applicant's Signature Print Name Title/Company Checks payable to: DIRECTOR OF FINANCE OF HOWARD COUNTY | Gross area, sq. ft. per floor: Use group: Construction type: Reinforced Concrete Structural Steel Masonry Wood Frame State Certified Modular The undersigned hereby certifies and agrees as follows howard County which are applicable Thereto, (4) that he the right to enter onto this property for the purpose of Applicant's Signature | Private Sewage Disposal: Public Private Electric Yes No Gas Yes No Heating System: Electric Oil Natural Gas Propane Gas Sprinkler system: N/A Full Partial Other Suppression # of Heads For Heads Finspecting the Work on the Above Reference of the Person No Work on the Ab | 1st floor: 2nd floor: Basement: Finished Basement | Sewage Disposal: Public Private Electric Yes D No D Heating System: Electric D Oil D Natural Gas D Propane Gas D Sprinkler system: N/A D NFPA #13D NFPA #13R Other: |
| THE RIGHT TO ENTER ONTO THIS PROPERTY FOR THE PURPOSE OF INSPECTING THE WORK PERMITTED AND POSTING NOTICES. Applicant's Signature Print Name Checks payable to: Director of Finance of Howard County "" PLEASE WRITE NEATLY AND LEGIBLY." AGENCY SIGNATURE APPROVA. PROPERTY DISC. First | Gross area, sq. ft. per floor: Use group: Construction type: Reinforced Concrete Structural Steel Masonry Wood Frame State Certified Modular The undersigned hereby certifies and agrees as follows howard County which are applicable Thereto, (4) that he the right to enter onto this property for the purpose of Applicant's Signature | Private Sewage Disposal: Public Private Electric Yes No Gas Yes No Heating System: Electric Oil Natural Gas Propane Gas Sprinkler system: N/A Full Partial Other Suppression # of Heads For Heads Finspecting the Work on the Above Reference of the Person No Work on the Ab | 1st floor: 2nd floor: Basement: Finished Basement | Sewage Disposal: Public Private Electric Yes No Gas Yes Yes Yes Yes Yes Yes Yes Yes Yes Ye |
| THE RIGHT TO ENTER ONTO THIS PROPERTY FOR THE PURPOSE OF INSPECTING THE WORK PERMITTED AND POSTING NOTICES. Applicant's Signature Print Name Checks payable to: DIRECTOR OF FINANCE OF HOWARD COUNTY *** PLEASE WRITE NEATLY AND LEGIBLY. *** SIGNATURE APPROVAL. DECEMBER APPROVAL. DECEMBER APPROVAL. PROPERTY NOT SPECIFICALLY DESCRIBED IN THIS APPLICATION, (5) THAT HE/SHE GRANTS COUNTY OFFICIALS THE RIGHT TO ENTER ONTO THIS PROPERTY FOR THE PURPOSE OF INSPECTING THE WORK PERMITTED AND POSTING NOTICES. *** PLEASE WRITE NEATLY AND LEGIBLY. *** SIGNATURE APPROVAL. DECEMBER APPROVAL. PROPERTY IDEX. | Gross area, sq. ft. per floor: Use group: Construction type: Reinforced Concrete Structural Steel Masonry Wood Frame State Certified Modular The undersigned hereby certifies and agrees as follows howard County which are applicable Thereto, (4) that he the right to enter onto this property for the purpose of Applicant's Signature | Private Sewage Disposal: Public Private Electric Yes No Gas Yes No Heating System: Electric Oil Natural Gas Propane Gas Sprinkler system: N/A Full Partial Other Suppression # of Heads For Heads Finspecting the Work on the Above Reference of the Person No Work on the Ab | 1st floor: 2nd floor: Basement: Finished Basement | Sewage Disposal: Public Private Electric Yes No Gas Yes Yes Yes Yes Yes Yes Yes Yes Yes Ye |


AGENCY DOTE SIGNATURE APPROVAL

Grad Overbronner, DF2

Step Harmonia

Step Description

Step Descripti

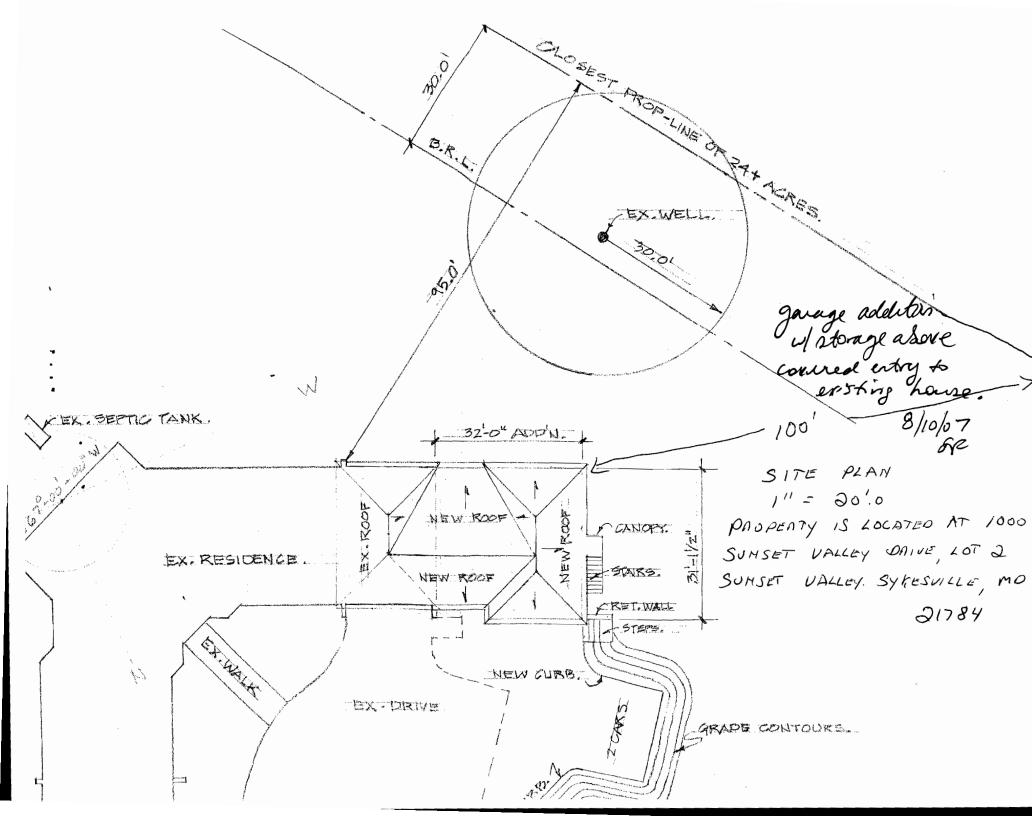

BOO HAHOLY 10/29/03 Proposed garage and 2-tedroom addition o. K. Will still have of bedrooms total after addition - per plans. EXISTING RESIDENCE EXISTING DRIVENING RIGHT StORE MODITION ! 201 24