

APPLICATION

SEWAGE DISPOSAL TESTING

STATE OF MARYLAND - DEPARTMENT OF HEALTH AND MENTAL HYGIENE

HOWARD COUNTY HEALTH DEPARTMENT
ENVIRONMENTAL HEALTH SERVICES

P. O. BOX 473 - ELLICOTT CITY, MARYLAND 21043
TELEPHONE: 992-2330

A 31640

P _____

DISTRICT 3RD

DATE Oct 1, 1981

See attached spec sheet

TO: THE COUNTY HEALTH OFFICER
ELLICOTT CITY, MARYLAND

I, HEREBY, APPLY FOR THE NECESSARY TEST IN ORDER TO CONSTRUCT (OR RECONSTRUCT) A SEWAGE DISPOSAL SYSTEM.

PROPERTY OWNER CHARLES KARFONTA

ADDRESS 21 CHRYSLER PLACE CATONSVILLE MARYLAND 21228 PHONE 788-9012

PROPERTY LOCATION:

SUBDIVISION SUNSET VALLEY SEC. 3 LOT NO. 2

ROAD AND DESCRIPTION 1700'± SOUTH EAST FROM INTERSECTION OF FORSYTHE ROAD AND SUNSET VALLEY DRIVE

SIZE OF LOT 19.581 Ac.± TYPE BLDG. SINGLE FAMILY 4 B.R. and 4.25 BATHS
(NUMBER OF BEDROOMS)

THE SYSTEM INSTALLED UNDER THIS APPLICATION IS ACCEPTABLE ONLY UNTIL PUBLIC FACILITIES BECOME AVAILABLE. I FULLY UNDERSTAND THE FEE CONNECTED WITH THE FILING OF THIS PERC TEST APPLICATION IS NON-REFUNDABLE UNDER ANY CIRCUMSTANCES. I ALSO AGREE TO COMPLY WITH ALL M.O.S.H.A. REQUIREMENTS IN TESTING THIS LOT.

APPROVED BY C. B. Strecker FOR Dug Well +/or Dug Well + Trench (SIGNATURE OF APPLICANT) 11/12/81 DATE

REJECTED BY _____ FOR _____ DATE _____

HOLD PENDING FURTHER TESTS _____ DATE _____


REASONS FOR REJECTION OR HOLDING 10/6/81 HOLD FOR CERTIFIED HOLES, HOUSE SITE, & WATER WELL SITE.
C.B.C.

THIS IS NOT A PERMIT

120

19 acres

SOIL PROFILE

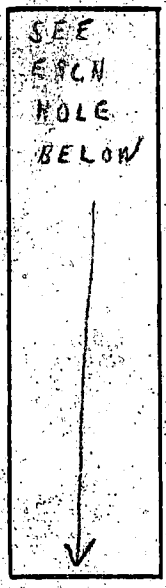

See plot for approximate area

INDICATE NORTH - NAME ADJOINING ROADWAY AS BASE LINE.

SUNSET VALLEY DR.

SOIL PROFILE

DATE	TEST NO.	DEPTH	PRE-WET		TEST - 1" DROP		TIME
			START	STOP	START	STOP	
10/6/21	1	1 1/2'	3:54	3:56	3:56	4:04	8 min
	2	9 1/2'	3:52	3:56	3:56	4:03	7 min
	3	4'	3:00	3:04	3:04	3:13	9 min
	(L) 4	8'	2:57	3:00	3:00	3:03	3 min
	5	4 1/2'	3:26	3:27	3:27	3:30	3 min
	(L) 6	8 1/2'	3:23	3:25	3:25	3:30	5 min
	7	4'	4:07	4:09	4:09	4:18	9 min
	8	12'	SHELL TO BOTTOM SIMILAR				NR

1' - 4' CLAY
4' - LOAM
TO 12'
1' - 4' CLAY
4' - LOAM
TO 12'
1' - 4' CLAY
4' - LOAM
TO 12'

HOLD FOR: (1) HOUSE SITE
(2) WATER WELL
(3) CERTIFIED HOLE

REMARKS

TEST SITE HIGH GRASS

TYPE OF SOIL

TESTED BY

C. B. D.

ALSO PRESENT

ANTHONY
KARFONIA
MEN

EH-12-1079

APPLICATION

SEWAGE DISPOSAL TESTING

STATE OF MARYLAND - DEPARTMENT OF HEALTH AND MENTAL HYGIENE

HOWARD COUNTY HEALTH DEPARTMENT
ENVIRONMENTAL HEALTH SERVICES

P. O. BOX 473 ELLICOTT CITY, MARYLAND 21043
TELEPHONE: 992-2330

A 31640

P _____

DISTRICT 3RD

DATE Oct 1, 1981

TO: THE COUNTY HEALTH OFFICER
ELLICOTT CITY, MARYLAND

I, HEREBY, APPLY FOR THE NECESSARY TEST IN ORDER TO CONSTRUCT (OR RECONSTRUCT) A SEWAGE DISPOSAL SYSTEM.

PROPERTY OWNER CHARLES KARFONTA

ADDRESS 21 CHRYSLER PLACE CATONSVILLE MARYLAND 21228 PHONE 788-9012

PROPERTY LOCATION:

SUBDIVISION SUNSET VALLEY SEC. 3 LOT NO. 2

ROAD AND DESCRIPTION 1700'± SOUTH EAST FROM INTERSECTION OF FORSYTHE ROAD AND SUNSET VALLEY DRIVE

SIZE OF LOT 19.581 AC.± TYPE BLDG. SINGLE FAMILY
(NUMBER OF BEDROOMS)

THE SYSTEM INSTALLED UNDER THIS APPLICATION IS ACCEPTABLE ONLY UNTIL PUBLIC FACILITIES BECOME AVAILABLE. I FULLY UNDERSTAND THE FEE CONNECTED WITH THE FILING OF THIS PERC TEST APPLICATION IS NON-REFUNDABLE UNDER ANY CIRCUMSTANCES. I ALSO AGREE TO COMPLY WITH ALL M.O.S.H.A. REQUIREMENTS IN TESTING THIS LOT.

Charles J. Carr
(SIGNATURE OF APPLICANT)

APPROVED BY _____ FOR _____ DATE _____

REJECTED BY _____ FOR _____ DATE _____

HOLD PENDING FURTHER TESTS _____ DATE _____


REASONS FOR REJECTION OR HOLDING 10/6/81 HOLD FOR CERTIFIED HOLES HOUSE SITE

WATER WELL SITE.

C.D.D.

THIS IS NOT A PERMIT

FIELD SHEET

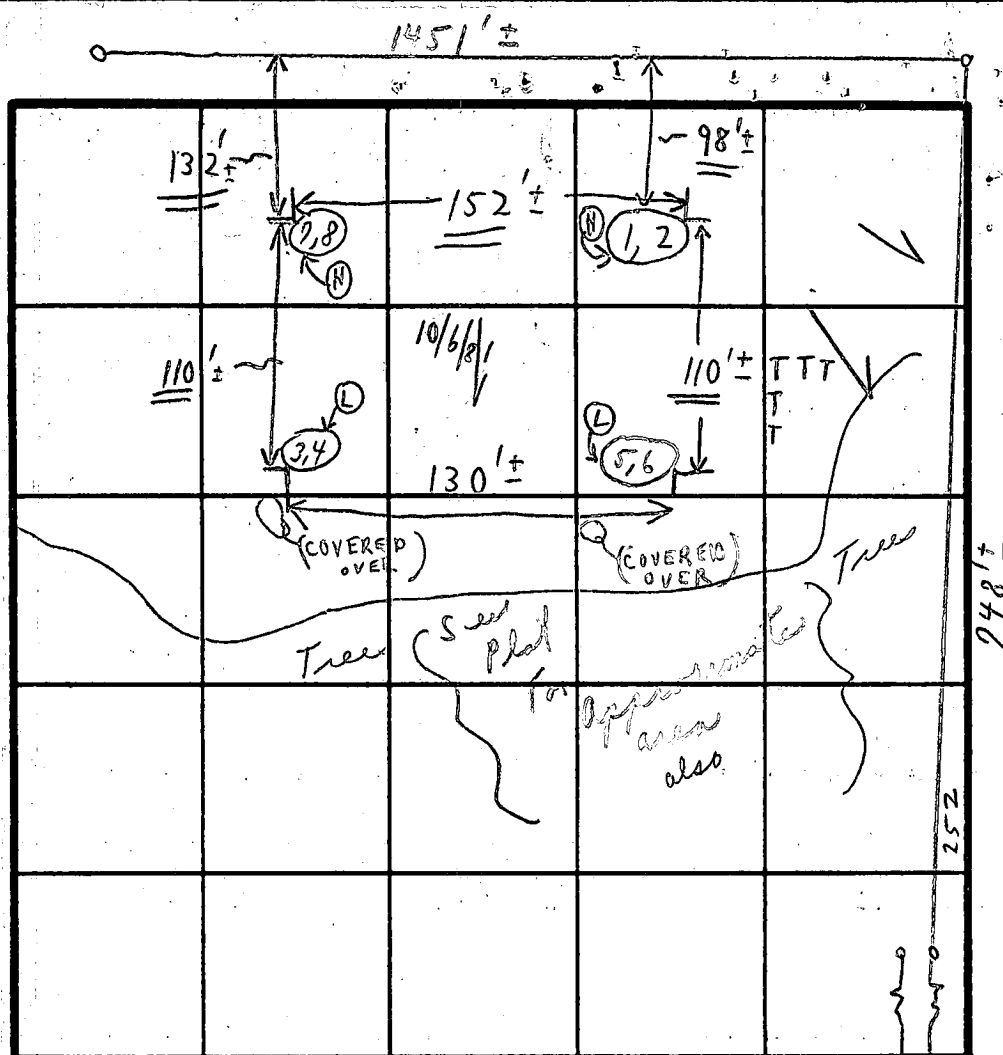

INDICATE NORTH - NAME ADJOINING ROADWAY AS BASE LINE

SUNSET VALLEY DR.

SOIL PROFILE

DATE	TEST NO.	DEPTH	PRE-WET		TEST - 1" DROP		TIME
			START	STOP	START	STOP	
10/6/81	1	4 1/2'	3:54	3:56	3:56	4:04	8 min
	2	9 1/2'	3:52	3:56	3:56	4:03	7 min
	3	4'	3:00	3:04	3:04	3:13	9 min
	④ 4 p.l.	8'	2:57	3:00	3:00	3:03	3 min
	5	4 1/2'	3:26	3:27	3:27	3:30	3 min
	⑥ 6	8 1/2'	3:23	3:25	3:25	3:30	5 min
	7	4'	4:07	4:09	4:09	4:18	9 min
	8	12'	SHELF	TO BOTTOM	5 IN	1 IN	9 min 44 sec

dry Well
about 4'
Maximum
Depth
10'

125 ϕ /bed

7m aug

REMARKS

TESTS IN HIGH GRASS

TYPE OF SOIL

TESTED BY

C. B. A.

ALSO PRESENT

HOLD FOR: (1) HOUSE SITE
(2) WATER WELL
(3) CERTIFIED
HOLES

{ ANTHONY
V. KARFONIA'S
MEN }