Menu

Save

Reset

Cancel

Help

Approved 4,20.22

Record Detail * (This section is required.)

Permit Type	Permit Number	Opened Date	
Building/Residential/Alteration/SFD	B22001428	04/16/2022	

Description of Work

SFD, REMODEL KITCHEN, DEMO BAY WINDOW AND INSTALL NEW 36* DOOR TO DECK USING EXISTING HEADER. THERE WILL BE NO STRUCTURAL WORK ON THIS PROJECT. 274 SQ FT

check spelling

Address * (This section is required.)

Donat

Search	Reset	Clear	etraiceio	Owner		
Street #	Street Name			s	treet Type	
2631	WYNFIELD			-	RD	~
Unit Type	Unit #	X Coordinat	e	Y Coord	linate	
-Select	~	-76.94074		39,2966	51	
City		State	Zip C	ode	Primary	
WEST FRIE	ENDSHIP	MD	2179	4	Yes	~

Class

Parcel * (This section is required.)

Search

Coarab

Reset

Clear

Get Address & Owner

Get Parcel & Owner

GIS ID * 905033 Parcel

Parcel Area

Land Value 262100 Improved Value 575700 Exemption Value 313600 Plan Area RURAL

Legal Description

IMPSLOT 9 3.286 A6 A[]2631 WYNFIELD RD[]WYNFIELD SEC 1

check spelling

Block	Lot 9	Census Tract 603000	Council Dist 5	Inspection Dist	Supervisor Dist	Map#	DAP Zone
Plan Area		State Tax Id		division Name			
		1403308723	WY	NFIELD			
Section		Area	Tax	Мар			
			15				
Grid		Zoning District	ADO	Мар			
15-18		RR-DEO	481	3-K3			
SDP No.		Final Plan No.	WP	File No.			
		F-81-059			Primary		
Record Pla 4871	t No.	WS Contract No.	FDP	No.	Yes	~	
Owner Occ	upied	Year Built	Hist	oric District			
O Yes O	No	1987	0	Yes No			
Historic Dis	strict Registry No.	Stat Area	Floo	d Plain			
		3-05	0	Yes No			
Building No	0						

Owner (This section is not required.)

Search

Reset

Clear

Name *
MARTINEAU JOSHUA D
Address Line 1
2631 WYNFIELD RD
Address Line 2

Address Line 3

Mail City

Mail State Mail Zip Code
MD ✓ 21779

WEST FIENDSHIP
Phone

Primary

Prima Yes

301-957-8717 E-mail

103

Cell Number

Fax Number

PATMENTIN	NFORMATION					
Check 1	Payee 1	Check 2	Payee 2	SAP Doc No	SAP Entered	

Related Records


Showing 1-2 of 2

 Permit Number
 Record Type Alias
 Status
 Number
 Street Name
 Opened Date
 Description


 B22001428
 Residential Interior Alteration Single Family Dwelling Permit
 Review In Process
 2631
 WYNFIELD
 04/16/2022
 SFD/REMODEL KITCHEN. DEMO BAY WINDOW AND INSTALL

Submit Cancel

1

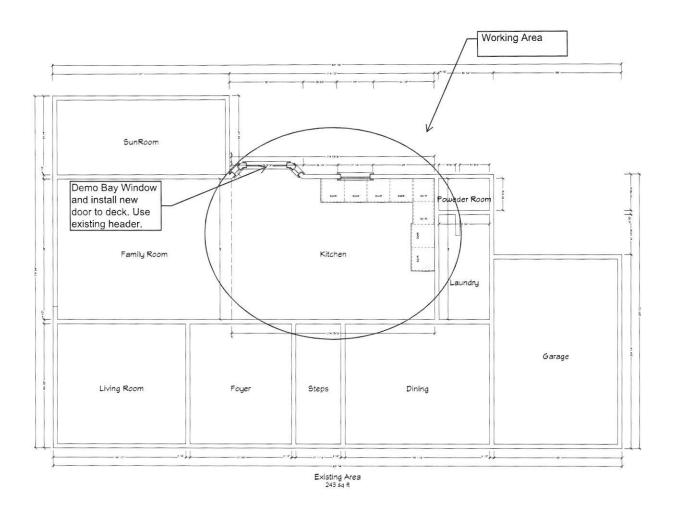

1 1

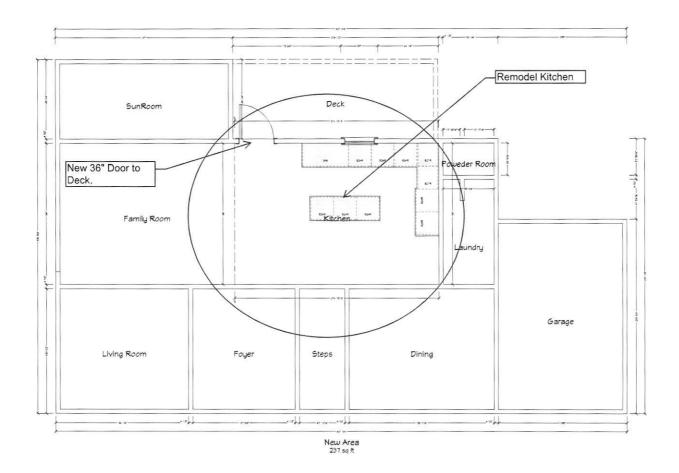

2 7 k