

Record Detail * (This section is required.)

Permit Type	Permit Number	Opened Date
Building/Residential/Misc/Pool Spa	B22000931	03/21/2022
Description of Work		
SFD/ CONSTRUCT 18' X 36' INGROUND CONCRETE SWIMMING POOL, DEPTH 3.5' - 7.0' W/ 824 SQ.FT PATIO		

[check spelling](#)

Address * (This section is required.)

Search	Reset	Clear	Get Parcel & Owner		
Street #	Street Name	Street Type			
3110	SENECA CHIEF	TRL		▼	
Unit Type	Unit #	X Coordinate	Y Coordinate		
--Select--	▼	-76.91328	39.28615		
City	State	Zip Code	Primary		
ELLICOTT CITY	MD	21042	Yes	▼	

Parcel * (This section is required.)

Search	Reset	Clear	Get Address & Owner			
GIS ID *	Parcel	Parcel Area	Land Value	Improved Value	Exemption Value	Plan Area
900722	441	40031	240000	1234700	994700	RURAL
Legal Description						
IMPSLOT 37 40,031 SQ[]3110 SENECA CHIEF TRL[]BRANTWOOD,S3,A3,RS PAR C						

[check spelling](#)

Block	Lot	Census Tract	Council Dist	Inspection Dist	Supervisor Dist	Map #	DAP Zone
	37	603000	5				
Plan Area	State Tax Id		Subdivision Name				
	1403338975		BRANTWOOD				
Section	Area		Tax Map				
			16				
Grid	Zoning District		ADC Map				
16-21	RC-DEO		4814-D5				
SDP No.	Final Plan No.		WP File No.				
	F-01-067						
Record Plat No.	WS Contract No.		FDP No.		Primary	▼	
15253					Yes		
Owner Occupied	Year Built		Historic District				
☐ Yes ☐ No	2003		☐ Yes ☒ No				
Historic District Registry No.	Stat Area		Flood Plain				
	3-06A		☐ Yes ☒ No				
Building No							

Owner * (This section is required.)

Search	Reset	Clear
Name *		
SHRIVASTAVA GUNJAN		
Address Line 1		
3110 SENECA CHIEF TRL		
Address Line 2		
Address Line 3		
Mail City	Mail State	Mail Zip Code
ELLICOTT CITY	MD	21042
Phone	Primary	
410-599-7950	Yes	▼
E-mail		
Cell Number	Fax Number	

Professionals (This section is not required.)

Search	Reset	Clear
--------	-------	-------

Approved
B. Bueler
4/29/2022

3110 Seneca Chief Trail
B22000931

License # * 08050132939
 License Type * MHIC Co
 Primary Yes
 Business Name PARADISE POOLS INC
 First Name VERA Middle Name Last Name FRANCISCO
 Address Line 1 10620 RIGGS HILL ROAD UNIT H
 Address Line 2
 City JESSUP State MD ZIP Code 20794-0000
 Phone 1 3017250005 Phone 2 Fax
 E-mail OFFICE@PARADISEPOOLSMD.COM

Applicant (This section is not required.)

Search As Owner As Lic. Prof As Contact

Type * Applicant
 Relationship Applicant
 Primary Yes
 First Name HOPE MI Last Name COPENHEAVER
 Full Name HOPE COPENHEAVER
 Organization Name HMC PERMIT SERVICES
 Street Address 92 FINNEGANS PLACE
 Address Line 2
 City CONCOWINGO State MD Zip Code 21918
 Phone 443-768-0850 Cell Fax
 E-mail HMCpermits@yahoo.com

Addtl Info

Est Construction Cost * 30000
 Construction Type --Select--
 Housing Units * 0
 Number of Buildings * 0
 Public Owned No

POOL INFORMATION

MISCELLANEOUS POOL INFORMATION

Capital Project-No Fee * ☐ Yes ☒ No
 Capital Project Number
 Fee Exempt * ☐ Yes ☒ No
 Water Supply * Private
 Sewage Disposal * Private
 Existing Use SFD
 Type of Pool or Spa * In Ground Pool
 Pool Safety Device * --Select--
 Electrical Permit Number E21001319
 Expiration Date 9/28/2022

PAYMENT INFORMATION

Check 1 Payee 1 SAP Doc No SAP Entered

Related Records

Showing 1-2 of 2

Permit Number	Record Type Alias	Status	Number	Street Name	Opened Date	Description
B22000931	Residential Pool or Spa Permit	Review In Process	3110	SENECA CHIEF	03/21/2022	SFD/ CONSTRUCT 18' X 36' INGROUND CONCRETE SWIMMING POOL, DEPTH 3.5' - 7...
E22001319	Residential Electrical Miscellaneous Permit	Issued	3110	SENECA CHIEF	03/21/2022	Wire & bond pool 4439965981 B22000931

Page 1 of 1

Submit Cancel

OK
 RB
 3110 Seneca Chief Trail
 B22000931

UTILITIES
Wall
Septic




10620 Riggs Hill Rd, Laurel, MD 20794 | Phone: 301-725-0005 | Fax: 240-290-1277 | www.paradisepoolsmd.com | MHIC#92850-01

Approved Septic System Plan
Howard County Health Department
18' x 36' Inground pool
w/ equipment and decking

Bruck 4/29/22

B22000931
3110 Seneca Chief Trl

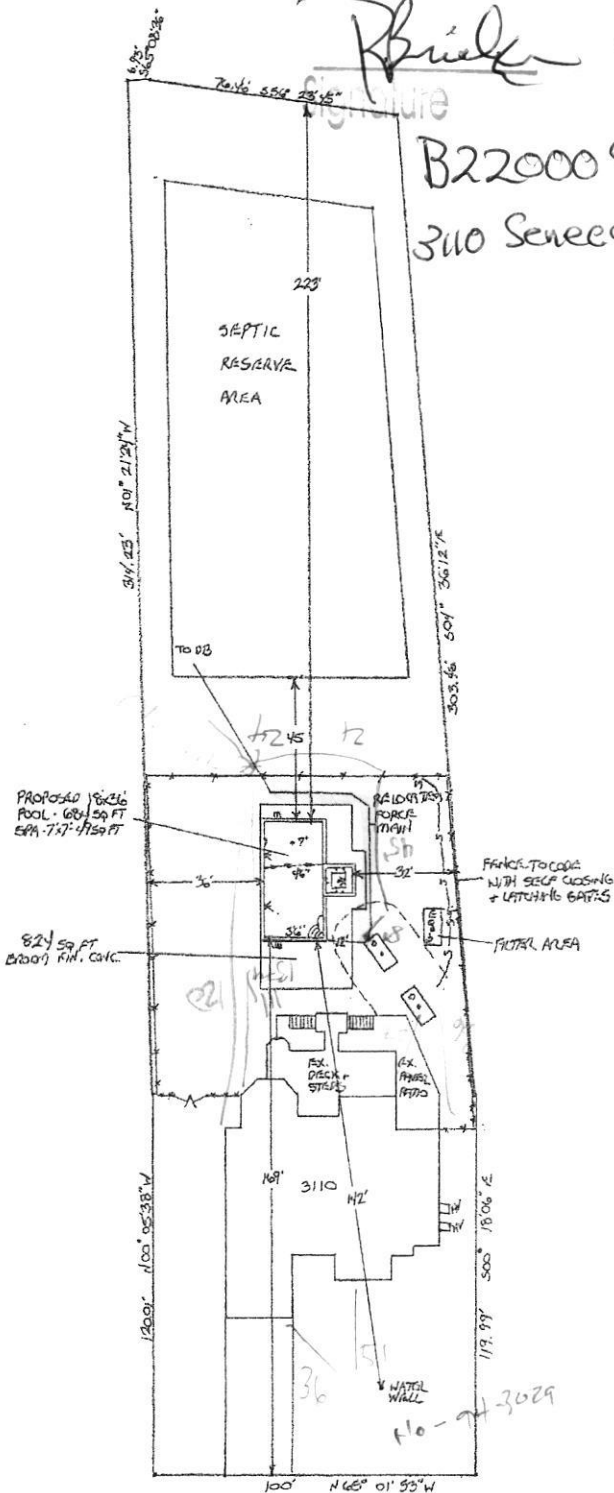

SENECA CHIEF TRAIL
SCALE: 1" = 40' RB

CUSTOMER INFORMATION	
Gunjan and Shilpi Shrivastava	District 3 -- Act 338975
3110 Seneca Chief Trail	Lot 37 -- Sub 2020
Ellicott City, MD 21042	Map 0016 -- Grid 0021 -- Parcel 0441
410-599-7950	Neighborhood 3020202.14 -- Plat 15253
	Deed Ref 18266/00397
Brantwood S3, A3, RS PAR C Subdivision	Land 40,031 sq ft
POOL SHELL SPECIFICATIONS	
Rectangle -- 684 square feet -- 18' x 36'	2 skimmers -- 2 returns -- 1 cleaner line --
Depth -- 3.5' - 4.5' -- 7.0'	1 MDX R3 drain with 1 SDX side wall drain
Gunite Beam 14" with 3" deck ledge	2 pool light niches
4 steps, 2nd step 1 - 6" aqua bench	49 sq ft raised spa - raised 18" - 5' spill way
1 - 6" inside loveseat - deep end --	
Perimeter -- 108	
Tile - Coping - Interior Finish	
2" x 6" x 12" Westchester Paver Coping	
Double coping on spa cap	
Tile - Nightlife NL1232 Galant 1x2	
Tile grout joints to be white	
Nantucket Eldorado Stone Face on spa	
White Marbelle interior finish	
Deck	
824 sq ft Broom Finish Concrete Patio	
Stone Base	
Bond Grid Included	
Rough grade only	
Equipment	
Intelliflo Variable Speed Pump	Legend Pool Sweep w 3/4 hp booster pump
Clean and Clear 420 Cartridge Filter	2 wall returns, 1 cleaner return, MDX and SDX
Mastertemp 400,000 btu Natural Gas heater	
Intellichlor VC 40 salt cell	Spa -- 8 jets, MDX and SDX, 2 hp air blower, 1
Mineral Springs Beginnings	intellibrite color light, 5' overflow into pool
Easytouch 8 PoolSpa control	
Screen Logic	
2 actuators	4 hydrostat caps
2 intellibrite color lights in pool	All Fittings to be white
APPURTENANCES	
Electric -- Paramount -- Included	Septic pump out and reroute forcemain by
Gas Line -- McCallister -- Included	Billings Outback - included
Fence -- not included - by owner	
ADDITIONAL FEATURES	
Water to Fill -- 25,000 gallons - included	
Most dirt to be graded on site --	
excavation 100 cubic yards --	
access is driveway side --	
70' slit fence on downslope side as shown	

PLAN DATE: 03/8/22
REVISION 1:
REVISION 2:
REVISION 3: