


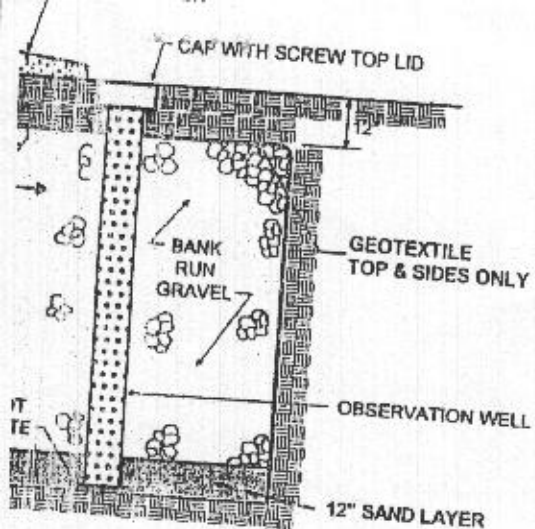

WELL DETAIL
LOCATION SEE PLAN

APPROVED
WALK-THRU BUILDING PERMIT
BP# 600154022 A# 517959
APP. SAN Face Hanna DATE: 5-11-05
DESC. OF WORK: Deck

SECTION ONE
GREEN HEDGE
PLAT NO. 42

SECTION
GREEN H
PLAT BOOK 10

