

8/5/02
9:00

APPLICATION

PERCOLATION TESTING

HOWARD COUNTY HEALTH DEPARTMENT
BUREAU OF ENVIRONMENTAL HEALTH
3525-H ELLICOTT MILLS DRIVE/ELLICOTT CITY, MARYLAND 21043
TELEPHONE: 313-2640

EX. recorded lot
(1965) orig- percs not located
No Fee
10K not req'd

A _____

P _____

DISTRICT 3RD

DATE 7/24/02

TO: THE COUNTY HEALTH OFFICER
ELLICOTT CITY, MARYLAND

I HEREBY APPLY FOR THE NECESSARY TEST PRIOR TO APPLICATION FOR PERMIT TO CONSTRUCT (OR RECONSTRUCT) A SEWAGE DISPOSAL SYSTEM.

BUYER John + Sandi Riebert NEW BUYER Kenneth Westrick
PROPERTY OWNER 301-688-5783

ADDRESS 11292 Country Club Rd PHONE 301-865-8165

OWNER Roger Chemen AGENT OR PROSPECTIVE BUYER
CELL 40.365.9410

ADDRESS _____ PHONE _____

PROPERTY LOCATION:

SUBDIVISION GREEN HEDGE LOT NO. 6

ROAD AND DESCRIPTION Triadelphia Rd on corner of Evergreen

TAX MAP 16 PARCEL # 240

SIZE OF LOT 1 Acre TYPE BLDG. Single Family Dwelling
(SINGLE FAMILY DWELLING OR COMMERCIAL)

THE SYSTEM INSTALLED UNDER THIS APPLICATION IS ACCEPTABLE ONLY UNTIL PUBLIC FACILITIES BECOME AVAILABLE. I FULLY UNDERSTAND THE FEE CONNECTED WITH THE FILING OF THIS PERC TEST APPLICATION IS NON-REFUNDABLE UNDER ANY CIRCUMSTANCES. I ALSO AGREE TO COMPLY WITH ALL M.O.S.H.A. REQUIREMENTS IN TESTING THIS LOT.

John J Riebert
(SIGNATURE OF APPLICANT)

APPROVED BY _____ FOR _____ DATE _____

DISAPPROVED BY _____ FOR _____ DATE _____

HOLD PENDING FURTHER TESTS _____

REASONS FOR REJECTION OR HOLDING _____

PERCOLATION TEST PLAT/PRELIMINARY PLAT - TITLE OR I.D. # _____ DATE _____

SITE DEVELOPMENT PLAN/FINAL PLAT - TITLE OR I.D. # _____ DATE _____

THIS IS NOT A PERMIT

COUNTY #

SOIL PROFILE

0'

Dense
micaceous
SL

3 1/2'

Fine
micaceous
SL
w/ < 5%
weak
saprolite

B

B6

Dense
Brown
micaceous
SL w/ 0-5%
Charney frags

3

Fine tan
SL
w/ 0-5%
Charney
frags

↓
Fine tan
SL

H

B7

Dense Red Brown
SL

↓
Dense Red brown
SL


5 1/2'

Fine
tan SL
w/ < 5%
Charney
frags

14

SOIL PROFILE

0'

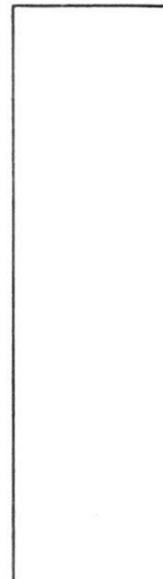

See
next
sheet

INDICATE NORTH - NAME ADJOINING ROADWAY AS BASE LINE.

DATE	TEST NO.	DEPTH	PRE-WET		TEST - 1" DROP		TIME	
			START	STOP	START	STOP		
8/5/02	B5	5 / 13	11:24:15	11:26:15	11:26:15	11:29:30	3:15	OK
8/5/02	B6	4 / 14	1:08:00	1:11:00	1:11:00	1:16:00	5	OK
8/5/02	B7	14U	material @ 5 1/2' to B6				2-7	OK

REMARKS _____

TYPE OF SOIL _____

TESTED BY _____ ALSO PRESENT _____

TRENCH DESIGN DATA: AVERAGE PERCOLATION TIME _____ TRENCH WIDTH _____

INLET DEPTH _____ MAXIMUM BOTTOM DEPTH _____ SQ. FT./BEDROOM _____

APPLICATION

PERCOLATION TESTING

HOWARD COUNTY HEALTH DEPARTMENT
BUREAU OF ENVIRONMENTAL HEALTH
3525-H ELLICOTT MILLS DRIVE/ELLICOTT CITY, MARYLAND 21043
TELEPHONE: 313-2640

TO: THE COUNTY HEALTH OFFICER
ELLICOTT CITY, MARYLAND

A _____
P _____
DISTRICT 3RD
DATE 7/24/02

EX. recorded lot
(1965) orig- percs not located
No Fee
10K not req'd

I HEREBY APPLY FOR THE NECESSARY TEST PRIOR TO APPLICATION FOR PERMIT TO CONSTRUCT (OR RECONSTRUCT) A SEWAGE DISPOSAL SYSTEM.

PROPERTY OWNER John + Sandi Riegert

ADDRESS 11292 Country Club Rd PHONE 301-865-8165
New Market 21774

AGENT OR PROSPECTIVE BUYER _____ CELL 410-365-9410

ADDRESS _____ PHONE _____

PROPERTY LOCATION:

SUBDIVISION GREEN HEDGE LOT NO. 6

ROAD AND DESCRIPTION Triadelphia Rd on corner of Evergreen

TAX MAP 16 PARCEL # 240

SIZE OF LOT 1 Acre TYPE BLDG. Single Family Dwelling
(SINGLE FAMILY DWELLING OR COMMERCIAL)

THE SYSTEM INSTALLED UNDER THIS APPLICATION IS ACCEPTABLE ONLY UNTIL PUBLIC FACILITIES BECOME AVAILABLE. I FULLY UNDERSTAND THE
FEE CONNECTED WITH THE FILING OF THIS PERC TEST APPLICATION IS NON-REFUNDABLE UNDER ANY CIRCUMSTANCES. I ALSO AGREE TO
COMPLY WITH ALL M.O.S.H.A. REQUIREMENTS IN TESTING THIS LOT.

John J. Riegert
(SIGNATURE OF APPLICANT)

APPROVED BY _____ FOR _____ DATE _____

DISAPPROVED BY _____ FOR _____ DATE _____

HOLD PENDING FURTHER TESTS _____

REASONS FOR REJECTION OR HOLDING _____

PERCOLATION TEST PLAT/PRELIMINARY PLAT - TITLE OR I.D. # _____ DATE _____

SITE DEVELOPMENT PLAN/FINAL PLAT - TITLE OR I.D. # _____ DATE _____

THIS IS NOT A PERMIT

SOIL PROFILE

0'

131

Dense
tan SL
4/5-10%
Churny
red heavy
SCL
very hard

fine
tan
SL
60/45%
Churny
SCL

B2


Dense tan
SL
↓
Heavy red
SCL

fine
tan SL
4/0-5/0
channey
frags

B3

Dense
tan
SL
w/0-590
channery
frag

Fine
hard
LS
w/ < 590
channery
frag s

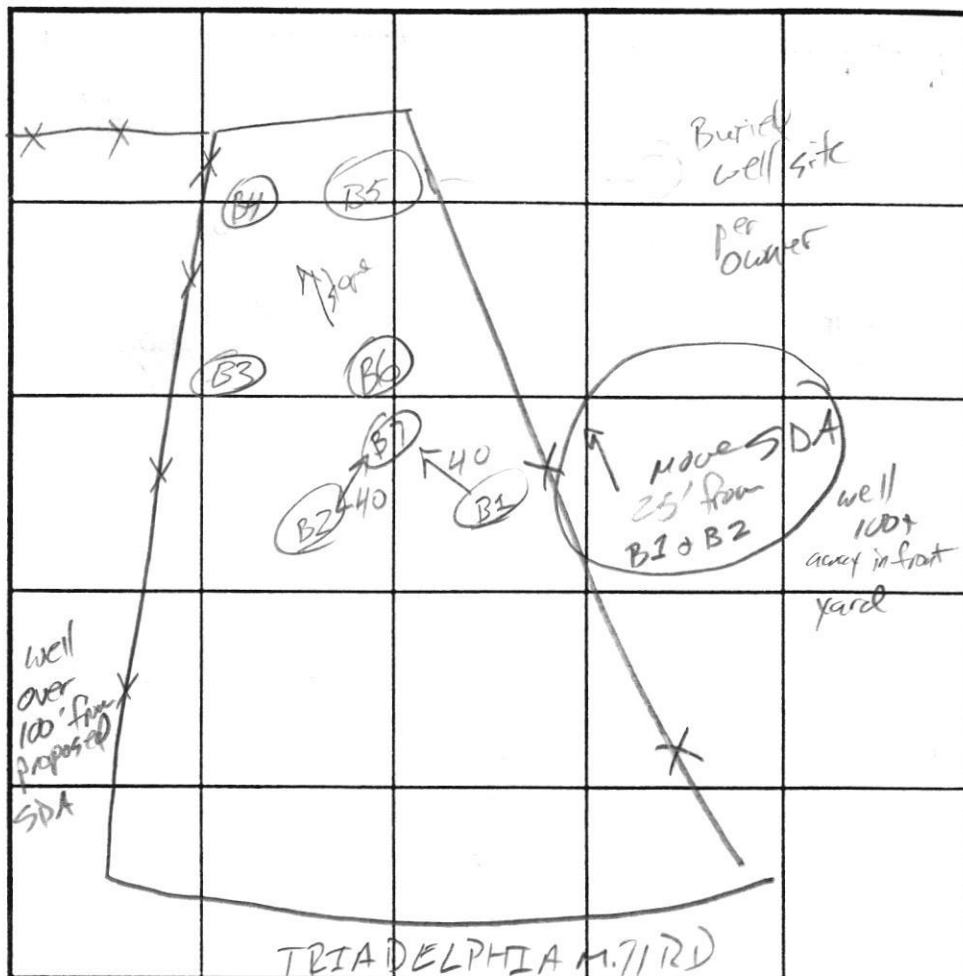

INDICATE NORTH - NAME ADJOINING ROADWAY AS BASE LINE.
well across street & 90' from Road

SOIL PROFILE

9

B4

Drugs
bottle
Chennai
54090
CL

red
milky
dense
SL

far LS
4/590
Channery
fags

weak
↓
firm

micashy
LS

DATE	TEST NO.	DEPTH	PRE-WET		TEST - 1" DROP		TIME
			START	STOP	START	STOP	
8/5/02	B2	14 V	No test	deep impermeable			NT
8/5/02	B2	14 V	No test	deep impermeable			NT
8/5/02	B3	5 1/2 14	12:02:15	12:05:00	12:05:00	12:09:30	4:30
8/5/02	B4	5 14	10:58:30	11:02:30	11:12:30	11:45:00	32:30
	B4	7 1/2 14	Visual similar to B3, B5, & B6				2-7

REMARKS Adjust SDA to be 25' NNW of failed holes B2 + B2

TYPE OF SOIL

TESTED BY

J. Boris

ALSO PRESENT

John (SCB)
+ Mr. Riegert

TRENCH DESIGN DATA: AVERAGE PERCOLATION TIME

5

TRENCH WIDTH

3

INLET DEPTH

4

MAXIMUM BOTTOM DEPTH

7

SQ. FT./BEDROOM

180

1.5' of effective sidewalk

