

DEPARTMENT OF INSPECTIONS, LICENSES AND PERMITS 3430 COURT HOUSE DRIVE ELICOTT CITY, MD 21043 PERMITS (410) 313-2455 INSPECTIONS (410) 313-1810 AUTOMATED INFORMATION (410) 313-3800		HOWARD COUNTY PERMIT APPLICATION		PERMIT NUMBER B0802 1414	
Building Address 10924 TOMPKINS WAY WOODSTOCK, MD 21163			Property Owner's Name Richard D. Wilson		
Suite/Apt. #: _____ SDP/WP/Petition #: _____			Address 10924 Tompkins Way		
Census Tract _____ Subdivision _____			City Woodstock State MD Zip Code 21163		
Section _____ Area _____ Lot _____			Phone 410-313-3800 Phone 410-313-3800		
Tax Map _____ Parcel _____ Grid _____			Applicant's Name & Mailing Address, (if other than stated hereon):		
Zoning _____ Map Coordinates _____ Lot size _____			Phone _____ Fax _____		
Existing Use Remodel Existing house			Contractor Company DUNN		
Proposed Use _____			Contact Person Richard D. Wilson		
Estimated Construction Cost \$ 100,000			Address _____		
Description of Work Remodel 1st floor and 2nd floor add 10' x 10' porch and ramp walkway, add 2nd floor ramp 12 x 36 door to 1st floor			City _____ State _____ Zip Code _____		
Occupant or Tenant DUNN 1st floor			License No. _____		
Contact Name _____			Phone _____ Fax _____		
Address _____			City _____ State _____ Zip Code _____		
City _____ State _____ Zip Code _____			Engineer or Architect Company _____		
Phone _____ Fax _____			Contact Person _____		
			Address _____		
			City _____ State _____ Zip Code _____		
			Phone _____ Fax _____		

BUILDING DESCRIPTION - <u>COMMERCIAL</u>		BUILDING DESCRIPTION - <u>RESIDENTIAL</u>	
<u>Building Characteristics</u>	<u>Utilities</u>	<u>Building Characteristics</u>	<u>Utilities</u>
Height: _____	Water Supply: _____ Public _____ Private _____	SF Dwelling <input checked="" type="checkbox"/> SF Townhouse <input type="checkbox"/> Depth Width 1st floor: 40 30	Water Supply: _____ Public _____ Private _____
No. of stories: _____	Sewage Disposal: _____ Public _____ Private _____	2nd floor: _____	Sewage Disposal: _____ Public _____ Private _____
Gross area, sq. ft. per floor: _____	Electric Yes <input type="checkbox"/> No <input type="checkbox"/> Gas Yes <input type="checkbox"/> No <input type="checkbox"/>	Basement: _____ Finished Basement <input type="checkbox"/> Unfinished Basement <input type="checkbox"/>	Electric Yes <input type="checkbox"/> No <input type="checkbox"/> Gas Yes <input type="checkbox"/> No <input type="checkbox"/>
Use group: _____	Heating System: _____ Electric <input type="checkbox"/> Oil <input type="checkbox"/> Natural Gas <input type="checkbox"/> Propane Gas <input type="checkbox"/>	Crawl space <input type="checkbox"/> Slab on Grade <input type="checkbox"/> No. of Bedrooms 4	Heating System: _____ Electric <input checked="" type="checkbox"/> Oil <input type="checkbox"/> Natural Gas <input type="checkbox"/> Propane Gas <input type="checkbox"/>
Construction type: _____ Reinforced Concrete _____ Structural Steel _____ Masonry _____ Wood Frame _____	Sprinkler system: N/A <input type="checkbox"/> Full _____ Partial _____ Other Suppression _____ # of Heads _____	Height: _____ Multi-family dwellings: _____ No. of efficiency units: _____ No. of 1 BR units: _____ No. of 2 BR units: _____ No. of 3 BR units: _____	Sprinkler system: N/A <input type="checkbox"/> NFPA #13D _____ NFPA #13R _____ Other: _____
State Certified Modular <input type="checkbox"/>		Other Structure: _____ Dimensions: _____ Footings: _____ Roof Height: _____	
		State Certified Modular <input type="checkbox"/> Manufactured Home <input type="checkbox"/>	

THE UNDERSIGNED HEREBY CERTIFIES AND AGREES AS FOLLOWS: (1) THAT HE/SHE IS AUTHORIZED TO MAKE THIS APPLICATION; (2) THAT THE INFORMATION IS CORRECT; (3) THAT HE/SHE WILL COMPLY WITH ALL REGULATIONS OF HOWARD COUNTY WHICH ARE APPLICABLE THERETO; (4) THAT HE/SHE WILL PERFORM NO WORK ON THE ABOVE REFERENCED PROPERTY NOT SPECIFICALLY DESCRIBED IN THIS APPLICATION; (5) THAT HE/SHE GRANTS COUNTY OFFICIALS THE RIGHT TO ENTER ONTO THIS PROPERTY FOR THE PURPOSE OF INSPECTING THE WORK PERMITTED AND POSTING NOTICES.

Applicant's Signature Richard D. Wilson	Print Name Richard D. Wilson
Title/Company DUNN	Date 10-2-08

Checks payable to: **DIRECTOR OF FINANCE OF HOWARD COUNTY**
** PLEASE WRITE NEATLY AND LEGIBLY. **
- FOR OFFICE USE ONLY -

<u>AGENCY</u>	<u>DATE</u>	<u>SIGNATURE</u>	<u>APPROVAL</u>	<u>DPZ SETBACK INFORMATION</u>	<u>PROPERTY ID#:</u>
✓ Land Development, DPZ				Front: _____	Filing fee \$ 25.00
State Highways				Rear: _____	Permit fee \$
✓ Building Official				Side: _____	Excise tax \$
✓ Dev. Engineering, DPZ				Side St.: _____	Add'l per. fee \$
✓ Health 10-2-08 Richard D. Wilson				All minimum setbacks met? YES <input type="checkbox"/> NO <input type="checkbox"/>	TOTAL FEES \$
Fire Protection				Is Entrance Permit required? YES <input type="checkbox"/> NO <input type="checkbox"/>	Sub-total paid \$
Is Sediment Control approval required prior to issuance? YES <input type="checkbox"/> NO <input type="checkbox"/>				Historic District? YES <input type="checkbox"/> NO <input type="checkbox"/>	Balance due \$
CONTINGENCY CONSTRUCTION START: <input type="checkbox"/>				Lot Coverage for NewTown Zone _____	Check # 6074
ONE STOP SHOP: <input type="checkbox"/>				SDP/Red-line approval date _____	Validation #
Distribution of Copies- White: Building Official Green: LDD, DPZ Yellow: DED, DPZ Pink: Health Gold: SHA					Accepted by _____
T:\forms\PERMIT.FRM					Rev. 11/4/04

LOT 4
57440 SF

LOT 5
57092 SF

Proposed
Pavilion

EX -
BARN
TO BE
REMOVED

10' BRL

LOT 6

57852 SF

HOUSE

Well

10' BRL

LOT 7

57605 SF

DECK OK
MR 10/22/03

10' BRL

SS A

BLE
IN

BR# 688001414
DATE 5/18/03
DESIGNER: R. J. L. L. L.
CONCRETE BY: J. L. L.
1" = 50' scale

Prelim approved by DPZ
2/26/02 R-03-02
1:50 scale
Provided by Health Dept.
Karee Noonan

HOWARD COUNTY PERMIT APPLICATION

PERMIT NUMBER

B08002780

Building Address 10924 TOMPKINS WAY
WOODSTOCK MD 21102
Suite/Apt. #: _____ SDP/WP/Petition #: _____
Census Tract _____ Subdivision _____
Section _____ Area _____ Lot _____
Tax Map _____ Parcel _____ Grid _____
Zoning _____ Map Coordinates _____ Lot size _____

Property Owner's Name Richard Dohler
Address 10924 Tompkins Way
City Woodstock State MD Zip Code 21102
Phone 410-420-4244 Phone 403-277-3616
Applicant's Name & Mailing Address, (if other than stated hereon):
Phone _____ Fax _____

Existing Use New 2 car detached garage
Proposed Use _____
Estimated Construction Cost \$ 60,000
Description of Work
New detached 2 car garage
with 2nd floor - bedroom
24 x 24

Contractor Company DUNN
Contact Person _____
Address _____
City _____ State _____ Zip Code _____
License No. _____
Phone _____ Fax _____

Occupant or Tenant N/A
Contact Name _____
Address _____
City _____ State _____ Zip Code _____
Phone _____ Fax _____

Engineer or Architect Company _____
Contact Person DUNN
Address _____
City _____ State _____ Zip Code _____
Phone _____ Fax _____

BUILDING DESCRIPTION - COMMERCIAL

Building Characteristics	Utilities
Height: <u>30'</u>	Water Supply: _____ Public _____ Private _____
No. of stories: <u>2</u>	Sewage Disposal: _____ Public _____ Private _____
Gross area, sq. ft. per floor: <u>536</u>	Electric Yes <input checked="" type="checkbox"/> No <input type="checkbox"/> Gas Yes <input type="checkbox"/> No <input type="checkbox"/>
Use group: _____	Heating System: _____ Electric <input type="checkbox"/> Oil <input type="checkbox"/> Natural Gas <input type="checkbox"/> Propane Gas <input type="checkbox"/>
Construction type: _____ Reinforced Concrete _____ Structural Steel _____ Masonry _____ <input checked="" type="checkbox"/> Wood Frame _____ State Certified Modular _____	Sprinkler system: <u>N/A</u> <input checked="" type="checkbox"/> Full _____ Partial _____ Other Suppression _____ # of Heads _____

BUILDING DESCRIPTION - RESIDENTIAL

Building Characteristics	Utilities
SF Dwelling <input type="checkbox"/> SF Townhouse <input type="checkbox"/> Depth _____ Width _____	Water Supply: _____ Public _____ Private _____
1st floor: <u>24' x 24'</u>	Sewage Disposal: _____ Public _____ Private _____
2nd floor: <u>garage</u>	Electric Yes <input checked="" type="checkbox"/> No <input type="checkbox"/> Gas Yes <input type="checkbox"/> No <input type="checkbox"/>
Basement: _____	Heating System: _____ Electric <input type="checkbox"/> Oil <input type="checkbox"/> Natural Gas <input type="checkbox"/> Propane Gas <input type="checkbox"/>
Finished Basement <input type="checkbox"/> Unfinished Basement <input type="checkbox"/> Crawl space <input type="checkbox"/> Slab on Grade <input type="checkbox"/> No. of Bedrooms _____ Height: _____ Multi-family dwellings: _____ No. of efficiency units: _____ No. of 1 BR units: _____ No. of 2 BR units: _____ No. of 3 BR units: _____	Sprinkler system: <u>N/A</u> <input checked="" type="checkbox"/> NFPA #13D _____ NFPA #13R _____ Other: _____
Other Structure: _____ Dimensions: _____ Footings: _____ Roof Height: _____ State Certified Modular _____ Manufactured Home _____	

THE UNDERSIGNED HEREBY CERTIFIES AND AGREES AS FOLLOWS: (1) THAT HE/SHE IS AUTHORIZED TO MAKE THIS APPLICATION; (2) THAT THE INFORMATION IS CORRECT; (3) THAT HE/SHE WILL COMPLY WITH ALL REGULATIONS OF HOWARD COUNTY WHICH ARE APPLICABLE THERETO; (4) THAT HE/SHE WILL PERFORM NO WORK ON THE ABOVE REFERENCED PROPERTY NOT SPECIFICALLY DESCRIBED IN THIS APPLICATION; (5) THAT HE/SHE GRANTS COUNTY OFFICIALS THE RIGHT TO ENTER ONTO THIS PROPERTY FOR THE PURPOSE OF INSPECTING THE WORK PERMITTED AND POSTING NOTICES.

Applicant's Signature

Print Name

Title/Company

Date

Checks payable to: **DIRECTOR OF FINANCE OF HOWARD COUNTY**

** PLEASE WRITE NEATLY AND LEGIBLY. **

- FOR OFFICE USE ONLY -

AGENCY DATE SIGNATURE APPROVAL

DPZ SETBACK INFORMATION

PROPERTY ID#:

Land Development, DPZ

Front: _____ Filing fee \$ 25.00

State Highways

Rear: _____ Permit fee \$ 100.00

Building Official

Side: _____ Excise tax \$ _____

Dev. Engineering, DPZ

Side St.: _____ Add'l per. fee \$ _____

Health 12/11/08 upm

All minimum setbacks met? YES ☐ NO ☐ TOTAL FEES \$ 125.00

Fire Protection

Is Entrance Permit required? YES ☐ NO ☐ Sub-total paid \$ _____

Is Sediment Control approval required prior to issuance?

Balance due \$ _____

YES ☐ NO ☐

Check # 111

CONTINGENCY CONSTRUCTION START: ☐

Validation # _____

ONE STOP SHOP: ☐

Historic District? YES ☐ NO ☐

Lot Coverage for NewTown Zone _____

Distribution of Copies-

White: Building Official

Green: LDD, DPZ

Yellow: DED, DPZ

Pink: Health


Gold: SHA

Accepted by _____

T:\forms\PERMIT.FRM


Rev. 11/4/04

[illegible]

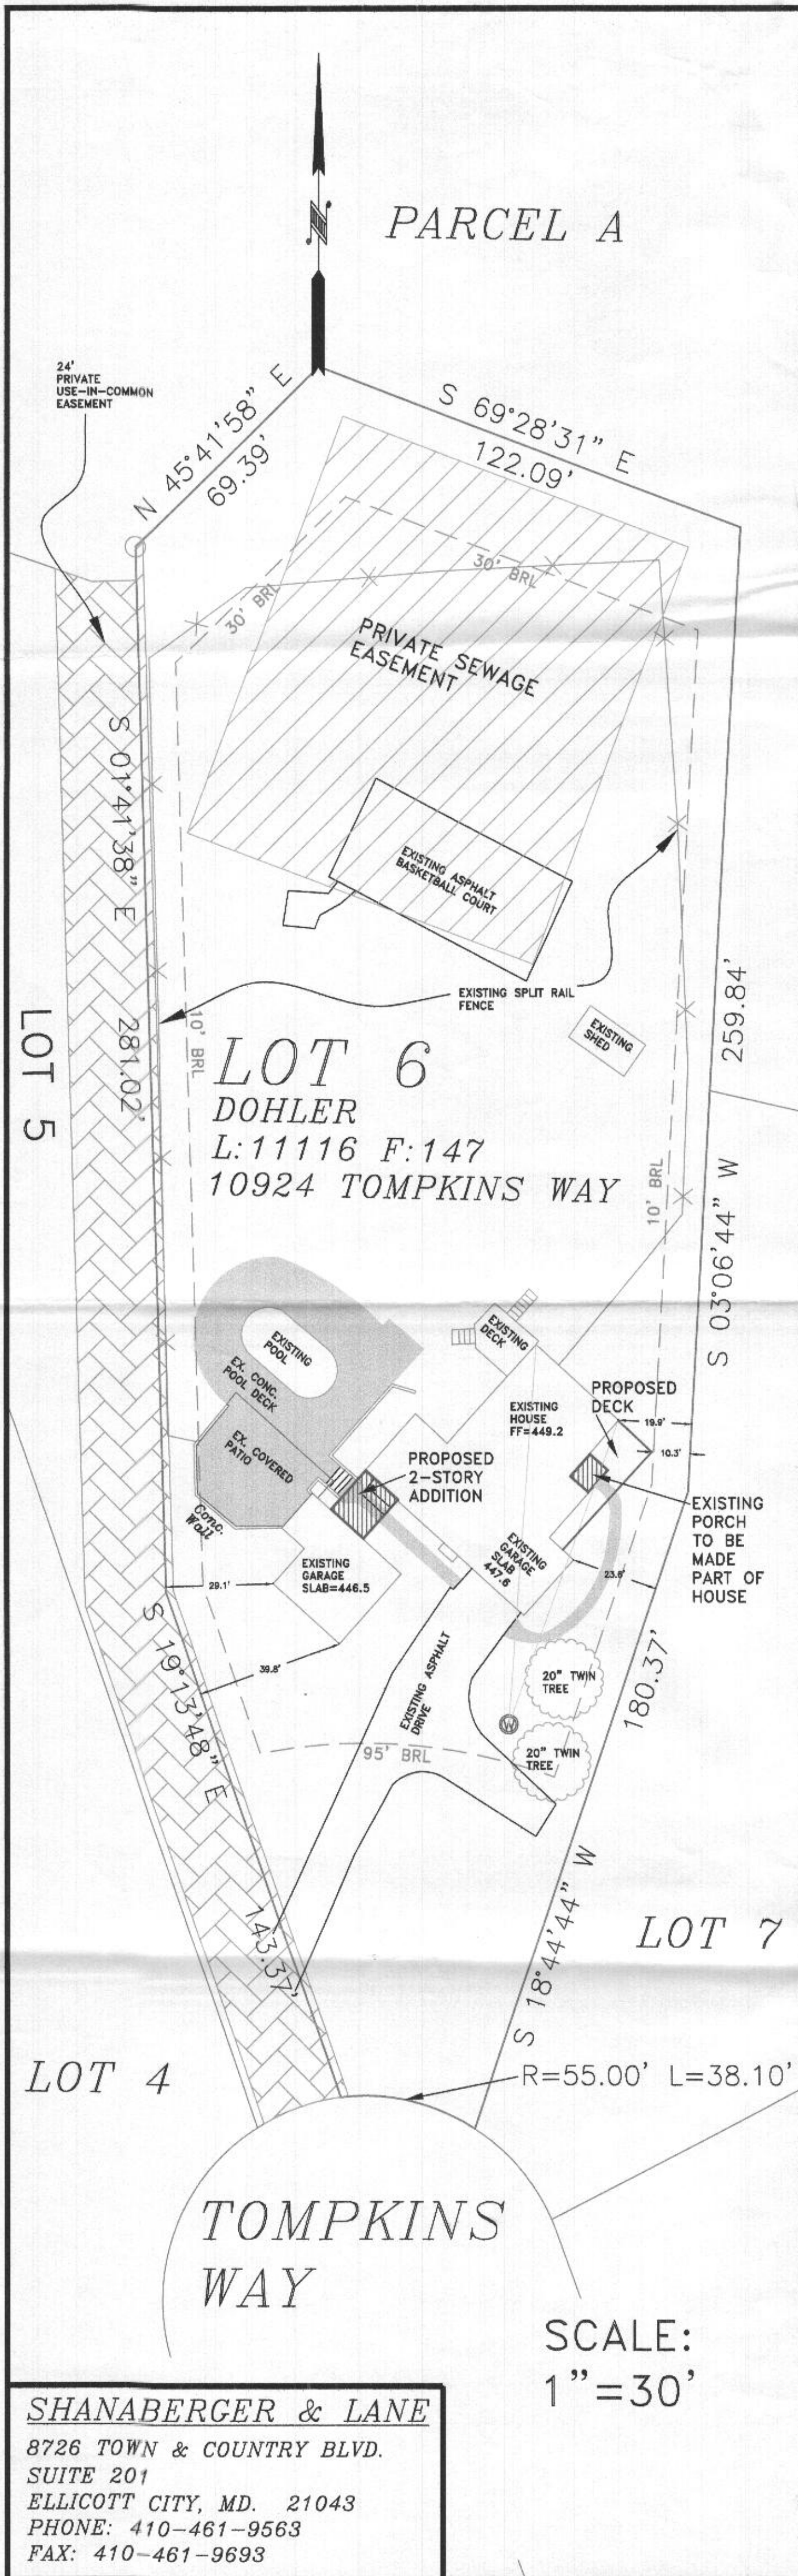

- (1) PROPOSED EXTERIOR WALLS
- (2) EXISTING CONCRETE PORCH (TO BE REMOVED)
- (3) EXISTING EXTERIOR WALL OF HOUSE TO BE REMOVED
- (4) PROPOSED DECK
- (5) EXISTING CONCRETE WALK
- (6) PROPOSED 2 STORY ADDITION
- (7) EXISTING PORCH, STEPS, CONC WALK (TO BE REMOVED)

PROPOSED GRADES: +446.4
EXISTING GRADES: +446.4

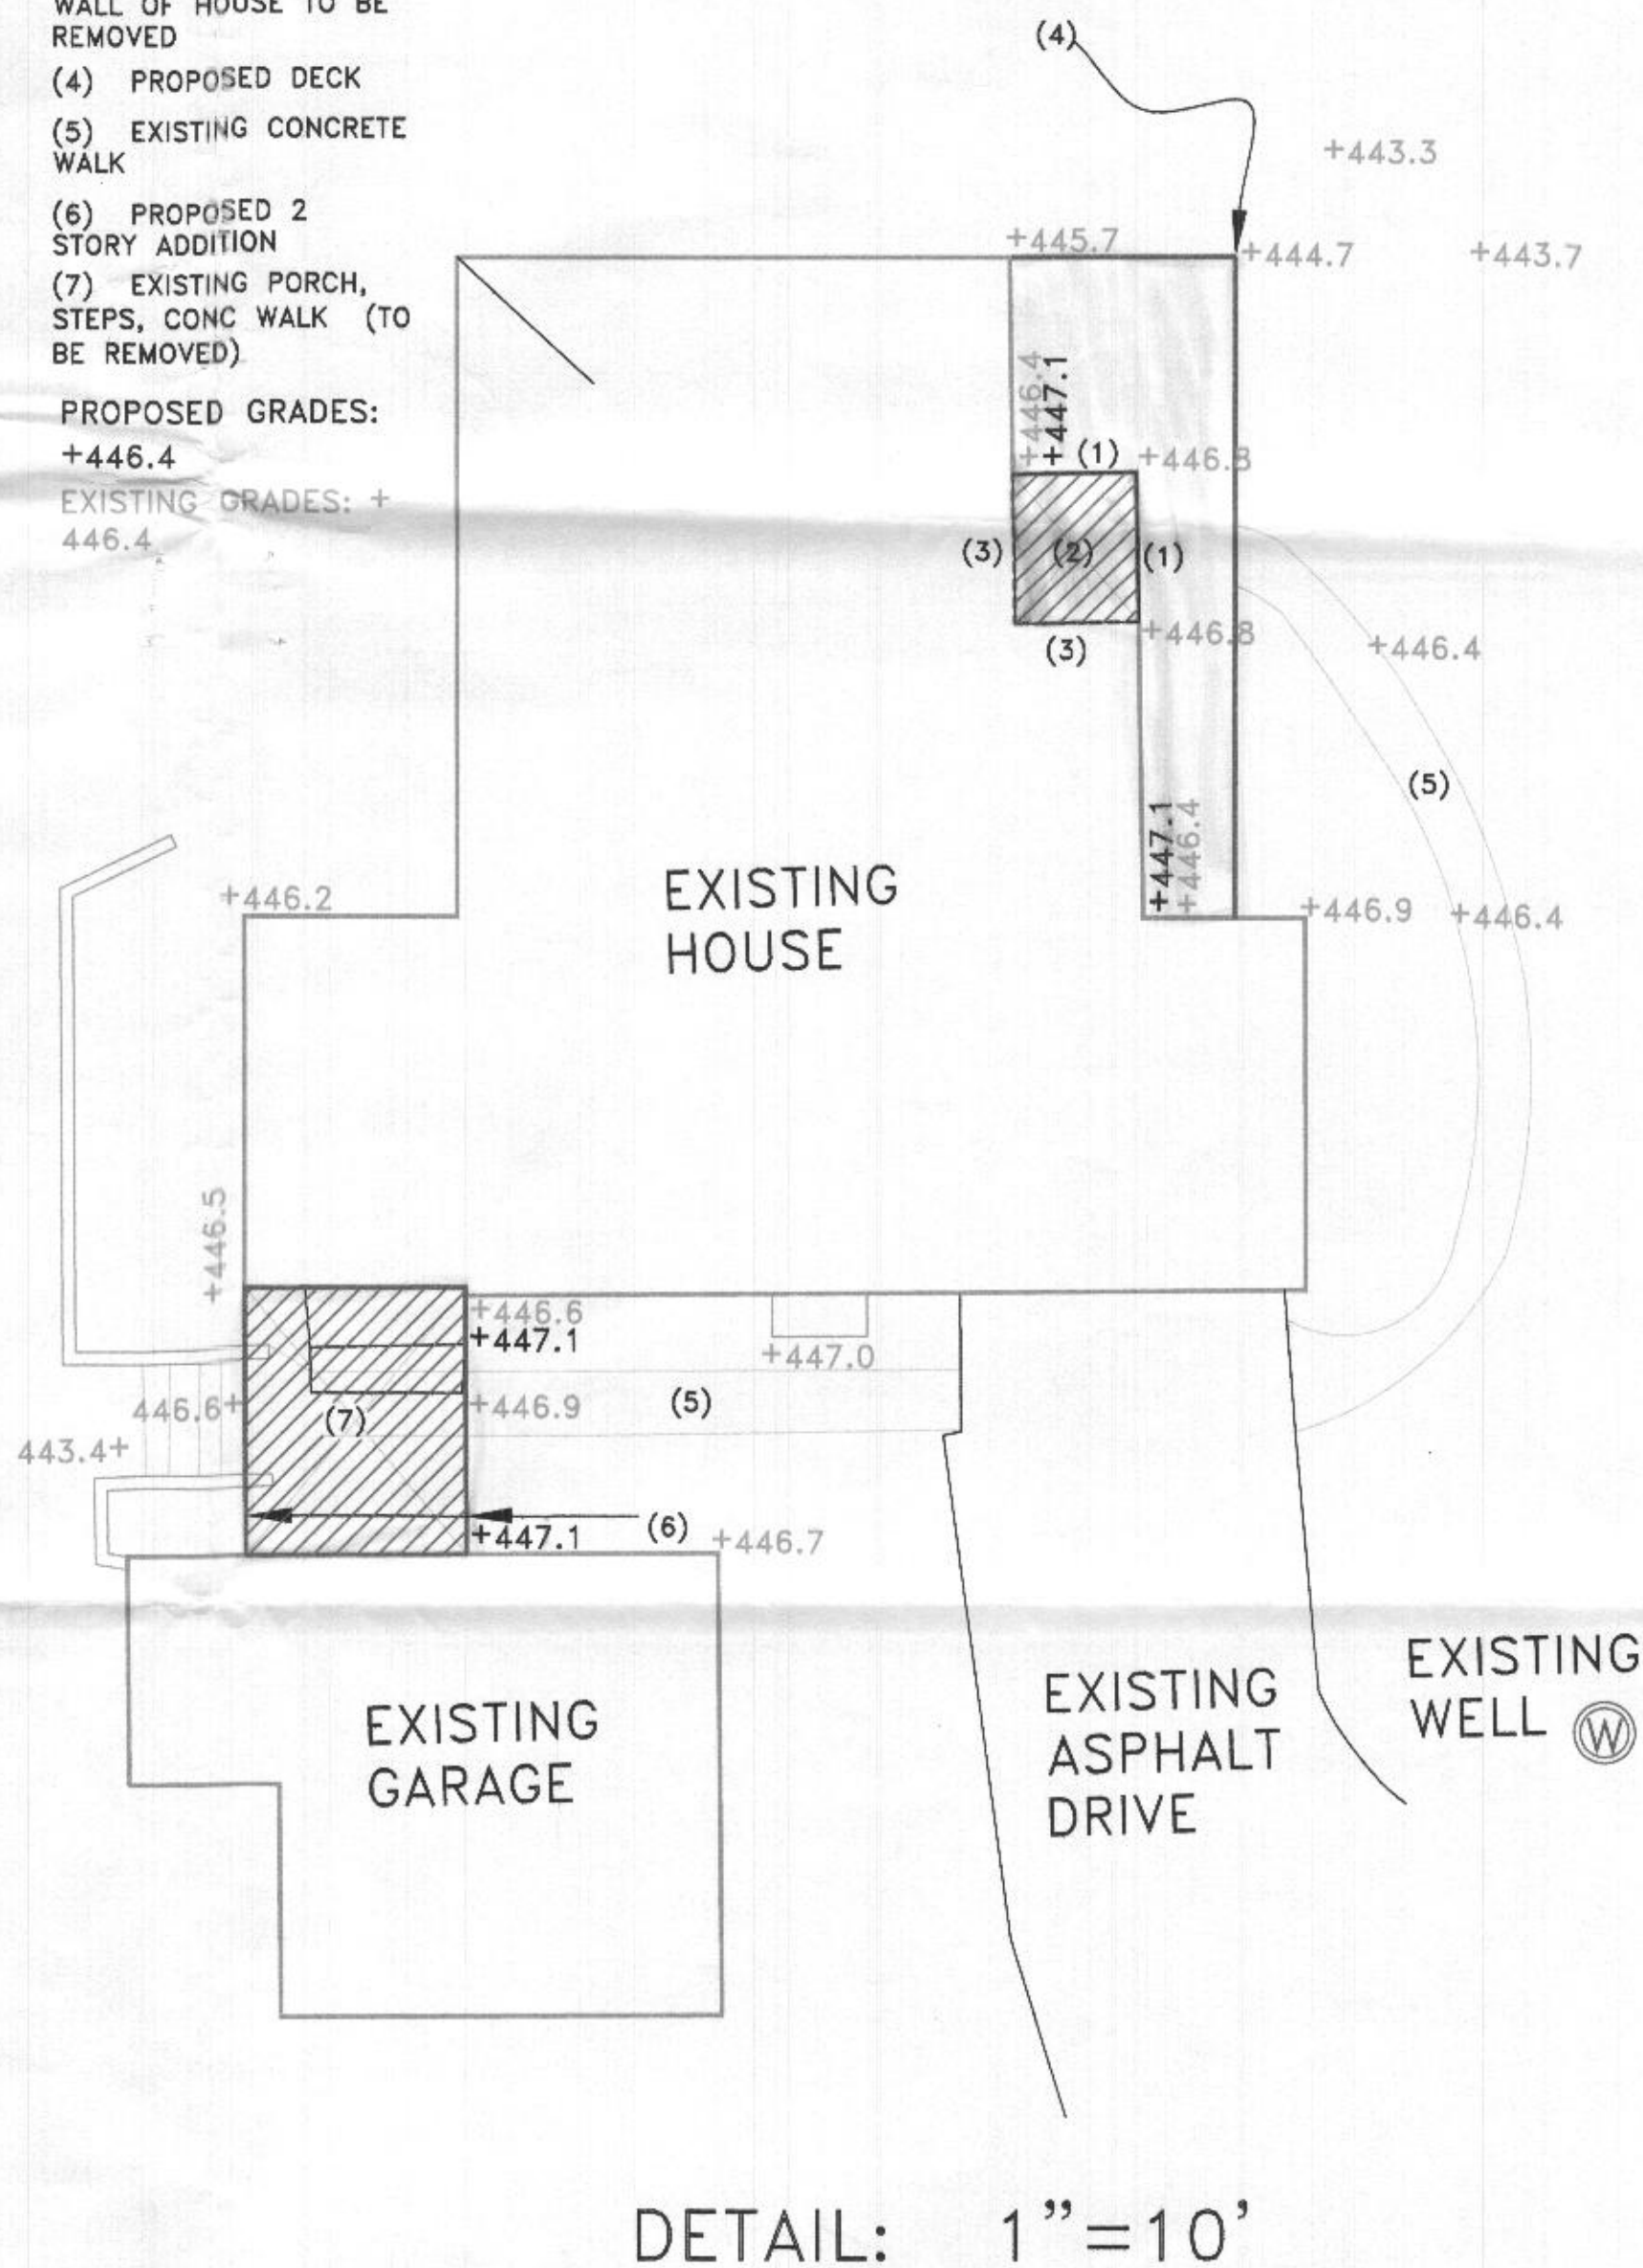

B08002980
garage OK
12/11/08 HS

SHANABERGER & LANE
8726 TOWN & COUNTRY BLVD.
SUITE 201
ELLCOTT CITY, MD. 21043
PHONE: 410-461-9563
FAX: 410-461-9693

OWNER:
RICHARD & BONNA DOHLER
10924 TOMPKINS WAY
WOODSTOCK, MD 21163

SITE PLAN
ADDITIONS TO DOHLER RESIDENCE
LOT 6 PLAT #17067
(THE PRESERVE AT WAVERLY GLEN)
DEED REF: L.11116 F.147
TAX MAP: 10 GRID: 23 PARCEL: 330
ZONING: RCDE0
SCALE: 1" = 30' & 1" = 10'
DATE: 11/04/08