

APPLICATION

PERCOLATION TESTING

A 59898

P _____

HOWARD COUNTY HEALTH DEPARTMENT

BUREAU OF ENVIRONMENTAL HEALTH

3525-H ELLICOTT MILLS DRIVE/ELLICOTT CITY, MARYLAND 21043
TELEPHONE: 313-2640

DISTRICT _____

DATE 3/30/98

TO: THE COUNTY HEALTH OFFICER
ELLICOTT CITY, MARYLAND

I HEREBY APPLY FOR THE NECESSARY TEST PRIOR TO APPLICATION FOR PERMIT TO CONSTRUCT (OR RECONSTRUCT) A SEWAGE DISPOSAL SYSTEM.

PROPERTY OWNER _____

ADDRESS _____ PHONE _____

AGENT OR PROSPECTIVE BUYER Fisher, Collins and Carter

ADDRESS _____ PHONE _____

PROPERTY LOCATION:

SUBDIVISION McCaan Property LOT NO. ~~Prop. Parcel~~ (13)

ROAD AND DESCRIPTION Old Frederick Road

TAX MAP 8 PARCEL # 78

SIZE OF LOT _____ TYPE BLDG. _____
(SINGLE FAMILY DWELLING OR COMMERCIAL)

THE SYSTEM INSTALLED UNDER THIS APPLICATION IS ACCEPTABLE ONLY UNTIL PUBLIC FACILITIES BECOME AVAILABLE. I FULLY UNDERSTAND THE FEE CONNECTED WITH THE FILING OF THIS PERC TEST APPLICATION IS NON-REFUNDABLE UNDER ANY CIRCUMSTANCES. I ALSO AGREE TO COMPLY WITH ALL M.O.S.H.A. REQUIREMENTS IN TESTING THIS LOT.

(SIGNATURE OF APPLICANT)

APPROVED BY _____ FOR _____ DATE _____

DISAPPROVED BY _____ FOR _____ DATE _____

HOLD PENDING FURTHER TESTS _____

REASONS FOR REJECTION OR HOLDING _____

PERCOLATION TEST PLAT/PRELIMINARY PLAT - TITLE OR I.D. # _____ DATE _____

SITE DEVELOPMENT PLAN/FINAL PLAT - TITLE OR I.D. # _____ DATE _____

THIS IS NOT A PERMIT

SQ. FT./BEDROOM

59898
COUNTY #

PREP. PARCEL LOT 13

SOIL PROFILE
100/101

0' topsoil
1' red org
brn
cl fm
4' pale org
tan
sil m
11.5' 5-20%
R. Frag

214


0' topsoil
1' red org
brn
cl fm
4.5' pale pk
brn
sil m
11.5' 20%
Kx
frag

211

0' topsoil
1' red org
brn
cl fm
4' white
sil m
11.5' 10%
frag

SOIL PROFILE

0'

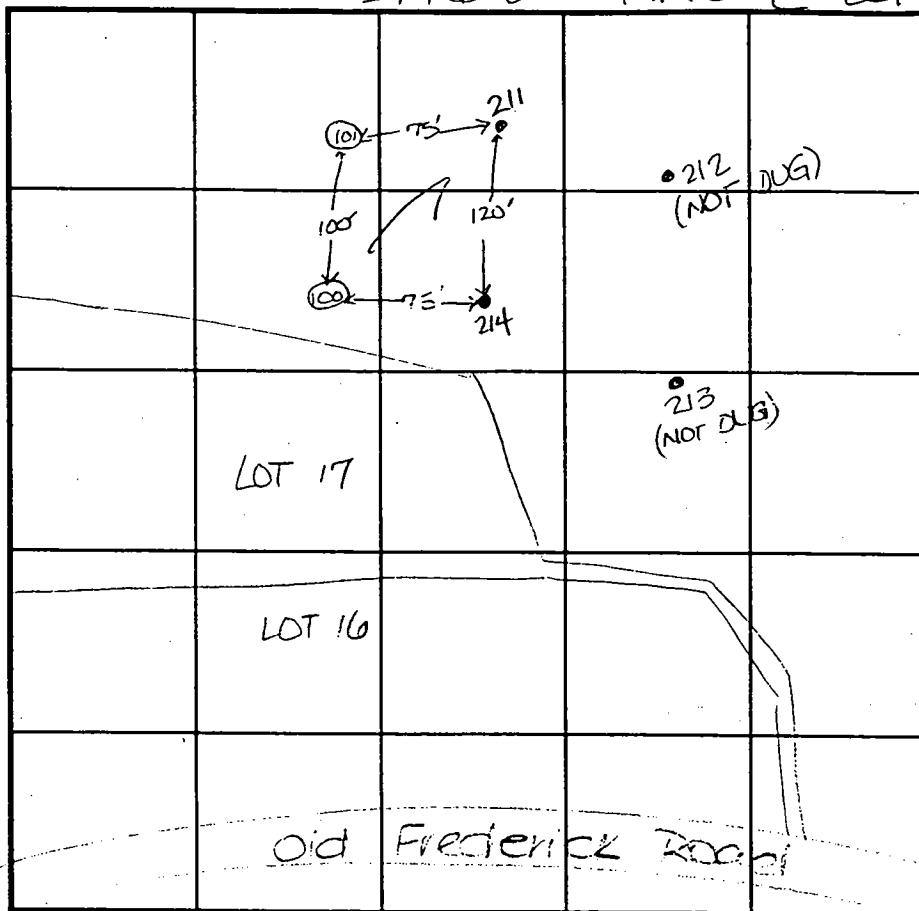

INDICATE NORTH - NAME ADJOINING ROADWAY AS BASE LINE.

DATE	TEST NO.	DEPTH	PRE-WET		TEST - 1" DROP		TIME
			START	STOP	START	STOP	
4-22-72	100	4.0' S	2:25	2:35	2:25	2:37	3
		8.0' M	2:34	2:36	2:36	2:40	4
		11.5' D	Visual				OK
	214	4.5' S	2:31	2:33	2:33	2:36	3
		11.5' D	Visual				OK
	101	12.5' D	Visual				OK
	211	5.5' S	2:44	2:51	2:51	3:01	10
		11.5' D	Visual				OK

REMARKS

TYPE OF SOIL

TESTED BY D. Sre

ALSO PRESENT O. Ketterman Tr & S

TRENCH DESIGN DATA: AVERAGE PERCOLATION TIME 5

TRENCH WIDTH 3

INLET DEPTH 4.0

MAXIMUM BOTTOM DEPTH 6.0

SQ. FT./BEDROOM

180

NON-BUILDABLE
PRESERVATION
PARCEL 'E'
200 Ac.±

PROP. 14 DRIVEWAY
SPEED CALMING
DEVICE

LOT 13
52.198 Sq. Ft.±

Stated
by licensed
surveyor
(K6)

Signed
perc plan
8/1/00

NON-BUILDABLE
PRESERVATION
PARCEL 'E'



Reviewed for HOWARD SCD and meets Technical Requirements.

U.S.D. Natural Resources
Conservation Service

This development plan is approved for soil erosion and sediment control by
the HOWARD SOIL CONSERVATION DISTRICT.

Howard SCD

10/8/02
Date

10/8/02
Date

OWNER

PULTE HOMES
1501 S. EDGEWOOD STREET
BALTIMORE, MD. 21227

PROJECT

McCANN PROPERTY

PLAT

16

BLOCK NO.

RC-DEO

ZONE

8

TAX/ZONE

FOURTH

ELEC. DIST.

FOURTH

CENSUS TR.

FOURTH

SECTION/AREA

N/A

LOT NO.

LOTS 1-16 AND
BUILDABLE
PRESERVATION
PARCEL 'B'

**SITE DEVELOPMENT
SEDIMENT AND EROSION CONTROL PLAN**

**McCANN PROPERTY
LOTS 1-16 AND PARCEL B**

TAX MAP No: 8 PARCEL: 78
FOURTH ELECTION DISTRICT, HOWARD COUNTY, MARYLAND
SCALE: 1" = 50' DATE: OCTOBER, 2002
SHEET 2 OF 3

G.P. 03-10