

**COMPLETE THIS FORM WHEN DROPPING OFF ANY
CORRESPONDENCE AND/OR PLANS TO THE HOWARD COUNTY
DEPARTMENT OF INSPECTIONS, LICENSES AND PERMITS COUNTER:**

Date: 05/06/2022

To: Jim Hobson *cc: Health Dept* DILP
(Reviewer/Requestor's Name) (Division)

From: Brian J Spencer (410) 428-7711
(Your Name, Company Name) (Phone Number)

Subject: Project name Temple Isaiah - Addition
Project site address 12200 Scaggsville Road, Fulton MD 20759
Permit # B21004881 SDP # SDP-02-155
Other information pertinent to this project _____

✓ Please check the attachments below that you are submitting with this transmittal:

- ☒ Letter of response to address plan review comment letter
- ☒ Revised plans and/or revised details: When submitting for a complete re-review, **duplicate sets shall be submitted.**
- ☐ Letter Summarizing Changes
- ☐ Energy conservation calculations
- ☐ Copies of _____ (be specific).
☐ Health Department Request ☐ DPZ/ DED Request ☐ Applicant's Request
- ☐ Two sets of single-family model plans to be placed on permanent file: Model Name/ # _____
- ☐ Other _____

Contact Person Information: (Required)

Brian Spencer Telephone No: (410) 428-7711
Please Print Name E-Mail Address: brianspencer@dmggroup.net

PLEASE ASSURE ALL DOCUMENTS AND/OR REVISIONS ARE APPROPRIATELY SIGNED AND SEALED, IF NECESSARY, BY A LICENSED ARCHITECT OR ENGINEER. PLEASE BE ADVISED THAT INSUFFICIENT INFORMATION MAY RESULT IN THE DELAY OF REVIEW BY THE PLANS EXAMINER. THE DEPARTMENT OF INSPECTIONS, LICENSES AND PERMITS WILL CONTACT YOU IF THERE IS A PROBLEM. IN ADDITION, ONCE THE BUILDING PERMIT IS APPROVED BY THE PLAN REVIEW DIVISION AND ALL OTHER REQUIRED SIGNATORY AGENCIES, AND THE BUILDING PERMIT IS READY FOR ISSUANCE, THE PERMIT DIVISION WILL NOTIFY THE APPROPRIATE CONTACT PERSON FOR PERMIT PICK UP. ALL PERMIT STATUS INQUIRIES SHALL BE DIRECTED TO THE PERMIT DIVISION AT 410-313-2455 OPTION #4 OR BY VISITING MYHOWARD.INFO. CODE RELATED QUESTIONS AND PLAN REVIEW INQUIRIES SHALL BE DIRECTED TO THE PLAN REVIEW DIVISION AT 410-313-2436. PLEASE ALLOW A MINIMUM OF FIVE (5) WORKING DAYS FOR ANY PLAN SUBMITTALS TO BE REVIEWED. THANK YOU.

Received by _____

White-Plan Review / Yellow-Applicant / Pink-Permit Division
T:\Operations\Updated forms\HoCoTransmittalForm04.2020

*Rev # 6
\$200.00 fee
1424 - Andrew
Spencer.*

**Permit #B21004881 Response,
Permit Comments
Narrative Letter 4**

Date	April 29, 2022
Project	Temple Isaiah

James Hobson
Engineering Specialist
Howard County Department of Inspections, Licenses and Permits.

Please see below a narrative for responses to Permit #B21004884 Comments received on April 26th, 2022.
All Updates are included on drawings and remarked with clouds and with Delta 4 at resubmitted drawings.

- 1- Provide courtyard trellis structural plans or remove them from all plans, design live loads shall be included on the plans

RESPONSE

- *A signed and sealed drawings have been included on the response package for this Permit Revision*

- 2- Flush bolts on door 114C are not permitted in Assembly occupancy.

RESPONSE

- *Flush bolts have been removed from the set*

- 3- Door hardware set 06A and 10, on doors 178B and 181A, contains ---Concealed Vert Rod Exit, Dummy. This door is required to have panic hardware on both leaves. Please explain the use of Dummy in the description.

RESPONSE

- *The word Dummy is just to identify the type of hardware, proper naming has been included on the hardware sets literature*

- 4- Door hardware set 04 is described as Rim Exit device, storeroom. Please explain the use of storeroom in the description.

RESPONSE

- *The word storeroom is just to identify the type of hardware, proper naming has been included on the hardware sets literature*

- 5- Door hardware set 03 is describe with-- concealed vert rod exit, nightlatch. Please explain the use of nightlatch in the description.

RESPONSE

- *The word nightlatch is just to identify the type of hardware, proper naming has been included on the hardware sets literature*

- 6- Door hardware set 13 is described with --concealed vert rod exit, Classroom. Please explain the use of Classroom in the description.

RESPONSE

- *The word classroom is just to identify the type of hardware, proper naming has been included on the hardware sets literature*

- 7- Door hardware set 15 is described with --surface vert rod exit, Passage. Please explain the use of Passage in the description.

RESPONSE

- *The word passage is just to identify the type of hardware, proper naming has been included on the hardware sets literature*

- 8- Drawing E201LC has an exit sign located in front of an existing door directing occupants to exit thru the sanctuary 103. Please remove this exit sign.

RESPONSE

- *Exit sign have been removed*

- 9- Drawing E201LA has an exit sign located at a door located in corridor 156 into a multi-Purpose room 145. Exiting thru this room is not permitted.

RESPONSE

- *Exit sign have been removed*

10- Drawing E201L does not have an exit sign in front of corridor door 123. Please provide an exit sign or explain

RESPONSE

- *Exit sign has been added.*

Please don't hesitate to contact us if you might have a comment.
Sincerely

Maria Gorodetskaya

FULTON MD 20759

	CEILING TAG		BRICK
	INTERIOR WALL TYPE TAG		CONCRETE MASONRY
	GRID LINE		SAND / GYPSUM / MORTAR / GROUT / PLASTER
	ROOM TAG		CONCRETE
	DOOR TAG		STEEL / FERROUS METAL
	WINDOW TAG		ALUMINUM / NON-FERROUS METAL
	KEYNOTE TAG		FINISH WOOD
	SECTION TAG		PLYWOOD
	DETAIL SECTION TAG		RIGID INSULATION
	EXTERIOR ELEVATION TAG		BATT INSULATION
	INTERIOR ELEVATION TAG		GRAVEL
	DETAIL CALLOUT		EARTH
	CENTER LINE		
	PROPERTY LINE		
	LEVEL TRANSITION		
	FLOOR FINISH TRANSITION TAG		
	SMOKE DETECTOR		
	REVISION TAG & CLOUD		

THE TEMPLE ISAIAH ADDITION INCLUDES A SINGLE STORY CHAPEL / CLASSROOM, LOUNGE, CORRIDOR, STORAGE AREA AND THE ENCLOSURE OF A COURTYARD FOR A MULTIPURPOSE SPACE.

SHEET NUMBER	SHEET NAME	100% DD - 08/01/2020	75% CD - 12/11/2020	100% CD - 01/15/2021	PERMIT SET 12/07/2021	PERMIT REVISION 1 03/21/2022	PERMIT REVISION 2 04/01/2022	PERMIT REVISION 3 04/01/2022	PERMIT REVISION 4 04/29/2022
00	GENERAL INFORMATION								
G000	COVER SHEET	●	●	●	●	●	●	●	
G002	CODE COMPLIANCE	●	●	●	●	●	●	●	
G121	EGRESS DIAGRAMS		●	●	●	●	●	●	
G150	ACCESSIBILITY STANDARDS		●	●	●	●	●	●	
G151	SIGNAGE		●	●	●	●	●	●	
03	CIVIL								
C001	CIVIL GRADING SEEDIMMET & EROSION CONTROL PLAN	●	●	●	●	●	●	●	
05	LANDSCAPE								
L0101	LANDSCAPE PLAN - COURTYARD		●	●	●	●	●	●	
L0102	LANDSCAPE PLAN - RAIN GARDEN		●	●	●	●	●	●	
LE103	PLANTING DETAILS, PLANT SCHEDULE AND NOTES		●	●	●	●	●	●	
06	ARCHITECTURAL DEMOLITION								
D101	ARCHITECTURAL DEMOLITION FLOOR PLAN	●	●	●	●	●	●	●	
D102	ARCHITECTURAL DEMOLITION ROOF PLAN	●	●	●	●	●	●	●	
D151	ARCHITECTURAL DEMOLITION REFLECTED CEILING PLAN	●	●	●	●	●	●	●	
07	ARCHITECTURAL								
A101	FLOOR PLAN	●	●	●	●	●	●	●	
A102	ROOF PLAN	●	●	●	●	●	●	●	
A103	REFLECTED CEILING & LIGHTING PLANS	●	●	●	●	●	●	●	
A201	EXTERIOR ELEVATIONS	●	●	●	●	●	●	●	
A202	EXTERIOR ELEVATIONS	●	●	●	●	●	●	●	
A301	BUILDING SECTIONS	●	●	●	●	●	●	●	
A310	WALL SECTIONS- SOUTH ADDITION	●	●	●	●	●	●	●	
A311	WALL SECTIONS-SOCIAL HALL	●	●	●	●	●	●	●	
A312	WALL SECTIONS- SOCIAL HALL/ SOUTH ADDITION	●	●	●	●	●	●	●	
A313	WALL SECTIONS-NORTH ADDITION	●	●	●	●	●	●	●	
A351	DETAILS	●	●	●	●	●	●	●	
A352	DETAILS-ROOF	●	●	●	●	●	●	●	
A353	DETAILS-EIPS	●	●	●	●	●	●	●	
A355	DETAILS	●	●	●	●	●	●	●	
A501	INTERIOR ELEVATIONS - FAMILY RESTROOM	●	●	●	●	●	●	●	
A502	INTERIOR ELEVATIONS	●	●	●	●	●	●	●	
A503	MECHANICAL ALCOVE	●	●	●	●	●	●	●	
A511	ENLARGED PLAN DETAILS	●	●	●	●	●	●	●	
A600	FINISH LEGENDS & SCHEDULES	●	●	●	●	●	●	●	
A741	MILLWORK DETAILS	●	●	●	●	●	●	●	
A742	MILLWORK	●	●	●	●	●	●	●	
A751	CEILING & PLENUM DETAILS	●	●	●	●	●	●	●	
A807	WALL, ROOF, CEILING TYPES-EXTERIOR, INTERIOR	●	●	●	●	●	●	●	
A811	INTERNAL PARTITION DETAILS	●	●	●	●	●	●	●	
A821	DOOR, FRAME & HARDWARE SCHEDULE & LEGENDS	●	●	●	●	●	●	●	
A822	DOOR HARDWARE	●	●	●	●	●	●	●	
A830	WINDOW SCHEDULE	●	●	●	●	●	●	●	
A901	INTERIORS FURNITURE	●	●	●	●	●	●	●	
10	STRUCTURAL								
S001	STRUCTURAL NOTES	●	●	●	●	●	●	●	
S002	SPECIAL INSPECTIONS SCHEDULES	●	●	●	●	●	●	●	
S003	SPECIAL INSPECTIONS SCHEDULES	●	●	●	●	●	●	●	
S101	FOUNDATION PLAN	●	●	●	●	●	●	●	
S102	JOIST FRAMING PLAN	●	●	●	●	●	●	●	
S201	DOOT LOADING DIAGRAMS	●	●	●	●	●	●	●	
S301	CONCRETE SECTIONS & DETAILS	●	●	●	●	●	●	●	
S302	CONCRETE SECTIONS & DETAILS	●	●	●	●	●	●	●	
S303	CONCRETE SECTIONS & DETAILS	●	●	●	●	●	●	●	
S401	STEEL SECTIONS & DETAILS	●	●	●	●	●			


GOOD

KEYED NOTES:

1. PROVIDE NEW LIGHTING FIXTURE INCLUDING WIRING AND CONDUIT AS SHOWN. FOR EXACT LOCATION AND MOUNTING HEIGHT OF THE LIGHTING FIXTURE, SEE ARCHITECTURAL DRAWINGS. FOR LIGHTING SWITCH LOCATION, COORDINATE WITH OWNER.
2. PROVIDE JUNCTION BOX TO POWER THE EXISTING RELOCATED NER TAMID INCLUDING WIRING CONDUIT. FOR EXACT LOCATION OF NER TAMID, SEE ARCHITECTURAL DRAWINGS.
3. CONNECT NEW EXIT AND EMERGENCY LIGHT WITH NEARBY EXISTING LIGHTING FIXTURE CIRCUIT AHEAD OF THE LIGHT SWITCH.

DRAWING NOTES:

- A. FOR SYMBOLS, ABBREVIATIONS AND GENERAL NOTES SEE DRAWING E001.
- B. FOR ENLARGED LIGHTING PLAN - NEW WORK, SEE DRAWING E201LA, E201LB AND E201LC.
- C. FOR PANEL SCHEDULES AND POWER RISER DIAGRAM, SEE DRAWING E501.

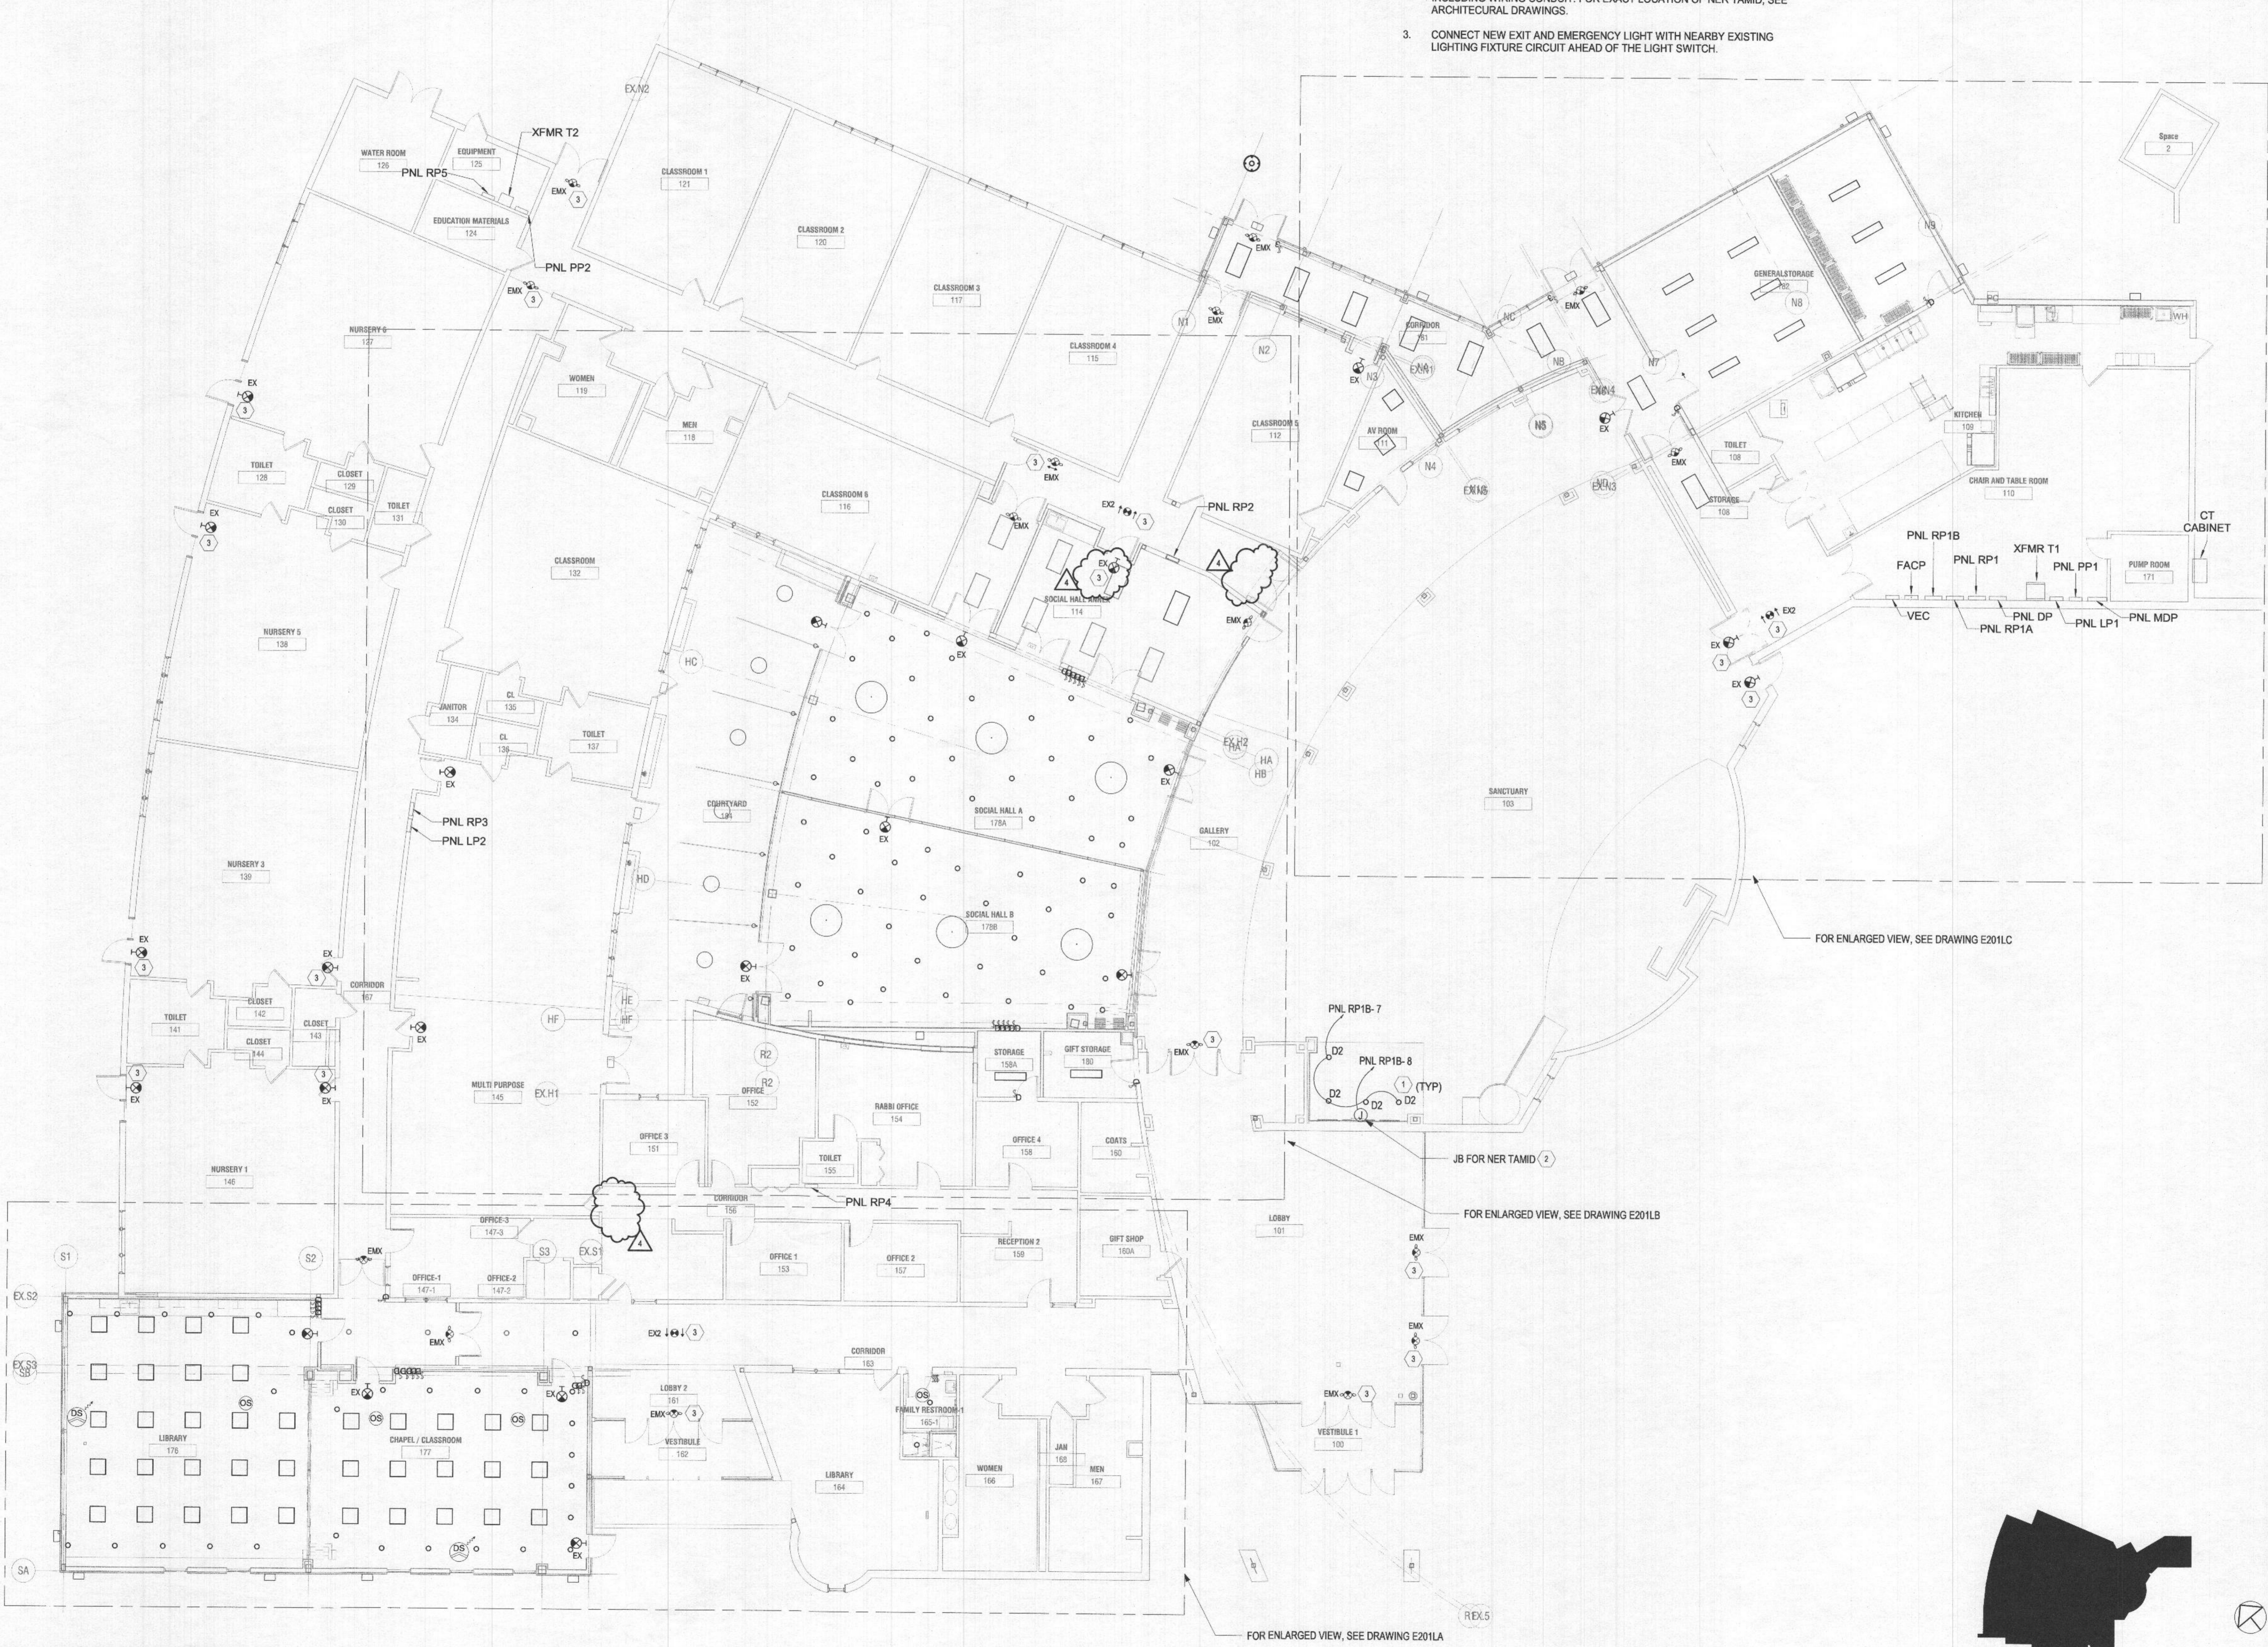

1 ELECTRICAL OVERALL FIRST FLOOR LIGHTING PLAN
1/8" = 1'-0"

2 KEY PLAN
NOT TO SCALE

SHinberg.levinas

Shinberg Levinas 5101 Wisconsin Ave #310 1 202.244.5101
Architectural Design Inc. Washington, DC 20016 F 202.244.5365

Designs and drawings are protected by copyright, and may not be copied, reproduced or otherwise used without the express written consent of the entity above.
© Copyright 2022 Shinberg Levinas Architectural Design Inc.
All rights reserved worldwide.

TEMPLE ISAIAH

12200 SCAGGSVILLE ROAD
FULTON, MARYLAND 20759

OWNER

TEMPLE ISAIAH
1200 SCAGGSVILLE ROAD
FULTON, MD 20759
(301) 317-1101

OWNER'S REPRESENTATIVE

DEVELOPMENT MANAGEMENT GROUP, LLC
5054 DORSEY HALL DRIVE, SUITE 204
ELLIOT CITY, MD 21042
(410) 884-5393

CIVIL ENGINEER

FSH ASSOCIATES LLC
6339 HOWARD LANE
ELK RIDGE, MD 21075
(410) 567-5200

STRUCTURAL ENGINEER

KYFF
2000 M STREET, NW, SUITE 750-F
WASHINGTON, DC 20036
(202) 325-0100

M/P ENGINEER & FIRE SAFETY

FRIEDMAN ENGINEERING
11700 FULHAM STREET
SILVER SPRING, MD 20902
(301) 298-5070

ELECTRICAL ENGINEER

ASTUTE ENGINEERING
8400 TYCO ROAD, SUITE D
VIENNA, VA 22182
(202) 400-2004

ACOUSTIC CONSULTANT

ACOUSTIC 2
6208 MCASSETT ROAD
BETHESDA, MD 20816
(202) 244-4646

LANDSCAPE CONSULTANT

SAGE STUDIO DESIGN & PLANNING
3340 NORTHAMPTON STREET, NW
WASHINGTON, DC 20015
(202) 460-1662

ISSUES

NO.	ISSUE	DATE
1	100% CONSTRUCTION DOCUMENTS	01.15.2021
2	PERMIT SET	12.07.2021
3	PERMIT COMMENTS 1	01.21.2022
4	PERMIT REVISION 3	04.01.2022
5	PERMIT REVISION 4	04.29.2022

SEAL



PROFESSIONAL CERTIFICATION: I HEREBY CERTIFY THAT THESE DOCUMENTS WERE PREPARED OR APPROVED BY ME, AND THAT I AM A LICENSED PROFESSIONAL ENGINEER UNDER THE LAWS OF THE STATE OF MARYLAND.
LICENSE NO. 45093 EXPIRATION DATE: 02/24/2024

DATE: 04/29/2022

SCALE: 1/8" = 1'-0"

ELECTRICAL OVERALL
FIRST FLOOR LIGHTING
PLAN
RECEIVED
MAY 06 2022
LICENSES & PERMITS
E201L