



Howard County  
Health Department

**Bureau of Environmental Health**

8930 Stanford Boulevard, Columbia, MD 21045

Main: 410-313-2640 | Fax: 410-313-2648

TDD 410-313-2323 | Toll Free 1-866-313-6300

[www.hchealth.org](http://www.hchealth.org)

Facebook: [www.facebook.com/hocohealth](https://www.facebook.com/hocohealth)

Maura J. Rossman, M.D., Health Officer

RECEIPT DATE: 4/13/22

**ONSITE SEWAGE DISPOSAL SYSTEM**

P 571497

APPROVAL DATE: 06/06/2022

**PERMIT:**

**REPAIR**

A

PROPERTY ADDRESS: 15064 Bushy Park Road

SUBDIVISION: \_\_\_\_\_

LOT: \_\_\_\_\_

TAX ID: \_\_\_\_\_

CONTRACTOR: Bill Ingram/ Farm and Home Excavating

EMAIL: \_\_\_\_\_

CONTRACTOR ADDRESS: 901 Driver Road, Marriottsville, MD 21104

PHONE: 410-795-5670

PROPERTY OWNER: Doug AND Amy Burns

EMAIL: \_\_\_\_\_

OWNER ADDRESS: 15064 Bushy Park Road, Woodbine, MD 21797

PHONE: \_\_\_\_\_

SEPTIC TANK SIZE (GALLONS): 1500g

PUMP CHAMBER CAPACITY (GALLONS): N/A

PUMP SIZE: \_\_\_\_\_

NUMBER OF BEDROOMS: 3

HOUSE SQ. FT. \_\_\_\_\_

APPLICATION RATE: \_\_\_\_\_

DISTRIBUTION SYSTEM: GRAVITY FED ☒

LOW PRESSURE DOSED ☐

TRENCHES:	LINEAR FEET REQUIRED: <u>N/A</u>	INLET DEPTH: _____
	TRENCH WIDTH: _____	MAXIMUM BOTTOM DEPTH: _____
	MINIMUM SPACE BETWEEN TRENCHES: _____	EFFECTIVE AREA BEGINNING DEPTH: _____
LOCATION:	TO BE STAKED BY SANITARIAN DURING PRE-CONSTRUCTION INSPECTION.	
NOTES:	<u>Location of new S.T. to be proposed @ pre-construction.</u>	

ISSUED BY: K. Wolf

ISSUE DATE: 4/13/22

EXPIRATION DATE: 4/13/23

**NOTE: CONTRACTOR MUST SCHEDULE A PRE-CONSTRUCTION INSPECTION PRIOR TO BEGINNING ANY INSTALLATION**

**NOTE: CONTRACTOR MUST SCHEDULE AN INSPECTION AND GAIN APPROVAL OF ALL COMPONENTS PRIOR TO COVERING**

**NOTE: STONE MUST BE APPROVED BY HEALTH DEPARTMENT AND GRAVEL TICKET MUST BE AVAILABLE FOR REVIEW.**

**NOTE: WATERTIGHT SEPTIC TANKS REQUIRED**

**NOTE: ALL PARTS OF SEPTIC SYSTEM SHALL BE AT LEAST 100 FEET DOWNGRADE FROM ANY WATER WELL**

**NOTE: MANHOLE RISERS REQUIRED ON ALL SEPTIC TANKS AND PUMP CHAMBERS**

**NOTE: AN ELECTRICAL PERMIT IS REQUIRED FOR INSTALLATION OF ANY ELECTRICAL COMPONENTS OF THE SYSTEM**

☒ ELECTRICAL PERMIT ISSUED E N/A

**NOTE: THE HCHD DOES NOT WARRANTY ANY SYSTEM AND CANNOT GUARANTEE THE PERFORMANCE OF THIS SYSTEM AS DESIGNED. BY ACCEPTING THIS PERMIT, THE OWNER AND/OR APPLICANT ACKNOWLEDGE THAT THE SPECIFICATIONS DETAILED IN THIS DESIGN ARE ONE POSSIBLE OPTION AND THAT THE HCHD WILL REVIEW OTHER PROPOSALS. YOU HAVE THE OPTION TO SEEK THE ADVICE OF A QUALIFIED DESIGN CONSULTANT OR PROFESSIONAL ENGINEER FOR FURTHER GUIDANCE.**


**NOTE: MDE RECOMMENDS SEPTIC TANKS, BAT, AND OTHER PRETREATMENT UNITS BE PUMPED AT A FREQUENCY ADEQUATE TO ENSURE THAT SOLIDS ARE NOT DISCHARGED TO THE DISPOSAL AREA**

**NEITHER THE HOWARD COUNTY COUNCIL NOR THE HEALTH DEPARTMENT IS RESPONSIBLE FOR THE SUCCESSFUL OPERATION OF ANY SYSTEM.**

**PERMITTEE RESPONSIBLE FOR OBTAINING FINAL APPROVAL ON THIS PERMIT.**

**CALL 410-313-1771 TO SCHEDULE INSPECTIONS.**

NOT TO SCALE

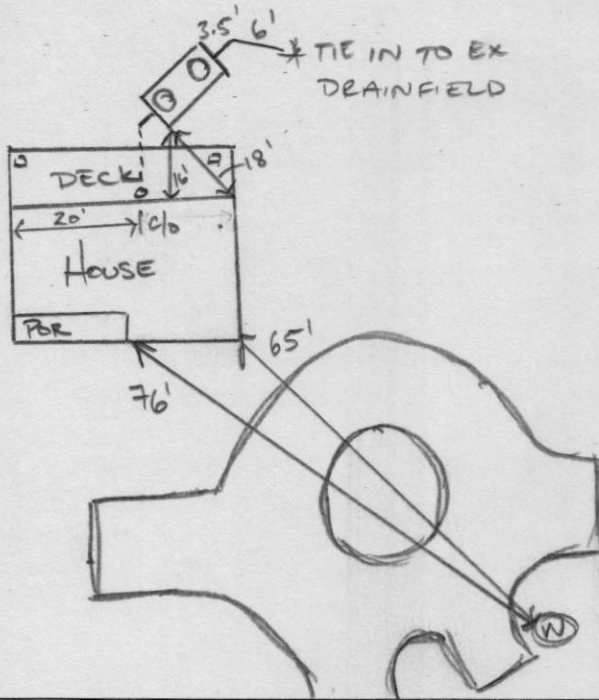

ROAD NAME  
BUSHY PARK ROAD

**TRENCH/DRAINFIELD DATA**

WIDTH INLET BOTTOM

NUMBER OF TRENCHES \_\_\_\_\_  
TOTAL LENGTH \_\_\_\_\_  
ABSORPTION AREA \_\_\_\_\_  
DISTRIBUTION BOX LEVEL \_\_\_\_\_  
DISTRIBUTION BOX BAFFLE \_\_\_\_\_  
DISTRIBUTION BOX PORT \_\_\_\_\_

**SEPTIC TANK DATA**

SEPTIC TANK 1 LEVEL YES  
MANUFACTURER BABYLON  
CAPACITY 1500 GAL  
SEAM LOC TOP  
TANK LID DEPTH 25" - 21"  
BAFFLES YES  
BAFFLE FILTER —  
MANHOLE LOC FRONT/BACK  
6" PORT LOC —  
WATERTIGHT TEST —  
SLOTTED YES  
DATE ON LID 03/21/2022

PUMP/SEPTIC TANK LEVEL \_\_\_\_\_

MANUFACTURER \_\_\_\_\_  
CAPACITY \_\_\_\_\_ GAL  
SEAM LOC \_\_\_\_\_  
TANK LID DEPTH \_\_\_\_\_  
BAFFLES \_\_\_\_\_  
BAFFLE FILTER \_\_\_\_\_  
MANHOLE LOC \_\_\_\_\_  
6" PORT LOC \_\_\_\_\_  
WATERTIGHT TEST \_\_\_\_\_  
SLOTTED \_\_\_\_\_  
DATE ON LID \_\_\_\_\_

PRE-CONSTRUCTION:

INSTALLATION: 06/06/2022 TANK SET AND TIED INTO EX SL AND EFF. LINE TO DRAINFIELD. (JP)

SOIL @ TANK PIT VERY ROCKY; BEDDED REP TANK IN STONE. (JP)

FINAL INSPECTOR

DATE OF APPROVAL 06/06/2022

**RECEIPT**

Howard County, MD  
HOWARD COUNTY HEALTH DEPARTMENT  
ASCEND ONE BUILDING  
Columbia, MD 21045  
8930 STANFORD BLVD

Application: WS-SP-APP-22-00090

Application Type: EnvHealth/Well and Septic/Sewage Disposal System/Application

Address: 15064 Bushy Park RD,

---

Receipt No.	3581					
Payment Method	Ref Number	Amount Paid	Payment Date	Cashier ID	Received	Comments
Check	19064	\$165.00	04/18/2022	JUKING		15064 Bushy Park/ Tank Replacement
Work Description:	15064 Bushy Park					

Maura J. Rossman, M.D., Health Officer

**INFORMATION FORM - SEPTIC SYSTEM REPAIR/UPGRADE**

**Reason for Request:**

- ☐ Failing System
- ☐ System relocation for proposed addition
- ☐ System upgrade for proposed addition
- ☐ Inadequate treatment zone
- ☒ Collapsed septic tank *Leaking*
- ☐ Collapsed drywell

**Has the septic tank been pumped within the last month?**

☒ Yes      Date pumped: 2/22  
☐ No

**Was a visual inspection of the septic tank and/or drain fields conducted?**

☒ Yes      Explain observation: Tank level  
☐ No      below inlet

**Existing system design**

- ☐ Drywell
- ☐ Trench
- ☐ Mound
- ☐ Unknown
- ☐ Other: \_\_\_\_\_

**Was a visual inspection of the sewage line conducted?**

☐ Yes  
☒ No

**Blockage Leading to the field**

☐ Yes      Explain \_\_\_\_\_  
☒ No

**Is discharge surfacing on the ground?**

☐ Yes  
☒ No

**Additional Comments:**

Septic Tank Leaking

\*For REPAIRS, are the owners proposing, or do they plan to add in the future any additions or modifications to the property, i.e. pools, living space additions, garages, etc? This information must be disclosed at the time of this application. The Health Department will not be able to accommodate requests in the field for property modifications unrelated to the repair request. Such requests may require an additional fee, testing, and submittal of a Percolation Certification Plan, if the property does not meet current Code and Regulations.

Septic Contractor: Farm and Home Excavation      Contractor's Phone: 410-984-0189  
Contractor's Address: 901 Driver Rd Marriottsville MD 21104  
Property Address: 15064 Bushy Park Rd      County File: \_\_\_\_\_  
Subdivision: Richard Talley Property      Lot: \_\_\_\_\_ Year Built: \_\_\_\_\_  
Owner's Name: Doug & Amy Burns      Existing bedrooms: 3  
Name of previous owners: None      Existing bedrooms: \_\_\_\_\_  
Proposed bedrooms: \_\_\_\_\_

\*A Sanitarian will be in contact within three business days, depending upon the urgency of the situation, to coordinate the scheduling/review of the repair or upgrade.

\*Prior to scheduling inspections, scaled plans should be submitted to clarify the nature of the addition.\*

Print out a copy of Real Property Data via Dept. of Taxation website \_\_\_\_\_ Indexed file found \_\_\_\_\_

If soil/site conditions are limited and sewer and/or Metro District status is not conducive to connection, the Sanitarian may recommend pursuit of Emergency Sewer Extension or Emergency Metro District Inclusion. The Owner should contact the Bureau of Utilities for details.

No permit is to be issued nor inspection to be scheduled without prior fee collection at the office unless an emergency exists.

The contractor is to notify the office of the emergency as soon as possible.

2/2020

\$ 145

21

346 x 3

3

11 88

165

\$1,353







# HOWARD COUNTY HEALTH DEPARTMENT

71497

DATE 4/13/22

Received From

PHONE #

Talman + Horne  
excavating inc.

PS  
410 442-2139

☐ CASH  
☒ CHECK  
NO.

For

Septic Permits (3) 1948,  
1945, 1951 Davis Branch Rd.  
Tank Replacement / 15064 busby Rd.  
One thousand three hundred dollars

\$ 1355

Received By

King