

Bureau of Environmental Health

2930 Stanford Boulevard, Columbia, MD 21045

Phone: 410-313-2500 Fax: 410-313-2545

TDD 410-313-2323 | Toll Free 1-866-313-6300

www.hchealth.org

Facebook: www.facebook.com/hchohealth

Twitter: @HowardCoHealthDep

Maura J. Rossman, M.D., Health Officer

APPLICATION

FOR PERCOLATION TESTING AND SITE EVALUATION

PROPERTY LOCATION

SUBDIVISION/PROPERTY NAME

PROPERTY ADDRESS

3818 Walt Ann Dr

Ellicott City

21042

TAX ACCOUNT

296415

TAX MAP

82

GRID

15

PARCEL

145

LOT NO.

18

PROPOSED LOT SIZE (ACRES)

1.46 AC

ZONING CATEGORY

TIER

PROPERTY OWNER(S)

Kim Doohan

DAYTIME PHONE

240-374-9021

CELL

EMAIL

dkim9002@gmail.com

MAILING ADDRESS

3818 Walt Ann Dr

Ellicott City

21042

APPLICANT

Fogle's Septic Clean

RELATIONSHIP TO OWNER

Contractor

DAYTIME PHONE

410-795-5170

CELL

Kim@fogleseinc.com

MAILING ADDRESS

580 Obrecht Rd

St. Keesville

21784

I HEREBY APPLY FOR THE NECESSARY TESTING/EVALUATION PRIOR TO ISSUANCE OF SEWAGE DISPOSAL SYSTEM PERMIT(S):

PROPERTY:

☐ SUBDIVISION: NUMBER OF LOTS INCLUDING RESIDUE

SUBDIVISION CLASSIFICATION (PER DEPT. OF PLANNING AND ZONING)

☐ MAJOR

☐ MINOR

☐ CONSTRUCT NEW OSDS ON UNDEVELOPED LOT

☒ REPAIR OR REPLACE FAILING OSDS

☐ UPGRADE EXISTING OSDS

BUILDING:

☒ RESIDENTIAL WITH 3 EXISTING OR PROPOSED BEDROOMS IN THE COMPLETED STRUCTURE

☐ COMMERCIAL (PROVIDE DETAIL OF TYPE OF USE AND NUMBERS OF EMPLOYEES/CUSTOMERS ON ACCOMPANYING PLAN)

IS THE PROPERTY WITHIN 2500 FEET OF ANY RESERVOIR?

☐ YES

☒ NO

AS APPLICANT, I UNDERSTAND THE FOLLOWING:

- THIS APPLICATION IS VALID FOR TWO(2) YEARS FROM DATE OF FEE PAYMENT AND APPROVAL IS BASED UPON HEALTH OFFICER SIGNATURE OF A PERC CERTIFICATION PLAN PRIOR TO EXPIRATION OF THIS PERMIT.
- THE APPLICATION FEE IS NON-REFUNDABLE
- THIS APPLICATION MUST BE ACCOMPANIED BY ALL APPLICABLE FEES AND A SUITABLE SITE PLAN IN ORDER TO BE PROCESSED
- THIS IS A PUBLIC DOCUMENT

I declare and affirm that to the best of my knowledge, the information contained herein is correct. I declare that I am the owner of the property or duly authorized to make this application on behalf of the owner. I agree to comply with all applicable state and county regulations.


By signature of this application, I hereby grant Howard County Health Department officials the right to enter onto the property for the purpose of inspecting the property as directly related to the requested permit/service.

SIGNATURE OF APPLICANT

DATE

Profile Quick Notes

8" — GRN SCL MANY LG ROOTS
TRANSITION
22" — YEL BRN SCL SBL
4' — RED SBL SL
FEW CHANNEL MICACEOUS dry friable
6' — YEL BRN IS

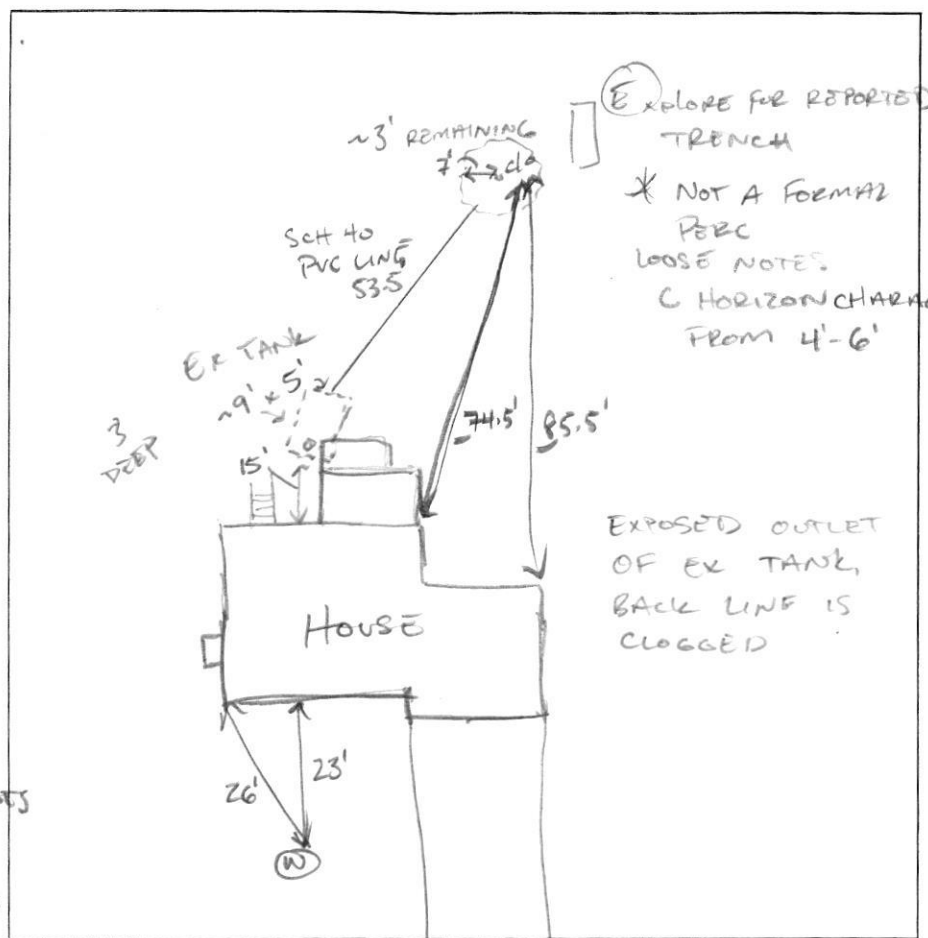

DATE	TEST #	DEPTH	START	BREAK 1" DROP	STOP 2" DROP	TIME OF 2ND INCH	P/F/H
07/21/2007		CLOGGED & COLLAPSED					
		ORANBERG					
		MINOR REPAIR					

REMARKS BACKED UP INTO HOUSE LAST WEEK. HOUSE WAS VACANT FOR 2
YES PRIOR W/ BACKUP INTO HOUSE AT THAT TIME
 SANITARIAN CARANUG 001997 BACKHOE FOGLES OTHERS HOME OWNER

TEST HOLES USED IN SDA _____ AVG. PERC TIME _____ SQ. FT/BR _____

TRENCH WIDTH _____ INLET DEPTH _____ MAX. BOT DEPTH _____ EFFECTIVE S/W _____



Bureau of Environmental Health
8930 Stanford Blvd | Columbia, MD 21045
410.313.2640 - Voice/Relay
410.313.2648 - Fax
1.866.313.6300 - Toll Free

Maura J. Rossman, M.D., Health Officer

INFORMATION FORM - SEPTIC SYSTEM REPAIR/UPGRADE

Reason for Request:

- ☒ Failing System
- ☐ System relocation for proposed addition
- ☐ System upgrade for proposed addition
- ☐ Inadequate treatment zone
- ☐ Collapsed septic tank
- ☐ Collapsed drywell

Has the septic tank been pumped within the last month?

☐ Yes Date pumped: _____
☒ No

Was a visual inspection of the septic tank and/or drain fields conducted?

☒ Yes Explain observation: Drywell full & trench is failing
☐ No

Existing system design

- ☒ Drywell
- ☒ Trench
- ☐ Mound
- ☐ Unknown
- ☐ Other: _____

Was a visual inspection of the sewage line conducted?

☐ Yes
☐ No

Blockage Leading to the field
☐ Yes Explain _____
☒ No

Is discharge surfacing on the ground?

☒ Yes
☐ No

Additional Comments:

*For REPAIRS, are the owners proposing, or do they plan to add in the future any additions or modifications to the property, i.e. pools, living space additions, garages, etc? This information must be disclosed at the time of this application. The Health Department will not be able to accommodate requests in the field for property modifications unrelated to the repair request. Such requests may require an additional fee, testing, and submittal of a Percolation Certification Plan, if the property does not meet current Code and Regulations.

Septic Contractor: Fogle's Septic

Contractor's Phone: 410.795.5670

Contractor's Address: 580 Abrecht Rd

Sykesville, MD 21784

Property Address: 3818 Walt Ann Dr

County File: _____

Subdivision: Shepard's Glen

Lot: 18 Year Built: 1971

Owner's Name: Kim Donhoon

Existing bedrooms: 3

Name of previous owners: _____

Existing bedrooms: _____

Proposed bedrooms: _____

*A Sanitarian will be in contact within three business days, depending upon the urgency of the situation, to coordinate the scheduling/review of the repair or upgrade.

Prior to scheduling inspections, scaled plans should be submitted to clarify the nature of the addition.

Print out a copy of Real Property Data via Dept. of Taxation website _____ Indexed file found _____

If soil/site conditions are limited and sewer and/or Metro District status is not conducive to connection, the Sanitarian may recommend pursuit of Emergency Sewer Extension or Emergency Metro District Inclusion. The Owner should contact the Bureau of Utilities for details.

No permit is to be issued nor inspection to be scheduled without prior fee collection at the office unless an emergency exists.

The contractor is to notify the office of the emergency as soon as possible.

2/2020

WS-PT-22-02382