



# HOWARD COUNTY HEALTH DEPARTMENT

72087

P5/AS

DATE

2/14/22

Received  
From

Tyler Septic Clean

PHONE #

410-195-5600

For

Repair / Rec - 3818

Wolt Gas  
Dr.

☐ CASH

☐ CHECK

NO.

16392

Three hundred thirty


Dollars

\$

330.00

Received By

Kemp

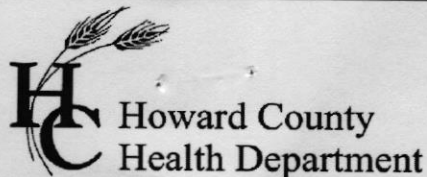**Bureau of Environmental Health**

8930 Stanford Boulevard, Columbia, MD 21045

Main: 410-313-2640 | Fax: 410-313-2648

TDD 410-313-2323 | Toll Free 1-866-313-6300

[www.hchealth.org](http://www.hchealth.org)Facebook: [www.facebook.com/hocohealth](https://www.facebook.com/hocohealth)

Maura J. Rossman, M.D., Health Officer

RECEIPT DATE: 07/14/2022**ONSITE SEWAGE DISPOSAL SYSTEM**P 572087

INSTALLATION

APPROVAL DATE: 07/21/2022**PERMIT**A Repair**MINOR REPAIR**PROPERTY ADDRESS: 3818 Walt Ann Drive, Ellicott City, MD 21042SUBDIVISION: Shepards GlenLOT: 18 TAX ID: 03-296415CONTRACTOR: Fogle's Septic Clean

EMAIL: \_\_\_\_\_

CONTRACTOR ADDRESS: 580 Obrecht Road, Sykesville, MD 21784

PHONE: \_\_\_\_\_

PROPERTY OWNER: Kim, Doohoon

EMAIL: \_\_\_\_\_

OWNER ADDRESS: 3818 Walt Ann Drive, Ellicott City, MD 21042

PHONE: \_\_\_\_\_

NUMBER OF BEDROOMS: 3 SEPTIC TANK SIZE: Existing DRAINFIELD SIZE/TYPE: Drywell

LOCATION:	<u>NO PERC REQ</u>
NOTES:	Homeowner reports that the septic backed up into the house a week prior to inspection. House was vacant for 2 years with prior back up into house at that time.  Uncovering the effluent line between the existing 9' x 5' septic tank and the existing drywell (~3' of liquid level remaining) showed clogged and collapsed orangeberg pipe. Pipe was replaced during inspection

ISSUED BY: Cabahug 001997ISSUE DATE: 07/21/2022EXPIRATION DATE: 07/21/2023

NOTE: CONTRACTOR MUST SCHEDULE AN INSPECTION AND GAIN APPROVAL OF ALL COMPONENTS PRIOR TO COVERING

NOTE: AN ELECTRICAL PERMIT IS REQUIRED FOR INSTALLATION OF ANY ELECTRICAL COMPONENTS OF THE SYSTEM


NOTE: MDE RECOMMENDS SEPTIC TANKS, BAT, AND OTHER PRETREATMENT UNITS BE PUMPED AT A FREQUENCY ADEQUATE TO ENSURE THAT SOLIDS ARE NOT DISCHARGED TO THE DISPOSAL AREA

**NEITHER THE HOWARD COUNTY COUNCIL NOR THE HEALTH DEPARTMENT IS RESPONSIBLE  
FOR THE SUCCESSFUL OPERATION OF ANY SYSTEM.**

**PERMITTEE RESPONSIBLE FOR OBTAINING FINAL APPROVAL ON THIS PERMIT.**

**CALL 410-313-1771 FOR INSPECTION OF SEPTIC SYSTEM.**

NOT TO SCALE

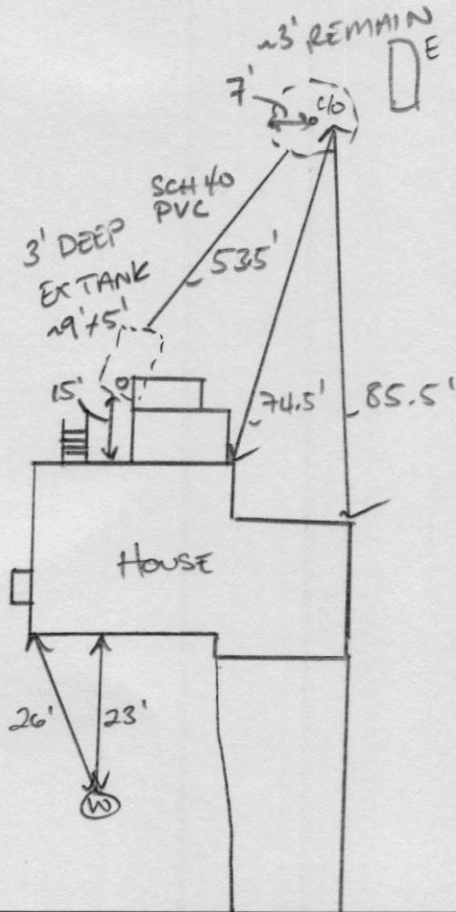

ROAD NAME

WALT ANN DRIVE

**TRENCH/DRAINFIELD DATA**

WIDTH INLET BOTTOM

DRY WELL

NUMBER OF TRENCHES \_\_\_\_\_  
TOTAL LENGTH \_\_\_\_\_  
ABSORPTION AREA \_\_\_\_\_  
DISTRIBUTION BOX LEVEL \_\_\_\_\_  
DISTRIBUTION BOX BAFFLE \_\_\_\_\_  
DISTRIBUTION BOX PORT \_\_\_\_\_

**SEPTIC TANK DATA**

SEPTIC TANK 1 LEVEL \_\_\_\_\_

MANUFACTURER \_\_\_\_\_  
CAPACITY \_\_\_\_\_ GAL  
SEAM LOC \_\_\_\_\_  
TANK LID DEPTH \_\_\_\_\_  
BAFFLES \_\_\_\_\_  
BAFFLE FILTER \_\_\_\_\_  
MANHOLE LOC \_\_\_\_\_  
6" PORT LOC \_\_\_\_\_  
WATERTIGHT TEST \_\_\_\_\_  
SLOTTED \_\_\_\_\_  
DATE ON LID \_\_\_\_\_

PUMP/SEPTIC TANK LEVEL \_\_\_\_\_

MANUFACTURER \_\_\_\_\_  
CAPACITY \_\_\_\_\_ GAL  
SEAM LOC \_\_\_\_\_  
TANK LID DEPTH \_\_\_\_\_  
BAFFLES \_\_\_\_\_  
BAFFLE FILTER \_\_\_\_\_  
MANHOLE LOC \_\_\_\_\_  
6" PORT LOC \_\_\_\_\_  
WATERTIGHT TEST \_\_\_\_\_  
SLOTTED \_\_\_\_\_  
DATE ON LID \_\_\_\_\_

PRE-CONSTRUCTION:

07/21/2022 PERC SHEET.

INSTALLATION:

07/21/2022 INSTALL NEW SCH 40 PVC PIPE.

FINAL INSPECTOR

DATE OF APPROVAL

07/21/2022