

DEPARTMENT OF INSPECTIONS, LICENSES AND PERMITS 3400 COURT HOUSE DRIVE ELICOTT CITY, MD 21043 PERMITS (410) 313-2555 INSPECTIONS (410) 313-1810 AUTOMATED INFORMATION (410) 313-3800	HOWARD COUNTY PERMIT APPLICATION	PERMIT NUMBER B09000174
Building Address <u>5129 Talbots Landing</u> <u>Ellicott City, MD 21043</u>		Property Owner's Name <u>Puepke, Randolph</u> Address <u>5129 Talbots Landing</u> City <u>Ellicott City</u> State <u>MD</u> Zip Code <u>21043</u>
Suite/Apt. #: <u>—</u> SDP/WP/Petition #: <u>—</u> Census Tract <u>—</u> Subdivision <u>—</u> Section <u>—</u> Area <u>—</u> Lot <u>19D</u> Tax Map <u>31</u> Parcel <u>735</u> Grid <u>16</u> Zoning <u>—</u> Map Coordinates <u>—</u> Lot size <u>1.44</u>		Phone <u>410-747-3412</u> Phone <u>—</u> Applicant's Name & Mailing Address, (if other than stated herein): <u>—</u> Phone <u>—</u> Fax <u>—</u>
Existing Use <u>See description of work</u> Proposed Use <u>Sun Room - 3 Seasons Room</u> Estimated Construction Cost \$ <u>50,000.00</u> Description of Work <u>16x24 Sun Room Addition</u> <u>Constructed on piers</u>		Contractor Company <u>Wall To Wall Construction, LLC</u> Contact Person <u>Amy Wall</u> Address <u>9 Newburg Ave, Suite 100</u> City <u>Catonsville</u> State <u>MD</u> Zip Code <u>21228</u> License No. <u>123700</u> Phone <u>410-788-3990</u> Fax <u>410-788-5330</u>
Occupant or Tenant <u>Puepke, Randolph</u> Contact Name <u>same</u> <u>maureen</u> Address <u>5129 Talbots Landing</u> City <u>Ellicott City</u> State <u>MD</u> Zip Code <u>21043</u> Phone <u>410-747-3412</u> Fax <u>—</u>		Engineer or Architect Company <u>Wall To Wall Construction LLC</u> Contact Person <u>Rich English</u> Address <u>9 Newburg Ave, Suite 100</u> City <u>Catonsville</u> State <u>MD</u> Zip Code <u>21228</u> Phone <u>410-788-3990</u> Fax <u>410-788-5330</u>

BUILDING DESCRIPTION - COMMERCIAL		BUILDING DESCRIPTION - RESIDENTIAL	
Building Characteristics Height: <u>—</u> No. of stories: <u>—</u> Gross area, sq. ft. per floor: <u>—</u> Use group: <u>—</u> Construction type: ☐ Reinforced Concrete ☐ Structural Steel ☐ Masonry ☐ Wood Frame ☐ State Certified Modular	Utilities Water Supply: ☐ Public ☐ Private Sewage Disposal: ☐ Public ☐ Private Electric Yes ☐ No ☐ Gas Yes ☐ No ☐ Heating System: ☐ Electric ☐ Oil ☐ ☐ Natural Gas ☐ ☐ Propane Gas ☐ Sprinkler system: N/A ☐ ☐ Full ☐ Partial ☐ Other Suppression ☐ # of Heads	Building Characteristics SF Dwelling ☒ SF Townhouse ☐ Depth <u>34'</u> Width <u>76'</u> 1st floor: <u>34'</u> 2nd floor: <u>34'</u> Basement: <u>34'</u> Finished Basement ☐ Unfinished Basement ☐ ☐ Crawl space ☐ Slab on Grade ☐ No. of Bedrooms <u>3</u> Height: <u>16'</u> Multi-family dwellings: No. of efficiency units: <u>—</u> No. of 1 BR units: <u>—</u> No. of 2 BR units: <u>—</u> No. of 3 BR units: <u>—</u> Other Structure: <u>—</u> Dimensions: <u>—</u> Footings: <u>—</u> Roof Height: <u>—</u> ☐ State Certified Modular ☐ Manufactured Home	Utilities Water Supply: ☒ Public ☐ Private Sewage Disposal: ☐ Public ☒ Private Electric Yes ☒ No ☐ Gas Yes ☒ No ☐ Heating System: ☐ Electric ☐ Oil ☐ ☒ Natural Gas ☐ ☐ Propane Gas ☐ Sprinkler system: N/A ☒ ☐ NFPA #13D ☐ NFPA #13R ☐ Other:


THE UNDERSIGNED HEREBY CERTIFIES AND AGREES AS FOLLOWS: (1) THAT HE/SHE IS AUTHORIZED TO MAKE THIS APPLICATION; (2) THAT THE INFORMATION IS CORRECT; (3) THAT HE/SHE WILL COMPLY WITH ALL REGULATIONS OF HOWARD COUNTY WHICH ARE APPLICABLE THERETO; (4) THAT HE/SHE WILL PERFORM NO WORK ON THE ABOVE REFERENCED PROPERTY NOT SPECIFICALLY DESCRIBED IN THIS APPLICATION; (5) THAT HE/SHE GRANTS COUNTY OFFICIALS THE RIGHT TO ENTER ONTO THIS PROPERTY FOR THE PURPOSE OF INSPECTING THE WORK PERMITTED AND POSTING NOTICES.

<u>Randolph Puepke</u> Applicant's Signature	<u>RANDOLPH PUEPKE</u> Print Name
<u>—</u> Title/Company	<u>2-4-09</u> Date

Checks payable to: **DIRECTOR OF FINANCE OF HOWARD COUNTY**
 ** PLEASE WRITE NEATLY AND LEGIBLY. **
 - FOR OFFICE USE ONLY -

AGENCY	DATE	SIGNATURE APPROVAL	DPZ SETBACK INFORMATION	PROPERTY ID#
Land Development, DPZ			Front: <u>—</u>	Filing fee \$ <u>—</u>
State Highways			Rear: <u>—</u>	Permit fee \$ <u>—</u>
Building Official			Side: <u>—</u>	Excise tax \$ <u>—</u>
Dev. Engineering, DPZ			Side St: <u>—</u>	Accl'y per. fee \$ <u>—</u>
Health	<u>2-4-09</u>	<u>Maureen</u>	All minimum setbacks met?	TOTAL FEES \$ <u>—</u>
Fire Protection			YES ☐ NO ☐	Sub-total paid \$ <u>—</u>
Is Sediment Control approval required prior to issuance?			Is Entrance Permit required?	Balance due \$ <u>—</u>
YES ☐ NO ☐			YES ☐ NO ☐	Check # <u>—</u>
CONTINGENCY CONSTRUCTION START: ☐ ONE STOP SHOP: ☐			Historic District?	Validation # <u>—</u>
			YES ☐ NO ☐	
Distribution of Copies: White: Building Official Green: LDD, DPZ Yellow: DED, DPZ Pink: Health Gold: SHA			Lot Coverage for New Town Zone <u>—</u> SDP Red-line approval date <u>—</u> Accepted by <u>—</u>	

The lot shown hereon does not lie
within the limits of a recorded Flood plain
Easement

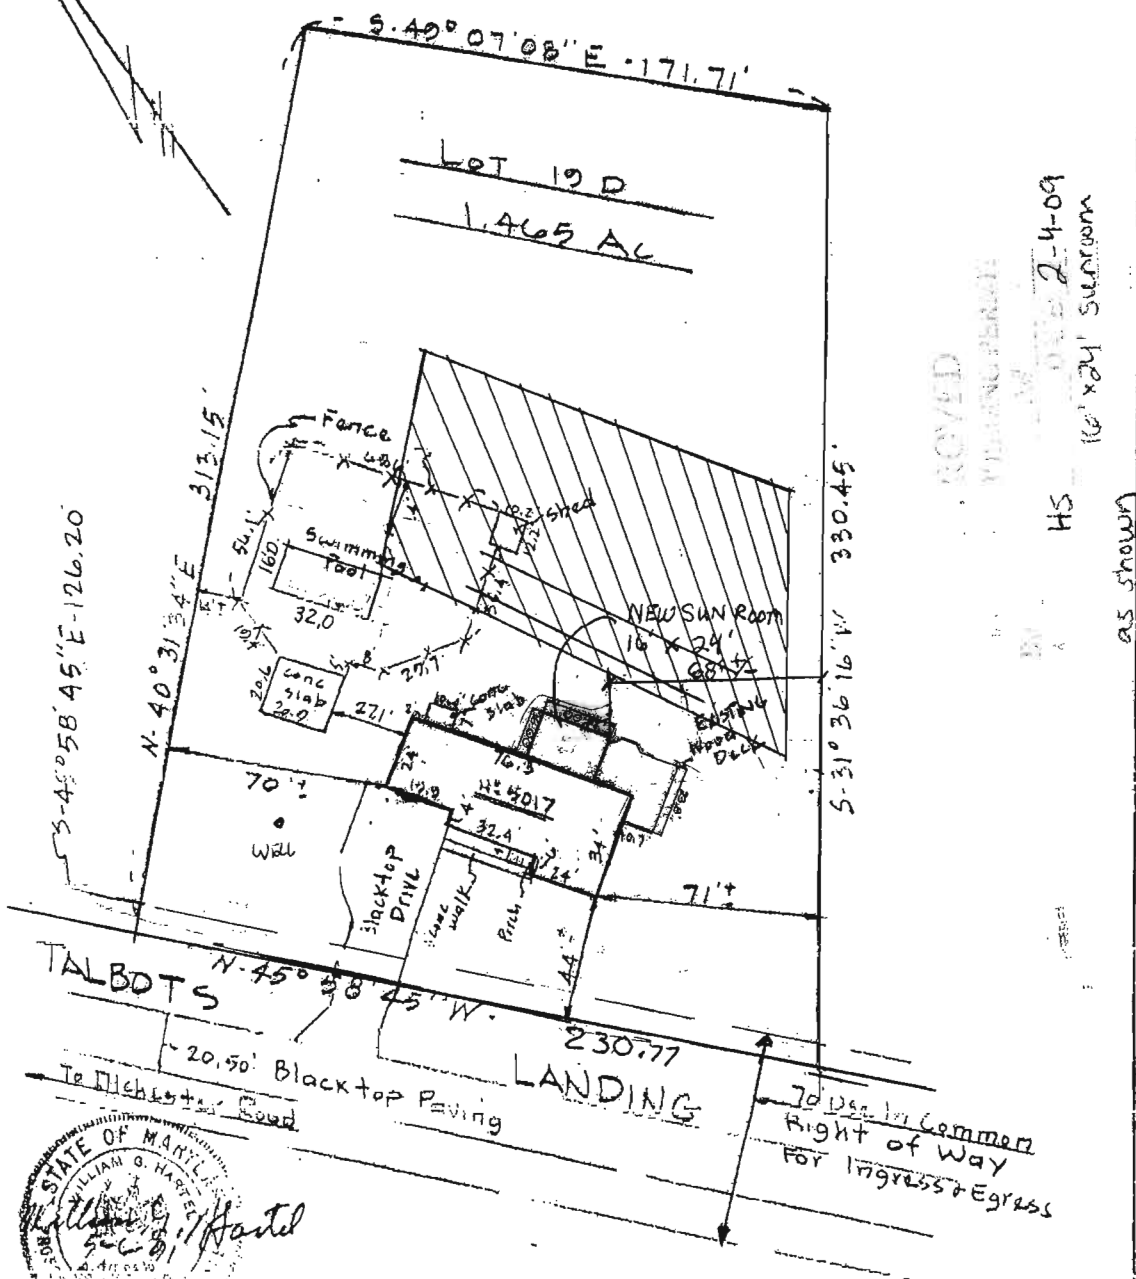

2-4-09
16' x 24' Sunroom
HS
as shown



TITLE LOCATION SURVEY				THIS IS TO CERTIFY THAT WE HAVE CONDUCTED A LOCATION SURVEY OF THE IMPROVEMENTS AND THAT THEY ARE LOCATED AS SHOWN HEREON. <i>William G. Hartel</i> SIGNATURE	
PROJECT LOT 19D - TALBOTS LAST SHIFT				REG. NO. 9436 DATE 5-6-91	
LOCATION 151 ELECTION DISTRICT, HOWARD CO., MD.					
FIELD BOOK 2	PAGE NO. 2	DRAWN BY BTH	CHECKED BY ~	DATE 5-6-91	
SCALE 1" = 50'			JOB NO. 8635		
THE INFORMATION ON THIS PLAT SHOWS ONLY THAT THE IMPROVEMENTS INDICATED HEREON ARE CONTAINED WITHIN THE CONFINES OF THE LOT UPON WHICH THEY ARE ERECTED. THIS PLAT IS NOT TO BE CONSIDERED AS, OR USED FOR THE ESTABLISHMENT OF PROPERTY LINES.					

Boender Associates
ENGINEERS - PLANNERS - SURVEYORS

3230 BETHANY LANE
ELLICOTT CITY, MD. 21043
(301) 415-7777 FAX (301) 465-7555