

10-13-04


CONTRACTOR TO CALL IN MSP WET FLOORS SET

1912

10-800-525755  
PLAN 1-04

SCALE  
Field locate

V. Draw  
S. TANK  
Ensure 10'  
SEP. DISTANCE  
KN

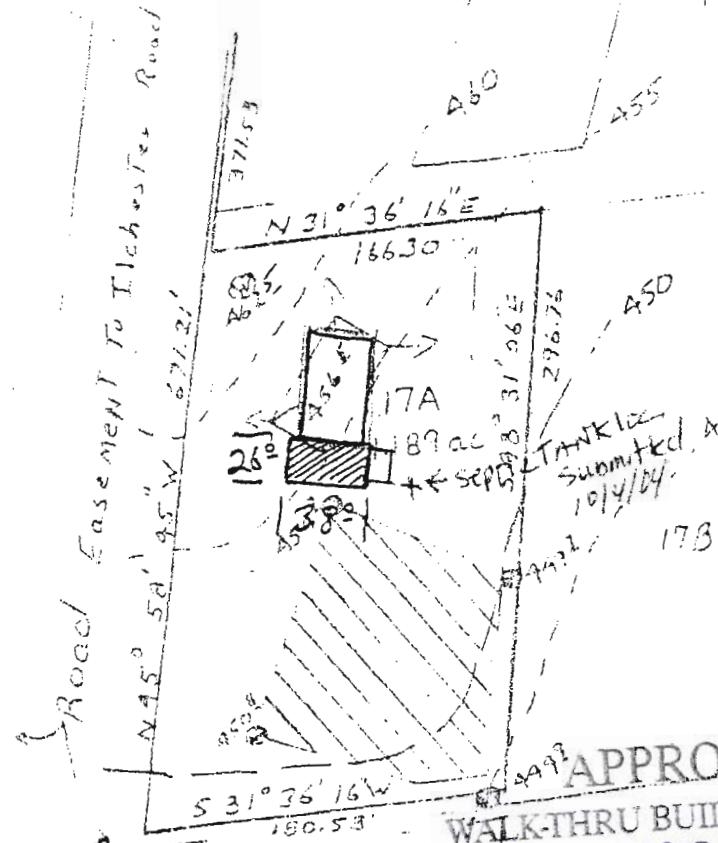

Septic Specifications

APPROVED  
WALK-THRU BUILDING PERMIT  
BP# B00154998 C A# 3225  
APP. SAN. #605 DATE: 10/21/04  
DESC. OF WORK: 12x20 deck on back of house



This area designates a private sewage easement of 10,000 square feet as required by the Maryland Department of Health and Mental Hygiene for individual sewage disposal. Improvements of any nature in this area are restricted until public sewage is available. These easements shall become null and void upon connection to a public sewage system. The County Health Officer shall have the authority to grant variances for encroachments into the private sewage easement. Recordation of a modified sewage easement shall not be necessary. Percolation test holes shown hereon have been field located and shown as "X".

Lots shown hereon comply with the minimum ownership width and lot areas as required by the Maryland Department of Health and Mental Hygiene.

Percolation areas and water wells for adjoining lots have been shown where pertinent.

ROVED: For Private Water and Private Sewage Systems

County Health Officer

Date

18  
5/2/04

Prepared by Contract  
5/2/04

Contractor: Howard Associates  
Architect: Clark Associates  
Surveyor: Clark Associates  
Plat: Clark Associates  
Date: 10/21/04

The plat shows perk holes well

NTT Associates  
Suite 307, Clark Bldg.  
Columbia, MD 21046  
321-0307

septic specifications