



HOWARD COUNTY HEALTH DEPARTMENT

70995
A5

3 / 11 / 22
DATE

Received
From

Fogle Septic Clean Inc

PHONE #

☐ CASH
☒ CHECK

NO.

75098

For

Perce + Repair

11959 Scragsville Rd.

Fulton, MD 20759

Three hundred and thirty

04/100


Dollars

\$

330 | 00

Received By

V DeKorney

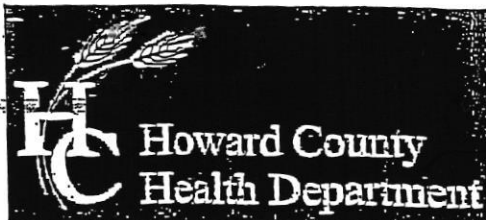

Bureau of Environmental Health

8930 Stanford Boulevard, Columbia, MD 21045

Phone: 410-313-2640 Fax: 410-313-2648

TDD 410-313-2323 | Toll Free 1-866-313-6300

www.hchealth.org

Facebook: www.facebook.com/hchealth

Twitter: HowardCoHealthDep

Maura J. Rossman, M.D., Health Officer

APPLICATION

FOR PERCOLATION TESTING AND SITE EVALUATION

1570995

PROPERTY LOCATION

SUBDIVISION/PROPERTY NAME

PROPERTY ADDRESS

11959 Seagssville Rd Fulton 20759
STREET TOWN ZIP

TAX ACCOUNT

356014

TAX MAP

41

GRID

19

PARCEL

80

LOT NO.

PROPOSED LOT

SIZE (ACRES)

5297 Ac

ZONING CATEGORY

TIER

PROPERTY OWNER(S)

Nicole Smith

DAYTIME PHONE

202-407-1472

CELL

EMAIL

nikkismith@yahoo.com

MAILING ADDRESS

11959 Seagssville Rd

Fulton

20759

STREET

CITY, STATE

ZIP

APPLICANT

Fogle's Septic Clean

RELATIONSHIP TO OWNER:

Contractor

DAYTIME PHONE

410-795-5670

CELL

EMAIL

Kim@foglesinc.com

MAILING ADDRESS

580 Obrecht Rd

Sykesville

21784

STREET

CITY, STATE

ZIP

I HEREBY APPLY FOR THE NECESSARY TESTING/EVALUATION PRIOR TO ISSUANCE OF SEWAGE DISPOSAL SYSTEM PERMIT(S):

PROPERTY:



SUBDIVISION: NUMBER OF LOTS INCLUDING RESIDUE:

SUBDIVISION CLASSIFICATION (PER DEPT. OF PLANNING AND ZONING)



MAJOR



MINOR



CONSTRUCT NEW OSDS ON UNDEVELOPED LOT



REPAIR OR REPLACE FAILING OSDS



UPGRADE EXISTING OSDS

BUILDING:



RESIDENTIAL WITH

4

EXISTING OR PROPOSED BEDROOMS IN THE COMPLETED STRUCTURE



COMMERCIAL (PROVIDE DETAIL OF TYPE OF USE AND NUMBERS OF EMPLOYEES/CUSTOMERS ON ACCOMPANYING PLAN)

IS THE PROPERTY WITHIN 2500 FEET OF ANY RESERVOIR?



YES



NO

AS APPLICANT, I UNDERSTAND THE FOLLOWING:

- THIS APPLICATION IS VALID FOR TWO (2) YEARS FROM DATE OF FEE PAYMENT AND APPROVAL IS BASED UPON HEALTH OFFICER SIGNATURE OF A PERC CERTIFICATION PLAN PRIOR TO EXPIRATION OF THIS PERMIT.
- THE APPLICATION FEE IS NON-REFUNDABLE.
- THIS APPLICATION MUST BE ACCOMPANIED BY ALL APPLICABLE FEES AND A SUITABLE SITE PLAN IN ORDER TO BE PROCESSED.
- THIS IS A PUBLIC DOCUMENT.


I declare and affirm that to the best of my knowledge, the information contained herein is correct. I declare that I am the owner of the property or duly authorized to make this application on behalf of the owner. I agree to comply with all applicable state and county regulations.

By signature of this application, I hereby grant Howard County Health Department officials the right to enter onto the property for the purpose of inspecting the property as directly related to the requested permit/service.

SIGNATURE OF APPLICANT

DATE

AP 570995

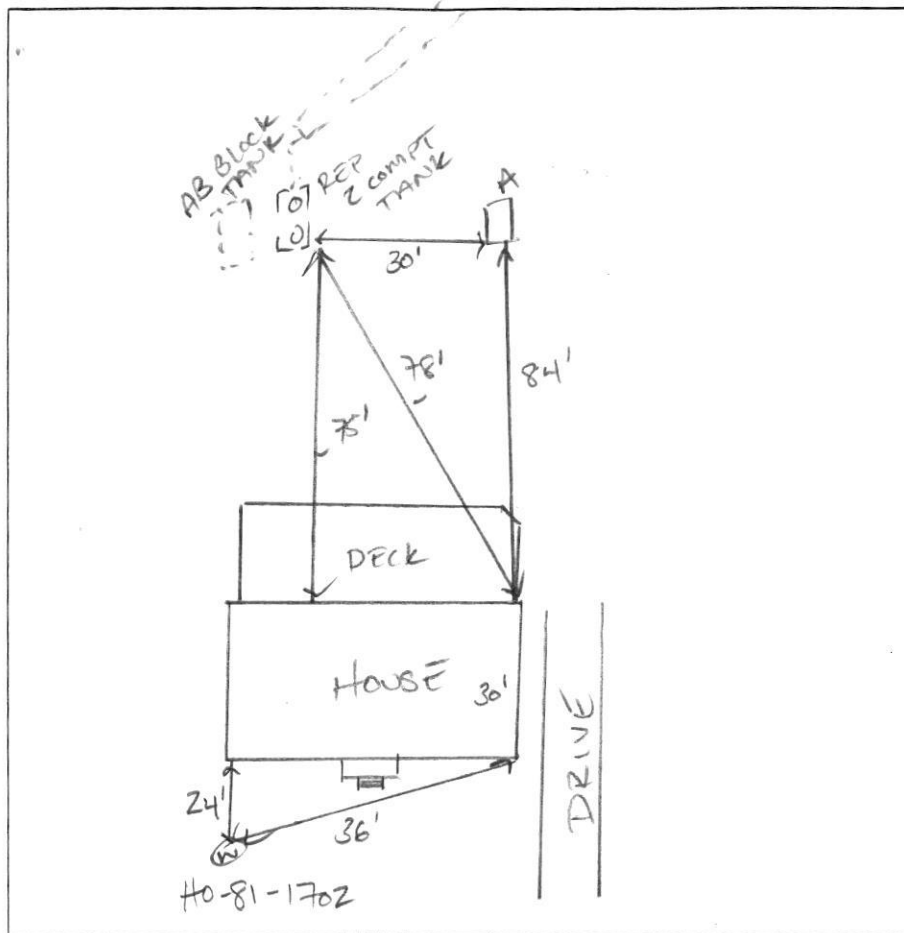

SCAGGSVILLE ROAD

DATE	TEST #	DEPTH	START	BREAK 1" DROP	STOP 2" DROP	TIME OF 2ND INCH	P/F/H

REMARKS OBSERVATION ONLY - CONFIRM 4' BUFFER

SANITARIAN CABANUG 00197 BACKHOE FOGLES OTHERS _____

TEST HOLES USED IN SDA _____ AVG. PERC TIME _____ SQ. FT/BR _____

TRENCH WIDTH _____ INLET DEPTH _____ MAX. BOT DEPTH _____ EFFECTIVE S/W _____

0 A

4' B HORIZON

BRN SL SBK w/ fr MICACEOUS

12' GRN/YEL BRN SL PL V MICACEOUS WEATHERED SANDSTONE

14' GRN SAPROLITE

16'

VERY BEAUTIFUL