



Howard County Health Department

Maura J. Rossman, M.D., Health Officer

Bureau of Environmental Health

8930 Stanford Boulevard, Columbia, MD 21045

Main: 410-313-2640 | Fax: 410-313-2648

TDD 410-313-2323 | Toll Free 1-866-313-6300

www.hchealth.org

Facebook: www.facebook.com/hocohealth

RECEIPT DATE: 3/11/22

ONSITE SEWAGE DISPOSAL SYSTEM

P 570995

APPROVAL DATE: 03/29/2022

PERMIT:

REPAIR

A

PROPERTY ADDRESS: 11959 Scaggsville Road

SUBDIVISION: _____

LOT: _____

TAX ID: _____

CONTRACTOR: Fogles Septic Clean Inc

EMAIL: kim@foglesinc.com

CONTRACTOR ADDRESS: 580 Obrecht Road, Sykesville, MD 21784

PHONE: 410-795-5670

PROPERTY OWNER: Nicole Smith

EMAIL: _____

OWNER ADDRESS: 11959 Scaggsville Road, Fulton, MD 20759

PHONE: 202-407-1472

SEPTIC TANK SIZE (GALLONS): 1500

PUMP CHAMBER CAPACITY (GALLONS): _____

PUMP SIZE: —

NUMBER OF BEDROOMS: 4

HOUSE SQ. FT. _____

APPLICATION RATE: N/A

DISTRIBUTION SYSTEM: GRAVITY FED ☒

LOW PRESSURE DOSED ☐

TRENCHES:

EXISTING
1993

LINEAR FEET REQUIRED: _____

INLET DEPTH: _____

TRENCH WIDTH: _____

MAXIMUM BOTTOM DEPTH: _____

MINIMUM SPACE

BETWEEN TRENCHES: _____

EFFECTIVE AREA BEGINNING DEPTH: _____

LOCATION:

TO BE STAKED BY SANITARIAN DURING PRE-CONSTRUCTION INSPECTION.

NOTES:

ISSUED BY: CABAHUG 001997

ISSUE DATE: 03/28/2022 EXPIRATION DATE: 03/28/2022

NOTE: CONTRACTOR MUST SCHEDULE A PRE-CONSTRUCTION INSPECTION PRIOR TO BEGINNING ANY INSTALLATION

NOTE: CONTRACTOR MUST SCHEDULE AN INSPECTION AND GAIN APPROVAL OF ALL COMPONENTS PRIOR TO COVERING

NOTE: STONE MUST BE APPROVED BY HEALTH DEPARTMENT AND GRAVEL TICKET MUST BE AVAILABLE FOR REVIEW.

NOTE: WATERTIGHT SEPTIC TANKS REQUIRED

NOTE: ALL PARTS OF SEPTIC SYSTEM SHALL BE AT LEAST 100 FEET DOWNGRADIENT FROM ANY WATER WELL

NOTE: MANHOLE RISERS REQUIRED ON ALL SEPTIC TANKS AND PUMP CHAMBERS

NOTE: AN ELECTRICAL PERMIT IS REQUIRED FOR INSTALLATION OF ANY ELECTRICAL COMPONENTS OF THE SYSTEM

☒ ELECTRICAL PERMIT ISSUED

E

N/A

NOTE: THE HCHD DOES NOT WARRANTY ANY SYSTEM AND CANNOT GUARANTEE THE PERFORMANCE OF THIS SYSTEM AS DESIGNED. BY ACCEPTING THIS PERMIT, THE OWNER AND/OR APPLICANT ACKNOWLEDGE THAT THE SPECIFICATIONS DETAILED IN THIS DESIGN ARE ONE POSSIBLE OPTION AND THAT THE HCHD WILL REVIEW OTHER PROPOSALS. YOU HAVE THE OPTION TO SEEK THE ADVICE OF A QUALIFIED DESIGN CONSULTANT OR PROFESSIONAL ENGINEER FOR FURTHER GUIDANCE.

NOTE: MDE RECOMMENDS SEPTIC TANKS, BAT, AND OTHER PRETREATMENT UNITS BE PUMPED AT A FREQUENCY ADEQUATE TO ENSURE THAT SOLIDS ARE NOT DISCHARGED TO THE DISPOSAL AREA

NEITHER THE HOWARD COUNTY COUNCIL NOR THE HEALTH DEPARTMENT IS RESPONSIBLE FOR THE SUCCESSFUL OPERATION OF ANY SYSTEM.


PERMITTEE RESPONSIBLE FOR OBTAINING FINAL APPROVAL ON THIS PERMIT.

CALL 410-313-1771 TO SCHEDULE INSPECTIONS.

NOT TO SCALE

PROP LINE 11951 SCAGGSVILLE RD

PROP LINE 11967 SCAGGSVILLE RD

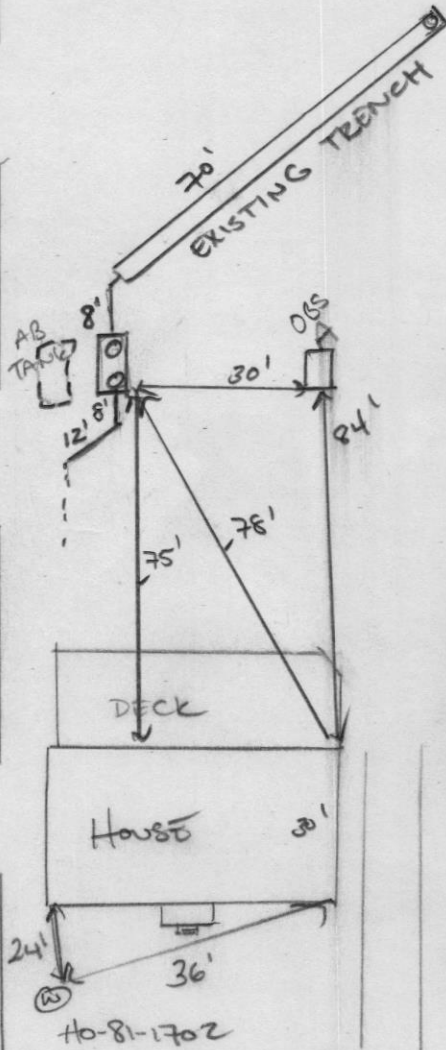

ROAD NAME

SCAGGSVILLE ROAD

PRE-CONSTRUCTION:

*BX SL TO ASBESTOS

INSTALLATION: 03/29/2022 (AM) TANK PT DUG. MATS ON SITE TO MAKE MINOR TRENCH REPAIR. (PM) INSTALLED NEW SEWER LINE FERNCO EX ASBESTOS TO SCH 40 PVC (4") DUG OBS PIT TO VERIFY 4' TREATMENT ZONE.

* OBS PORT IS 9' DEEP - TRENCH STONE IS DRY

FINAL INSPECTOR

DATE OF APPROVAL

03/29/2022

TRENCH/DRAINFIELD DATA

WIDTH 2' INLET 4' BOTTOM 12'
NUMBER OF TRENCHES 1
TOTAL LENGTH 70'
ABSORPTION AREA 140'
DISTRIBUTION BOX LEVEL NONE
DISTRIBUTION BOX BAFFLE -
DISTRIBUTION BOX PORT -

SEPTIC TANK DATA

SEPTIC TANK 1 LEVEL YES
MANUFACTURER BABYLON
CAPACITY 1500 GAL
SEAM LOC TOP
TANK LID DEPTH 1.5'
BAFFLES YES
BAFFLE FILTER -
MANHOLE LOC FRONT/BACK
6" PORT LOC -
WATERTIGHT TEST -
SLOTTED YES
DATE ON LID 02/13/2022
PUMP/SEPTIC TANK LEVEL -
MANUFACTURER -
CAPACITY - GAL
SEAM LOC -
TANK LID DEPTH -
BAFFLES -
BAFFLE FILTER -
MANHOLE LOC -
6" PORT LOC -
WATERTIGHT TEST -
SLOTTED -
DATE ON LID -



Bureau of Environmental Health
8930 Stanford Blvd | Columbia, MD 21045
410.313.2640 - Voice/Relay
410.313.2648 - Fax
1.866.313.6300 - Toll Free

Maura J. Rossman, M.D., Health Officer

INFORMATION FORM - SEPTIC SYSTEM REPAIR/UPGRADE

Reason for Request:

- ☐ Failing System
- ☐ System relocation for proposed addition
- ☐ System upgrade for proposed addition
- ☐ Inadequate treatment zone
- ☒ Collapsed septic tank *Block*
- ☐ Collapsed drywell

Has the septic tank been pumped within the last month?

☐ Yes
☒ No Date pumped: _____

Was a visual inspection of the septic tank and/or drain fields conducted?

☒ Yes Explain observation: *See Attached*
☐ No

Existing system design

- ☐ Drywell
- ☒ Trench
- ☐ Mound
- ☐ Unknown
- ☐ Other: _____

Was a visual inspection of the sewage line conducted?

☒ Yes
☐ No

Blockage Leading to the field

☐ Yes Explain _____
☒ No

Is discharge surfacing on the ground?

☐ Yes
☒ No

Additional Comments:

Tank replacement. see Attached

*For REPAIRS, are the owners proposing, or do they plan to add in the future any additions or modifications to the property, i.e. pools, living space additions, garages, etc? This information must be disclosed at the time of this application. The Health Department will not be able to accommodate requests in the field for property modifications unrelated to the repair request. Such requests may require an additional fee, testing, and submittal of a Percolation Certification Plan, if the property does not meet current Code and Regulations.

Septic Contractor: *Fogle's Septic*

Contractor's Phone: *410.745-5670*

Contractor's Address: *580 Obrecht Rd Sykesville*

Property Address: *11959 Scaggsville Rd*

County File: _____

Subdivision: _____

Lot: _____ Year Built: _____

Owner's Name: *Nicole Smith*

Existing bedrooms: *4*

Name of previous owners: _____

Existing bedrooms: _____

Proposed bedrooms: _____

*A Sanitarian will be in contact within three business days, depending upon the urgency of the situation, to coordinate the scheduling/review of the repair or upgrade.

Prior to scheduling inspections, scaled plans should be submitted to clarify the nature of the addition.

Print out a copy of Real Property Data via Dept. of Taxation website _____ Indexed file found _____

If soil/site conditions are limited and sewer and/or Metro District status is not conducive to connection, the Sanitarian may recommend pursuit of Emergency Sewer Extension or Emergency Metro District Inclusion. The Owner should contact the Bureau of Utilities for details.

No permit is to be issued nor inspection to be scheduled without prior fee collection at the office unless an emergency exists.

The contractor is to notify the office of the emergency as soon as possible.

2/2020