



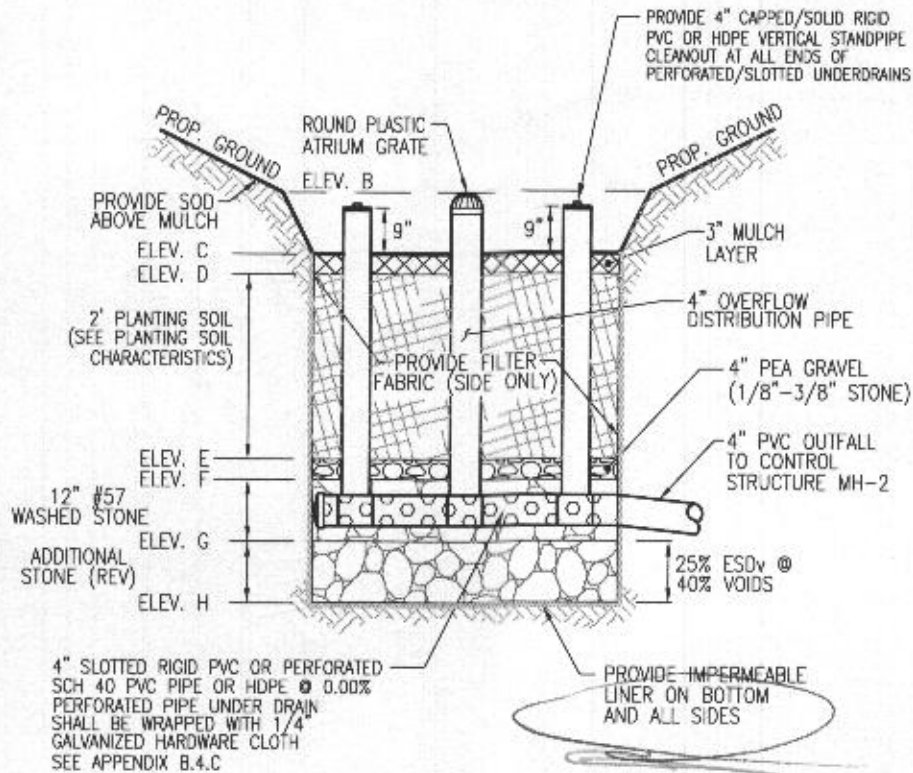

MBR-4
D.A.=12,591 SF IMP=3,439 I=27
 $R_v=0.05+(0.009)(27)=.29$
 $ESD_v=(12,591)(1.64)(0.29)/12=499$ CF (MIN.)
AREA ABOVE MULCH=(499 CF)(0.75)=375 SF (MIN.)
AREA PROVIDED 402 SF

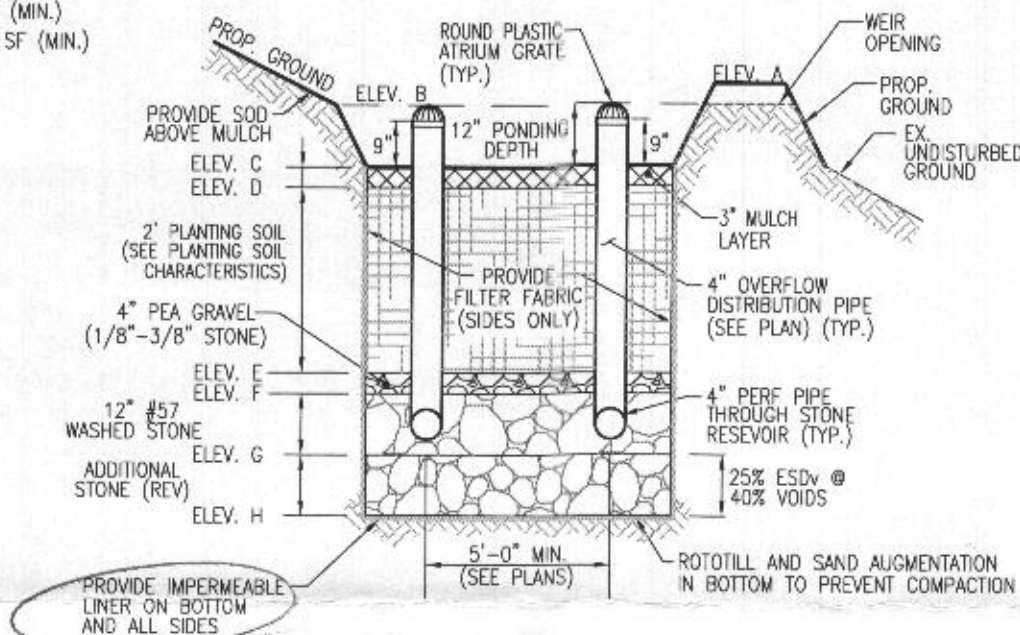

MICRO-BIORETENTION

(MBR-4)

W/ WEIR AND UNDERDRAIN OUTFALL

NOT TO SCALE

MICRO-BIORETENTION FACILITY ELEVATIONS (M-6)												
LOT #	FACILITY	A	B	C	D	E	F	G	H	WEIR ELEV.	UNDERDRAIN INVERT	FACILITY SIZE
LOT 5	MBR-4*	517.00	516.70	515.70	515.45	513.45	513.12	512.12	511.29	516.70	512.45	402 SF

*PROVIDE IMPERVIOUS LINER WITH THIS FACILITY

geotextile fabric (if required)	ASTM-D-4833 (puncture strength - 125 lb.) ASTM-D-4632 (Tensile Strength - 300 lb.)	0.08" thick equivalent opening size of #80 sieve	Must maintain 125 gpm per sq. ft. flow rate. Note: a 4" pea gravel layer may be substituted for geotextiles meant to "separate" sand filter layers.
impermeable liner (if required)	ASTM-D-4833 (thickness) ASTM-D-412 (tensile strength 1,100 lb., elongation 200%) ASTM-D-624 (Tear resistance - 150 lb./in) ASTM-D-471 (water adsorption: +8 to -2% mass)	30 mil thickness	Liner to be ultraviolet resistant. A geotextile fabric should be used to protect the liner from puncture.

IMPERMEABLE LINER SPECIFICATIONS

MICROBIORETENTION NOTES:

1. ONLY THE SIDES OF MICROBIORETENTION ARE TO BE WRAPPED IN FILTER FABRIC. FILTER FABRIC BETWEEN LAYER OR AT THE BOTTOM OF THE MICROBIORETENTION WILL CAUSE THE MBR TO FAIL, AND THEREFORE SHALL NOT BE INSTALLED.
2. WRAP THE PERFORATED MBR UNDERDRAIN PIPE WITH 1/4" MESH (4x4) OR SMALLER GALVANIZED HARDWARE CLOTH.
3. PROVIDE 5' MINIMUM SPACING BETWEEN UNDER DRAIN AND PERFORATED PIPE THROUGH STONE RESERVOIR OR SPACE PIPE EQUALLY ACROSS BOTTOM FOR SMALL BIOS. (SEE PLANS)

OPERATION AND MAINTENANCE SCHEDULE FOR (M-6) MICROBIORETENTION AREAS

1. ANNUAL MAINTENANCE OF PLANT MATERIAL, MULCH LAYER AND SOIL LAYER IS REQUIRED. MAINTENANCE OF MULCH AND SOIL IS LIMITED TO CORRECTING AREAS OF EROSION OR WASH OUT. ANY MULCH REPLACEMENT SHALL BE DONE IN THE SPRING. PLANT MATERIAL SHALL BE CHECKED FOR DISEASE AND INSECT INFESTATION AND MAINTENANCE WILL ADDRESS DEAD MATERIAL AND PRUNING. ACCEPTABLE REPLACEMENT PLANT MATERIAL IS LIMITED TO THE FOLLOWING: 2000 MARYLAND STORMWATER DESIGN MANUAL VOL II, TABLE A.4.1 AND 2.
2. SCHEDULE OF PLANT INSPECTION WILL BE TWICE A YEAR IN SPRING AND FALL. THIS INSPECTION WILL INCLUDE REMOVAL OF DEAD AND DISEASED VEGETATION CONSIDERED BEYOND TREATMENT, TREATMENT OF ALL DISEASED TREES AND SHRUBS AND REPLACEMENT OF ALL DEFICIENT STAKES AND WIRES.
3. MULCH SHALL BE INSPECTED EACH SPRING. REMOVE PREVIOUS MULCH LAYER BEFORE APPLYING NEW LAYER ONCE EVERY 2 TO 3 YEARS.
4. SOIL EROSION TO BE ADDRESSED ON AN AS NEEDED BASIS WITH A MINIMUM OF ONCE PER MONTH AND AFTER HEAVY STORM EVENTS.

PLOT PLAN

ROVER MILL ESTATES

LOT 5


3007 SKYE MEADOW WAY

SCALE 1"=30'
DRAWN BY JMR
CHECKED BY RHV
DATE 05/21/21
W. O. # 15-36
SHEET# 3 OF 5

PARCEL: 169
TAX MAP: 15 GRID: 14
3RD ELECTION DISTRICT

REF: F-19-056

ZONED: RR-DEO
L. 19082 / F. 490
HOWARD COUNTY, MARYLAND

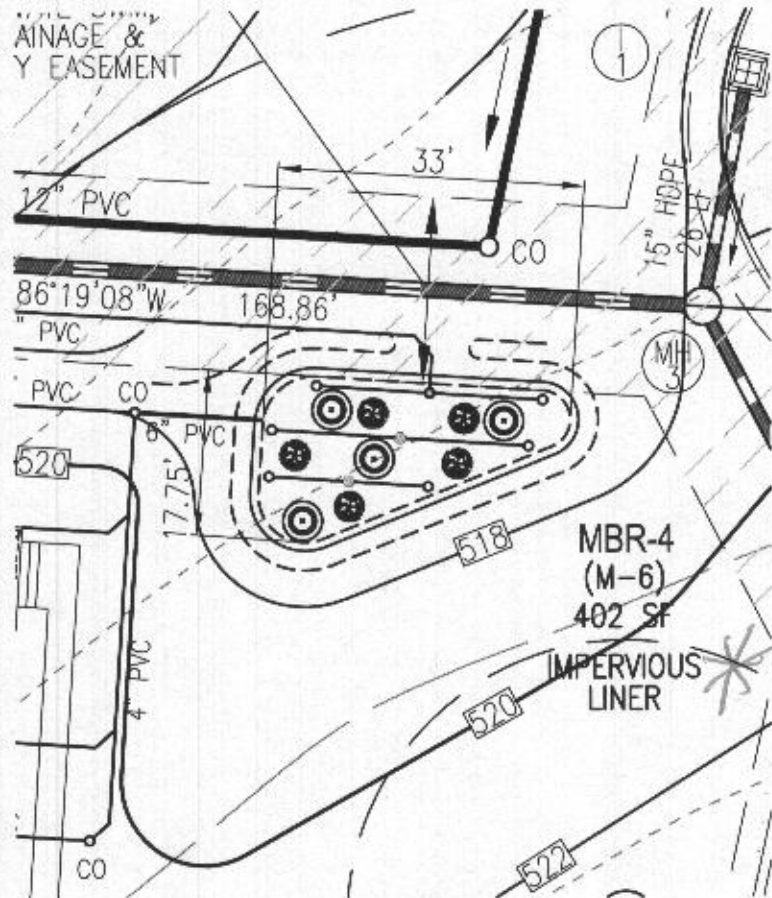

MBR-4 PLANTING DETAIL (402 SF)

SCALE: 1"=20'

MICRO-BIORETENTION PLANTING SCHEDULE (MBR-6)				
	QTY	BOTANICAL NAME/COMMON NAME	SIZE	REMARKS
	4	LINDERA BENZOIN SPICEBUSH	3 GALLON	CONT
	5	ILEX GLABRA INKBERRY	3 GALLON	CONT

1. SF x 0.0229 STEMS PER SQUARE FOOT = PLANTS REQUIRED
2. PLANTINGS REQUIRED: 9
3. (50 SF) CARDINAL FLOWER = 1 PLANTING UNIT

"MICRO-BIORETENTION" PLANTING SCHEDULE NOTES:

1. ALL PLANT MATERIALS SHALL BE FULL AND HEAVY, BE WELL FORMED AND SYMMETRICAL, CONFORM TO THE MOST CURRENT AAN SPECIFICATIONS AND BE INSTALLED IN ACCORDANCE WITH HOWARD COUNTY PLANTING SPECIFICATIONS.
 2. CONTRACTOR SHALL VERIFY LOCATION OF ALL UNDERGROUND UTILITIES PRIOR TO DIGGING.
 3. FINAL LOCATION OF PLANT MATERIAL MAY NEED TO VARY TO MEET FINAL FIELD CONDITIONS. TREES SHALL NOT BE PLANTED IN THE BOTTOM OF DRAINAGE SWALES.
 4. CONTRACTOR SHALL VERIFY PLANT QUANTITIES PRIOR TO BIDDING. IF PLAN DIFFERS FROM LANDSCAPE SCHEDULE, THE PLAN SHALL GOVERN.
 5. MICROBIORETENTION AREAS ARE TO BE PLANTED BASED ON A MINIMUM DENSITY OF 1000 STEMS PER PLANTED ACRE (.0229 STEMS PER SQUARE FOOT). ABOVE PLANTING RATIOS ARE TO BE APPLIED TO THE AREAS PROVIDED IN THE ESDv SUMMARY.
 6. FILTER AREA SHALL BE 50% COVERED BY PLANTINGS AT FULL GROWTH
1. TABLE A.4 IS TAKEN FROM THE "2000 MARYLAND STORMWATER MANUAL, VOLUME II - APPENDIX A.
 2. CONTRACTOR SHALL BE FAMILIAR WITH APPENDIX B.4.C "CONSTRUCTION SPECIFICATIONS", AND TABLE B.4.1 "MATERIAL SPECIFICATIONS". IN ADDITION, THE "2000 MARYLAND STORMWATER DESIGN MANUAL, VOLUME II - APPENDIX A, OFFERS ADDITIONAL HELPFUL INFORMATION.
 3. NO TREES SHALL BE PLANTED WITHIN A MICRO-BIORETENTION FACILITY. USE ONLY SHRUB OR HERBACEOUS SPECIES.
 4. ABOVE TABLE A.4 IS FOR INFORMATIONAL PURPOSES ONLY. LANDSCAPE CONTRACTOR SHALL INSTALL PLANTINGS SPECIFIED IN THE PLANTING SCHEDULES SHOWN HEREON. CHOOSE FROM THE ABOVE TABLE, OR USE APPROVED EQUAL SPECIES WHICH ARE TOLERANT TO FLUCTUATING WATER LEVELS. IF SUBSTITUTIONS ARE CHOSEN, APPROVAL FROM THE ENGINEER IS REQUIRED.
 5. PLANTINGS SHOWN HEREON ARE THE RESPONSIBILITY OF THE DEVELOPER TO INSTALL DURING THE CONSTRUCTION OF THIS FINAL PLAN.

Table A.4 Commonly Used Species for Bioretention Areas

Trees	Shrubs	Herbaceous Species
<i>Acer rubrum</i> Red Maple	<i>Aesculus parviflora</i> Bottlebrush Buckeye	<i>Andropogon virginicus</i> Broomsedge
<i>Betula nigra</i> River Birch	<i>Cephalanthus occidentalis</i> Buttonbush	<i>Eupatorium purpurea</i> Joe Pye Weed
<i>Juniperus virginiana</i> Eastern Red Cedar	<i>Hamamelis virginiana</i> Witch Hazel	<i>Scirpus pungens</i> Three Square Bulrush
<i>Chionanthus virginicus</i> Fringe-tree	<i>Vaccinium corymbosum</i> Highbush Blueberry	<i>Iris versicolor</i> Blue Flag
<i>Nyssa sylvatica</i> Black Gum	<i>Ilex glabra</i> Inkberry	<i>Lobelia cardinalis</i> Cardinal Flower
<i>Diospyros virginiana</i> Persimmon	<i>Ilex verticillata</i> Winterberry	<i>Panicum virgatum</i> Switchgrass
<i>Platanus occidentalis</i> Sycamore	<i>Viburnum dentatum</i> Arrowwood	<i>Dichanthelium scoparium</i> Broom Panic Grass
<i>Quercus palustris</i> Pin Oak	<i>Lindera benzoin</i> Spicebush	<i>Rudbeckia laciniata</i> Tall Coneflower
<i>Quercus phellos</i> Willow Oak	<i>Myrica pennsylvanica</i> Bayberry	<i>Scirpus cyperinus</i> Woolgrass
<i>Salix nigra</i> Black willow		<i>Vernonia noveboracensis</i> New York Ironweed

Note 1: For more options on plant selection for bioretention, consult Bioretention Manual (ETAB, 1993) or the Design of Stormwater Filtering Systems (Claytor and Schueler, 1997).

SCALE 1"=30'
DRAWN BY JMR
CHECKED BY RHV
DATE 05/21/21
W. O. # 15-36
SHEET# 4 OF 5

PARCEL: 169
TAX MAP: 15 GRID: 14
3RD ELECTION DISTRICT

PLOT PLAN
ROVER MILL ESTATES
LOT 5
3007 SKYE MEADOW WAY

REF: F-19-056

ZONED: RR-DEO
L. 19082 / F. 490
HOWARD COUNTY, MARYLAND


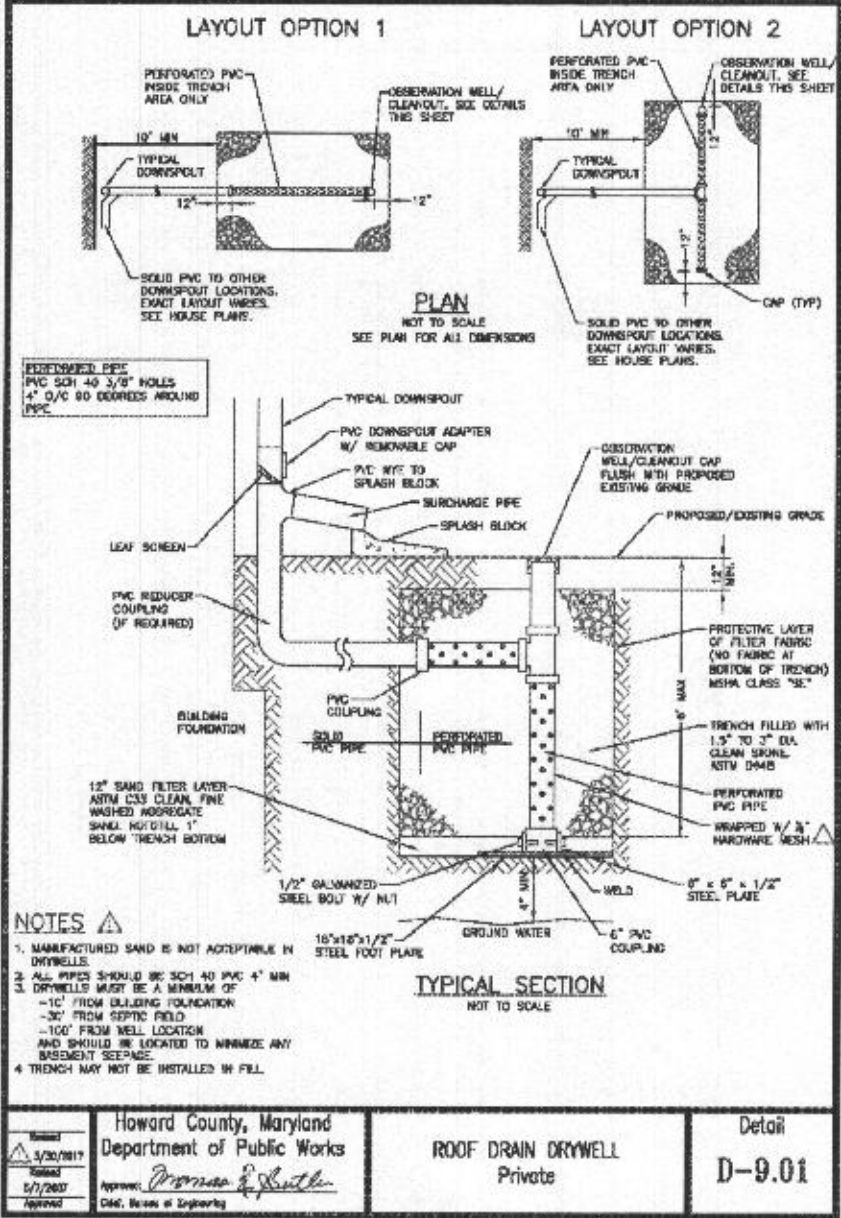


FIGURE 3
STANDARD DRYWELL DOWNSPOUT FITTINGS

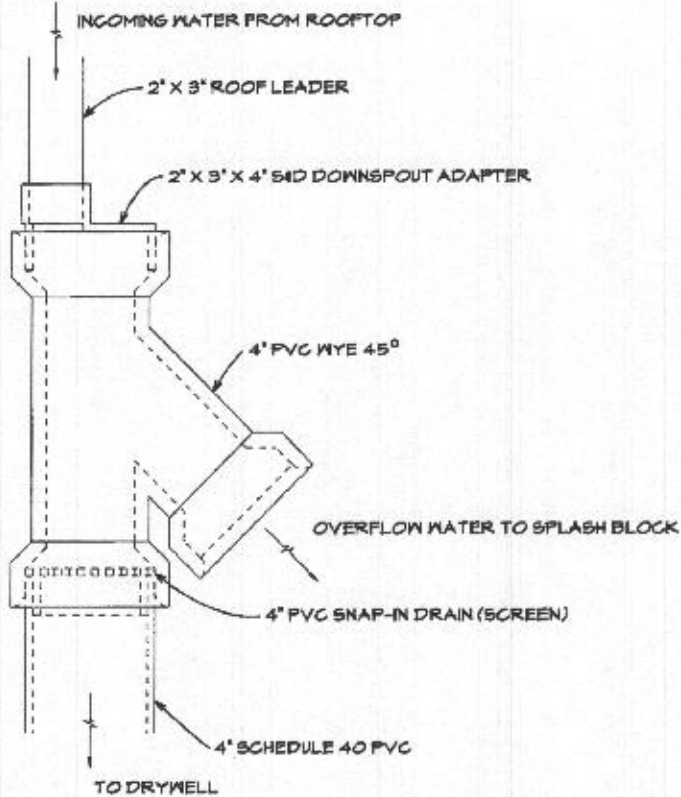

- NOTES:
1. THE SNAP IN SCREEN IS REQUIRED TO PREVENT CLOGGING OF THE DRYWELL WITH DEBRIS.
 2. SEE FIGURE 3a 'LIST OF POTENTIAL SUPPLIERS TO ACCOMPANY FIGURE 3 STANDARD DRYWELL DOWNSPOUT FITTINGS' FOR INFORMATION ON SOME LOCAL RETAILERS THAT SUPPLY COMPONENTS FOR THIS SYSTEM.

Martin B. Covington III, PE
ORIGINALLY EFFECTIVE APRIL, 2006
REVISED MARCH 19, 2008
DISTRIBUTED AT C.C. SURVEYORS MTG.

OPERATION AND MAINTENANCE SCHEDULE FOR PRIVATELY OWNED AND MAINTAINED
STORMWATER INFILTRATION TRENCHES (I-1) AND DRY WELLS (M-5)

1. THE OWNER SHALL INSPECT THE MONITORING WELLS AND STRUCTURES ON A QUARTERLY BASIS, AND AFTER EVERY LARGE STORM EVENT.
2. THE OWNER SHALL RECORD THE WATER LEVELS AND SEDIMENT BUILD UP IN THE MONITORING WELLS OVER A PERIOD OF SEVERAL DAYS TO INSURE TRENCH DRAINAGE.
3. THE OWNER SHALL MAINTAIN A LOG BOOK TO DETERMINE THE RATE AT WHICH THE FACILITY DRAINS.
4. WHEN THE FACILITY BECOMES CLOGGED, SO THAT IT DOES NOT DRAIN DOWN WITHIN A SEVENTY-TWO (72) HOUR TIME PERIOD, CORRECTIVE ACTION SHALL BE TAKEN.
5. THE MAINTENANCE LOGBOOK SHALL BE AVAILABLE TO HOWARD COUNTY FOR INSPECTION TO INSURE COMPLIANCE WITH OPERATION AND MAINTENANCE CRITERIA.
6. ONCE THE PERFORMANCE CHARACTERISTICS OF THE INFILTRATION FACILITY HAVE BEEN VERIFIED, THE MONITORING SCHEDULE CAN BE REDUCED TO AN ANNUAL BASIS, UNLESS THE PERFORMANCE DATA INDICATES THAT A MORE FREQUENT SCHEDULE IS REQUIRED.

DRYWELL #6A


$$ESD_v = (0.95)(1.0)(808)/12 = 64 \text{ CF}$$
$$64/0.4 = 160 \text{ CF (REQ.)}$$
$$5.7' \times 5.7' \times 5' = 162 \text{ CF (PROV.)}$$

DRYWELL #6B

$$ESD_v = (0.95)(1.0)(492)/12 = 39 \text{ CF}$$
$$39/0.4 = 98 \text{ CF (REQ.)}$$
$$4.5' \times 4.5' \times 5' = 101 \text{ CF (PROV.)}$$

OPERATION AND MAINTENANCE SCHEDULE FOR PRIVATELY OWNED AND MAINTAINED
DISCONNECTION OF ROOFTOP RUNOFF (N-1) AND DISCONNECTION
OF NON-ROOFTOP RUNOFF (N-2)

1. MAINTENANCE OF AREAS RECEIVING DISCONNECTED RUNOFF IS GENERALLY NO DIFFERENT THAN THAT REQUIRED FOR OTHER LAWN OR LANDSCAPED AREAS. THE AREAS RECEIVING RUNOFF SHOULD BE PROTECTED FROM FUTURE COMPACTION OR DEVELOPMENT OF IMPERVIOUS AREA. IN COMMERCIAL AREAS, FOOT TRAFFIC SHOULD BE DISCOURAGED AS WELL.

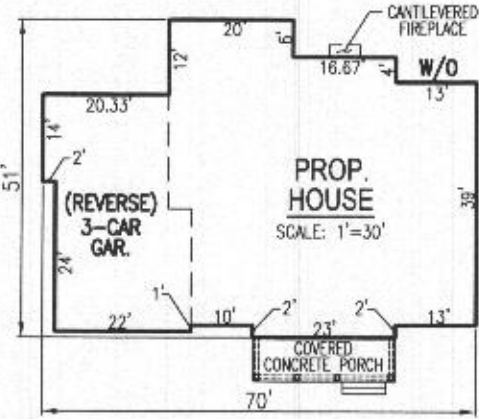

SCALE 1"=30'

DRAWN BY JMR

CHECKED BY RHV

DATE 05/21/21

W. O. # 15-36

SHEET# 5 OF 5

PARCEL: 169
TAX MAP: 15 GRID: 14
3RD ELECTION DISTRICT

PLOT PLAN
ROVER MILL ESTATES
LOT 5
3007 SKYE MEADOW WAY

REF: F-19-056

ZONED: RR-DEO
L. 19082 / F. 490
HOWARD COUNTY, MARYLAND