

# APPLICATION

SEWAGE DISPOSAL TESTING

STATE OF MARYLAND - DEPARTMENT OF HEALTH AND MENTAL HYGIENE

HOWARD COUNTY HEALTH DEPARTMENT  
ENVIRONMENTAL HEALTH SERVICES

P. O. BOX 476 ELLICOTT CITY, MARYLAND 21043  
TELEPHONE: 992-2330

A 35217

P \_\_\_\_\_

DISTRICT Ist

DATE 4/01/85

TO: THE COUNTY HEALTH OFFICER  
ELLICOTT CITY, MARYLAND

I, HEREBY, APPLY FOR THE NECESSARY TEST IN ORDER TO CONSTRUCT (OR RECONSTRUCT) A SEWAGE DISPOSAL SYSTEM.

PROPERTY OWNER Ralph R. Baney JAMES + Deborah Pasto  
ADDRESS 1112 Sulphur Spring Road  
Baltimore, Maryland 21227 PHONE 242-1654 11-88 OK

PROPERTY LOCATION:

SUBDIVISION Talbot's Last Shift LOT NO. 12C  
5213 Talbot's Landing  
ROAD AND DESCRIPTION Richester Road  
BLDG. PERMIT SIGNED AND RETURNED Serial # B10108971  
BLDG. PERMIT SIGNED AND RETURNED Serial # B10108971  
SIZE OF LOT SFD - 4Bdr TYPE BLDG. 3 or 4 Bedroom  
(NUMBER OF BEDROOMS)

THE SYSTEM INSTALLED UNDER THIS APPLICATION IS ACCEPTABLE ONLY UNTIL PUBLIC FACILITIES BECOME AVAILABLE. I FULLY UNDERSTAND THE

FEE CONNECTED WITH THE FILING OF THIS PERC TEST APPLICATION IS NON-REFUNDABLE UNDER ANY CIRCUMSTANCES. I ALSO AGREE TO COMPLY

WITH ALL M.O.S.H.A. REQUIREMENTS IN TESTING THIS LOT. /s/ Olen Ketterman  
(SIGNATURE OF APPLICANT)

APPROVED BY \_\_\_\_\_ FOR \_\_\_\_\_ DATE \_\_\_\_\_

REJECTED BY \_\_\_\_\_ FOR \_\_\_\_\_ DATE \_\_\_\_\_


HOLD PENDING FURTHER TESTS \_\_\_\_\_ DATE \_\_\_\_\_

REASONS FOR REJECTION OR HOLDING 5-21-85 REC. SATISFACTORY, HOLD FOR CERTIFIED hole  
LOCATION, house + well site, S. side. 3-24-87 Plat 1, T1S 12C + 12B  
Sent for signature. J. G. W.

## THIS IS NOT A PERMIT

### SOIL PROFILE

0'	A1-3
6"	BROWN CLAYLOAM 210%
3'	SAPROLITE
	BROWN Silty SAND 10-20% SAPROLITE

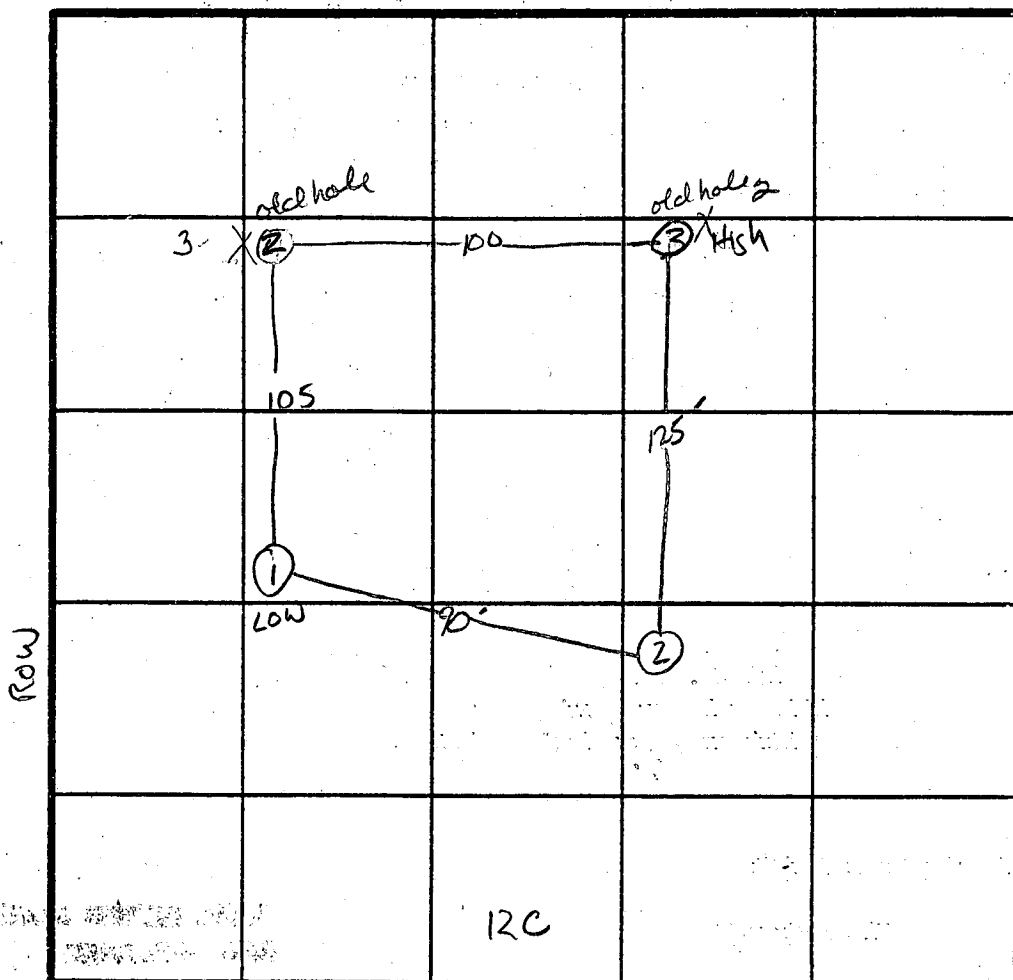

INDICATE NORTH - NAME ADJOINING ROADWAY AS BASE LINE.

Row

DATE	TEST NO.	DEPTH	PRE-WET		TEST - 1" DROP		TIME
			START	STOP	START	STOP	
5/21/85	1 S 1 V	4" 14"	2:21	2:22	2:22	2:24	2 min
			UNIFORM SOIL STRUCTURE BELOW 3'				
	2 S 2 V	3.5" 12"	2:13	2:15	2:15	2:20	5 min
			UNIFORM SOIL BELOW 3'				
OLD	2	14 min PERC	CLAY TO 4"	SANDY Below 4"	4"	13' DEPTH	
TEST	3	4 min PERC	SANDY Below 4"			13' DEPTH	

REMARKS \_\_\_\_\_

TYPE OF SOIL \_\_\_\_\_

TESTED BY SAMUEL ALSO PRESENT OLEN K, Georgia,

EH-12-1079