EPARTMENT OF IMPECTIONS, LICENSES AND PERMITS
3430 COURT HOUSE ORIVE
ELICOTT CITY, MO 21043
PERMITS (410) 313-2438 dHSPECTIONS (410) 213-1810

Distribution of Copies-T:\forms\PERMIT.FRM

White: Building Official

HOWARD COUNTY PERMIT APPLICATION

B09001597)

and the second s	T LEKIMIT AL	PLICATION DO TOC	11010
Building Address 5257 TAI bot	schoding	Property Owner's Name Region	west
Ellicott City 21043		9	
Suite/Apt. #: SDP/WP/Petition #:		Address 5257 Tacots Landing	
		City Ellicon (Hy State Md Zip Code 21043	
Census Tract Subdivision Talagors Control SUIFT		Phone Phone	
SectionAreaLotQA		Applicant's Name & Mailing Address, (if other than stated hereon);	
Tax Map 8 Parcel 693 Grid 16		Phone (443) 340-1229 Fax ELDERSBURG and 21784	
Zoning Map Coordinates Lot size [.[[A]		Phone (443) 340-1229	2184
Existing		Contractor Company	
Use SFD .		CUSTOM WORKS INC	
Proposed Use SPO W Open Deck		Contact Person Wilson	
Estimated Construction Cost \$ 7,200			
Description of Work Const Open Deck w		Address Po Box 175	
STEPS		City KIUA State Md Zip Code 21140 License No. 91395	
Occupant or Tenant		Engineer or Architect Company	
Contact		Contact Person	
Name SAME AS HOMEOWNER			
Address		Address SAME AS CONT	
City State Zip Code			
		CityState _	Zip Code
Phone Fax		Phone Fax	
		Phone	
BUILDING DESCRIPTION - COMMERCIAL		BUILDING DESCRIP:	TION - RESIDENTIAL
Building Characteristics	Utilities	Building Characteristics	<u>Utilities</u>
Height:	Water Supply:	SF Dwelling SF Townhouse	
No. of stories:	Public Private	1st floor: Depth Width	Public Private
	Sewage Disposal:	2nd floor:	Sewage Disposal: Public
Gross area, sq. ft. per floor:	Private	Basement: Finished Basement D Unfinished Basement	Private
	Electric Yes 🗆 No 🗅	☐ Crawl space ☐ Slab on Grade ☐	Electric Yes □ No □
Use group:	Gas Yes No D	No. of Bedrooms	Heating System:
Construction type:	Heating System: Electric □ Oil □	Multi-family dwellings: No. of efficiency units:	Electric O Oil O
Reinforced Concrete Structural Steel	Natural Gas ☐ Propane Gas ☐	No. of 1 BR units: No. of 2 BR units:	Natural Gas ☐ Propane Gas ☐
Masonry		No. of 3 BR units:	Sprinkler system: N/A 🗆
Wood Frame	Sprinkler system: N/A Full	Other Structure: Dimensions:	NFPA #13D NFPA #13R
State Certified Modular	Partial Other Suppression	Footings: Roof Height;	Other:
	# of Heads	State Certified Modular	
,		Manufactured Home	
THE UNDERSIGNED HEREBY CERTIFIES AND AGREES AS FOLLOW HOWARD COUNTY WHICH ARE APPLICABLE THERETO; (4) THAT I OFFICIALS THE RIGHT TO ENTER ONE THIS PROPERTY FOR THE	HE/SHE WILL PERFORM NO WORK ON THE ABOVE I	APPLICATION; (2)THAT THE INFORMATION IS CORRECT; (3) THAT REFERENCED PROPERTY NOT SPECIFICALLY DESCRIBED IN THIS A AND POSTING NOTICES	HE/SHE WILL COMPLY WITH ALL REGULATIONS OF PPLICATION; (5) THAT HE/SHE GRANTS COUNTY
1700	. S. SON OF HOT BUT HOTH PRIMITED	1/00	anu
Applicant's Signature	MANAGEMENT AND CO.	Print Name	
Permus	Printed and province and provin	18/1/09	
Title/Company		Date F FINANCE OF HOWARD COUNTY	
grade to the first transfer of the second		ATLY AND LEGIBLY. ** CE USE ONLY -	
AGENCY DATE	SIGNATURE APPROVAL	DPZ SETBACK INFORMATION	PROPERTY ID#
Land Development, DPZ State Highways		· · · · · · · · · · · · · · · · · · ·	ng fee \$
Building Official			cise tax S
Dev. Engineering, DPZ	Door ide and	(A) (A) (A) (B) (B) (B) (B) (B) (B) (B) (B) (B) (B	d'I per, lee S
EN INTERNATION OF THE PROPERTY		All minimum setbacks met? TOTAL FEES \$	
Fire Protection	经济外的 企业,但是1000年的	YES O NO O	h-intal haid S
Fire Protection Is Sediment Control approval required prior to	o issuance?	YES □ NO □ Su Is Entrance Permit required? Ba	b-total paid \$lance due \$
在 "我就是一个人的一个一个人的人的。" "我们是一个一个一个一个一个一个一个一个一个一个一个一个一个一个一个	o issuance?	Is Entrance Permit required? Ba	lance due Seck; #
Is Sediment Control approval required prior to		Is Entrance Permit required? Ba	lance due \$

SDP/Red-line approval date

Yellow: DED, DPZ


Pink: Health

Green: LDD, DPZ

Accepted by

Rev. 11/4//04

Gold: SHA

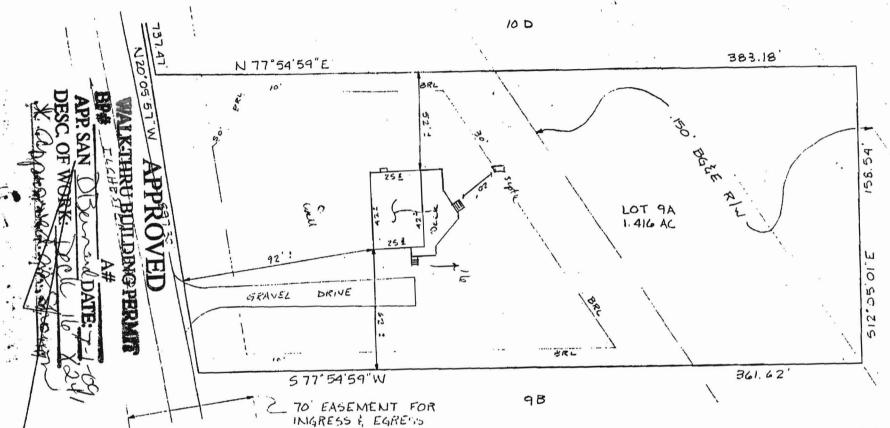

THIS IS TO CERTIFY THAT I HAVE SURVEYED THE PROPERTY SHOWN HEREON FOR THE PURPOSE OF LOCATING THE IMPROVE MUNIS THEREON

J. Carl Hudgins PLS #96



5061 ILCHESTER ROAD 15T ELECTION DISTRICT HOWARD COUNTY, MD.

THIS PLAT SHOWS ONLY THAT THE IMPROVEMENTS ARE CONTAINED WITHIN THE OUTLINES OF THE LOT AND IS NOT TO BE USED TO ESTABLISH PROPERTY LINES.

NTT ASSOCIATES INC. 16205 OLD FREDERICK ROAD MT. AIRY, MARYLAND PHONE 646-5521 or 442-2031

SCALE 1"= 50' DATE 5/22/86

FIELD BY RIK DRAWN BY RIK DRAWING NUMBER