

19 PERMIT

SEWAGE DISPOSAL SYSTEM

MARYLAND STATE DEPARTMENT OF HEALTH

HOWARD COUNTY

NOTE: NO DRY WELL SHALL EXCEED 15 FOOT IN DIAMETER.

PERMIT VOID AFTER THREE YEARS.

COTTA ACCEPTED.

ALL PIPE FROM HOUSE TO DISPOSAL AREA MUST BE CAST IRON.

ELLICOTT CITY
5th

INDEXED


DATE 9/6/79

	Jeff Grane Pal Lindia IS PERMITTED TO INSTALL X ALTER
ADDRESS	143 Numnery Lane, Catonsville, Md. 21228 PHONE 744-4432
SUBDIVISION	ROAD 4670 Ten Oaks Road, Dayton Md. Lot 14
PROPERTY O	WNER Michael MacMurray
ADDRESS	6814 Lenbern Road, Woodlawn, Md., 21207
SPECIFICATIONS	SEPTIC TANK CAPACITY GALLONS DRAIN FIELD DEPTH FEET, BOTTOM AREA SQ. FT.
Dry Well	DEEP TRENCH DEPTH FEET, BOTTOM AREA SO, FT. SEEPAGE PITSX
	34 ft. and maximum depth 12 ft. Effective depth at 5 feet. Trench to come off
	left side of Dry Well, follow contour of land towards test hole #5 (Left side of
	perc area).
PLANS APPRO	WW. Zepp 7/10/73
NEITHER THE HO	K UNTIL INSPECTED AND APPROVED. WARD COUNTY COUNCIL NOR THE HEALTH DEPARTMENT IS RESPONSIBLE FOR THE SUCCESSFUL OPERATION OF ANY SYSTEM. NCH IS USED CALL FOR INSPECTION BEFORE PLACING GRAVEL IN TRENCH.

*INSTALLER IS RESPONSIBLE FOR OBTAINING FINAL APPROVAL ON THIS PERMIT.

NOTE: INSTALL STAND PIPE ON SEPTIC TANK AND DRY WELL. STAND PIPES MUST BE 6 INCHES IN DIAMETER. CAST IRON, CONCRETE OR TERRA

AND STREET, APPROVED ATAC

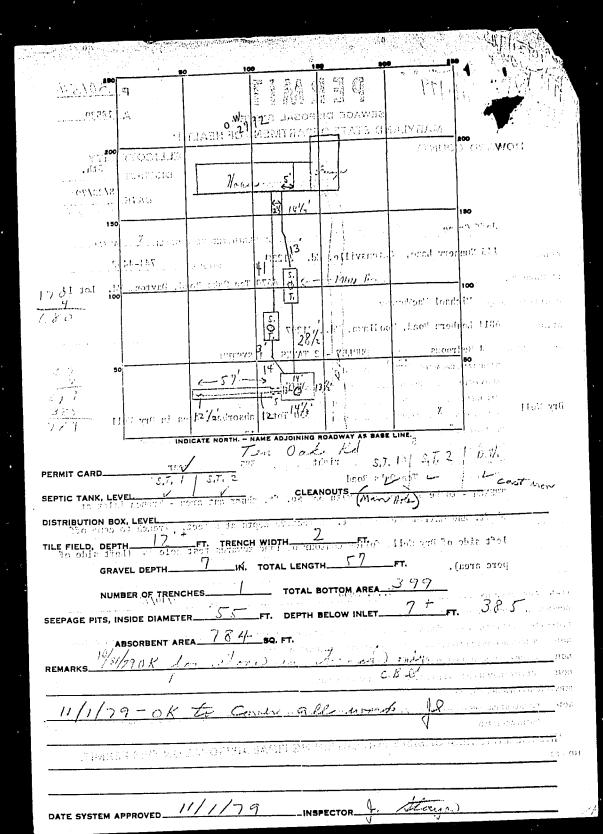

200 B. Werr 250 50'8" DRAIN FICLD 100 105 Ten Oaks ROAD