


LEGEND

- EXISTING 2' CONTOURS
- EXISTING 10' CONTOURS
- SOIL LINES AND TYPES
- DENOTES EXISTING WELL
- DENOTES EXISTING APPROVED PERC AREA
- ▨ DENOTES 15%-24.9% SLOPES
- ▩ DENOTES 25% AND GREATER SLOPE
- DENOTES 1500 Sq.Ft. ALTERNATE WELL SITE
- ▲ DENOTES PASSED PERC TEST FROM 3/5/85
- △ DENOTES FAILED PERC TEST FROM 3/5/85

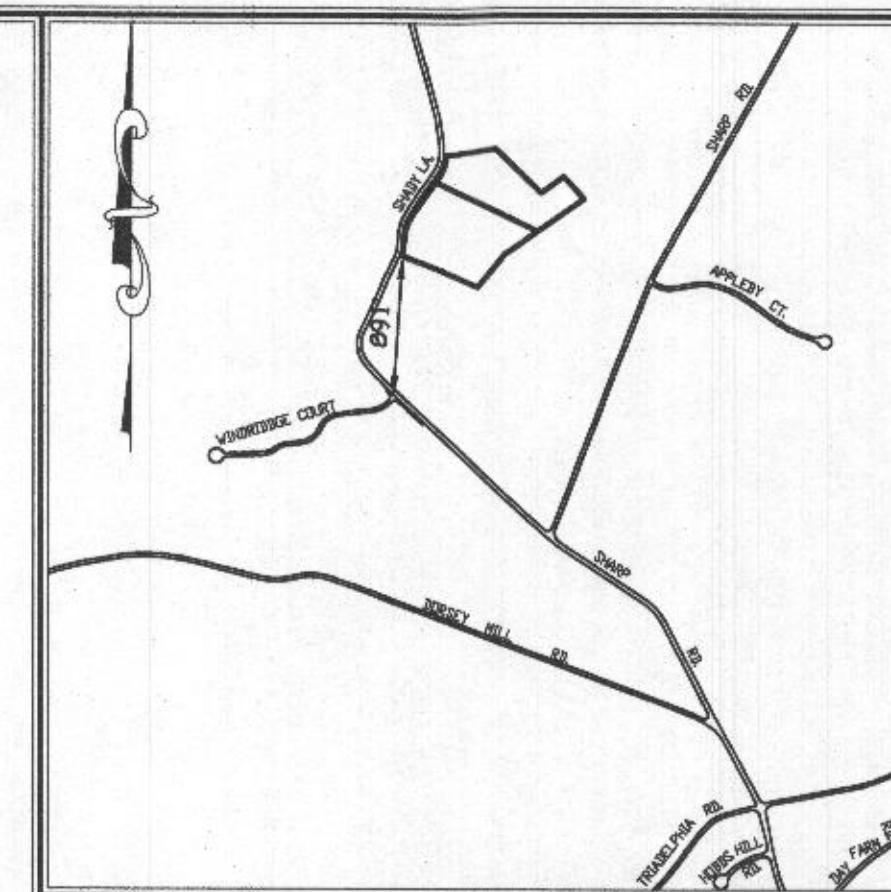

GENERAL NOTES:

VICINITY MAP
SCALE : 1" = 1200'

- THIS AREA DESIGNATES A PRIVATE SEWAGE DISPOSAL AREA OF AT LEAST 10,000 SQUARE FEET AS REQUIRED BY THE MARYLAND STATE DEPARTMENT OF THE ENVIRONMENT FOR INDIVIDUAL SEWERAGE DISPOSAL. IMPROVEMENTS OF ANY NATURE IN THIS AREA ARE RESTRICTED UNTIL PUBLIC SEWERAGE IS AVAILABLE. THESE EASEMENTS SHALL BECOME NULL AND VOID UPON CONNECTION TO A PUBLIC SEWAGE DISPOSAL AREA. THE COUNTY HEALTH OFFICER SHALL HAVE THE AUTHORITY TO GRANT ADJUSTMENTS TO THE PRIVATE SEWAGE DISPOSAL AREA. RECORDATION OF A MODIFIED SEWERAGE EASEMENT SHALL NOT BE NECESSARY. ADJUSTMENTS TO SEWAGE DISPOSAL AREA IS NOT PERMITTED WITHOUT ADDITIONAL TESTING.
- ADJUSTMENTS TO SEWAGE DISPOSAL AREA IS NOT PERMITTED WITHOUT ADDITIONAL TESTING.
- THE LOT SHOWN HEREON COMPLIES WITH THE MINIMUM OWNERSHIP WIDTH AND LOT AREA AS REQUIRED BY THE MARYLAND STATE DEPARTMENT OF THE ENVIRONMENT.
- ALL WELLS AND SEPTIC SYSTEMS WITHIN 100' OF THE PROPERTY BOUNDARIES AND ALL EXISTING OR PROPOSED WELLS LESS THAN 200' DOWN/GRADIENT OF A SEPTIC SYSTEM AND/OR SEPTIC EASEMENT.
- ALL HOUSE SITES SHOWN COMPLY WITH MINIMUM BUILDING RESTRICTION REGULATIONS.
- TOPOGRAPHY SHOWN IS FIELD RUN BY FISHER, COLLINS & CARTER, INC.
- BOUNDARY OUTLINE BASED ON A FIELD RUN BY FISHER, COLLINS & CARTER, INC.
- ANY CHANGES TO A PRIVATE SEWAGE DISPOSAL AREA SHALL REQUIRE A REVISED PERC CERTIFICATION PLAN
- DEED REFERENCE LIBER 3078 FOLIO 613.

PERC CERTIFICATION
I certify that the locations shown herein are based on field locations done under my direct supervision and are correct to the best of my professional knowledge and belief.

Signature of Professional Land Surveyor: *Terrell A. Fisher*
Terrell A. Fisher, Professional Land Surveyor, License No. 100592 Expires 12/13/21
Date: 6/22/20

APPROVED FOR PRIVATE WATER AND PRIVATE SEWERAGE SYSTEMS,
HOWARD COUNTY HEALTH DEPARTMENT.

Signature of County Health Officer: *Maureen Roman*
COUNTY HEALTH OFFICER
Date: 7/7/2020

SOILS LEGEND

SOIL	NAME	CLASS
BaA	Baile silt loam, 0 to 3 percent slopes	D
Co	Codorus and Hatboro silt loams, 0 to 3 percent slopes	C
GgB	Glencol loam, 3 to 8 percent slopes	B
Ha	Hatboro-Codorus silt loams, 0 to 3 percent slopes	D
MaC	Manor loam, 8 to 15 percent slopes	B
MaD	Manor loam, 15 to 25 percent slopes	B

FISHER, COLLINS & CARTER, INC.
CIVIL ENGINEERING CONSULTANTS & LAND SURVEYORS
CENTRAL SQUARE OFFICE PARK - 10272 BALTIMORE NATIONAL PIKE
ELICOTT CITY, MARYLAND 21042
(410) 461-2895

PERC CERTIFICATION PLAT ROBERT SHARP SUBDIVISION

LOT 6
(PLAT NO. 7828)

TAX MAP #21 ZONED: RR-DEO PARCEL: 193
4TH ELECTION DISTRICT
SCALE: 1"=50'
HOWARD COUNTY, MARYLAND
DATE: JUNE 10, 2020