



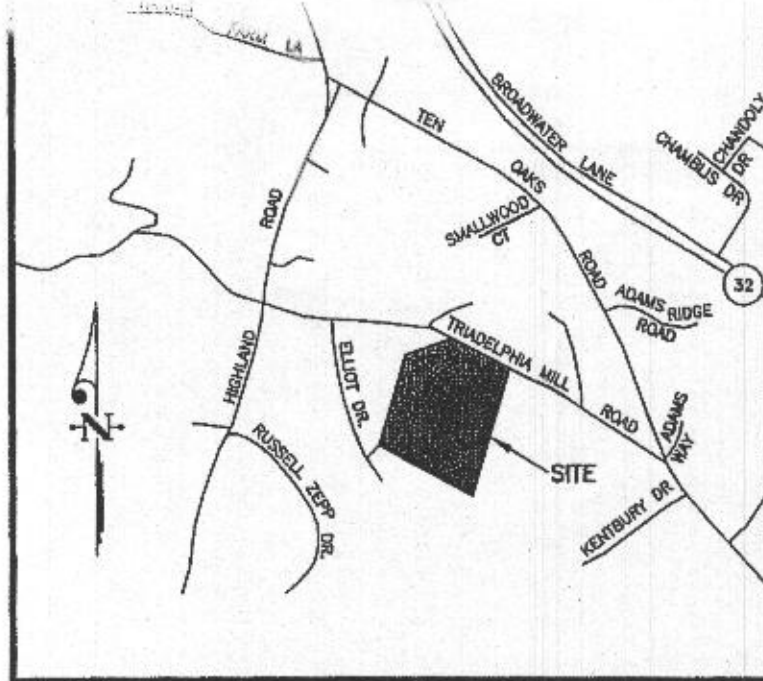


VICINITY MAP
SCALE: 1" = 2,000'
ADC MAP 14-A6

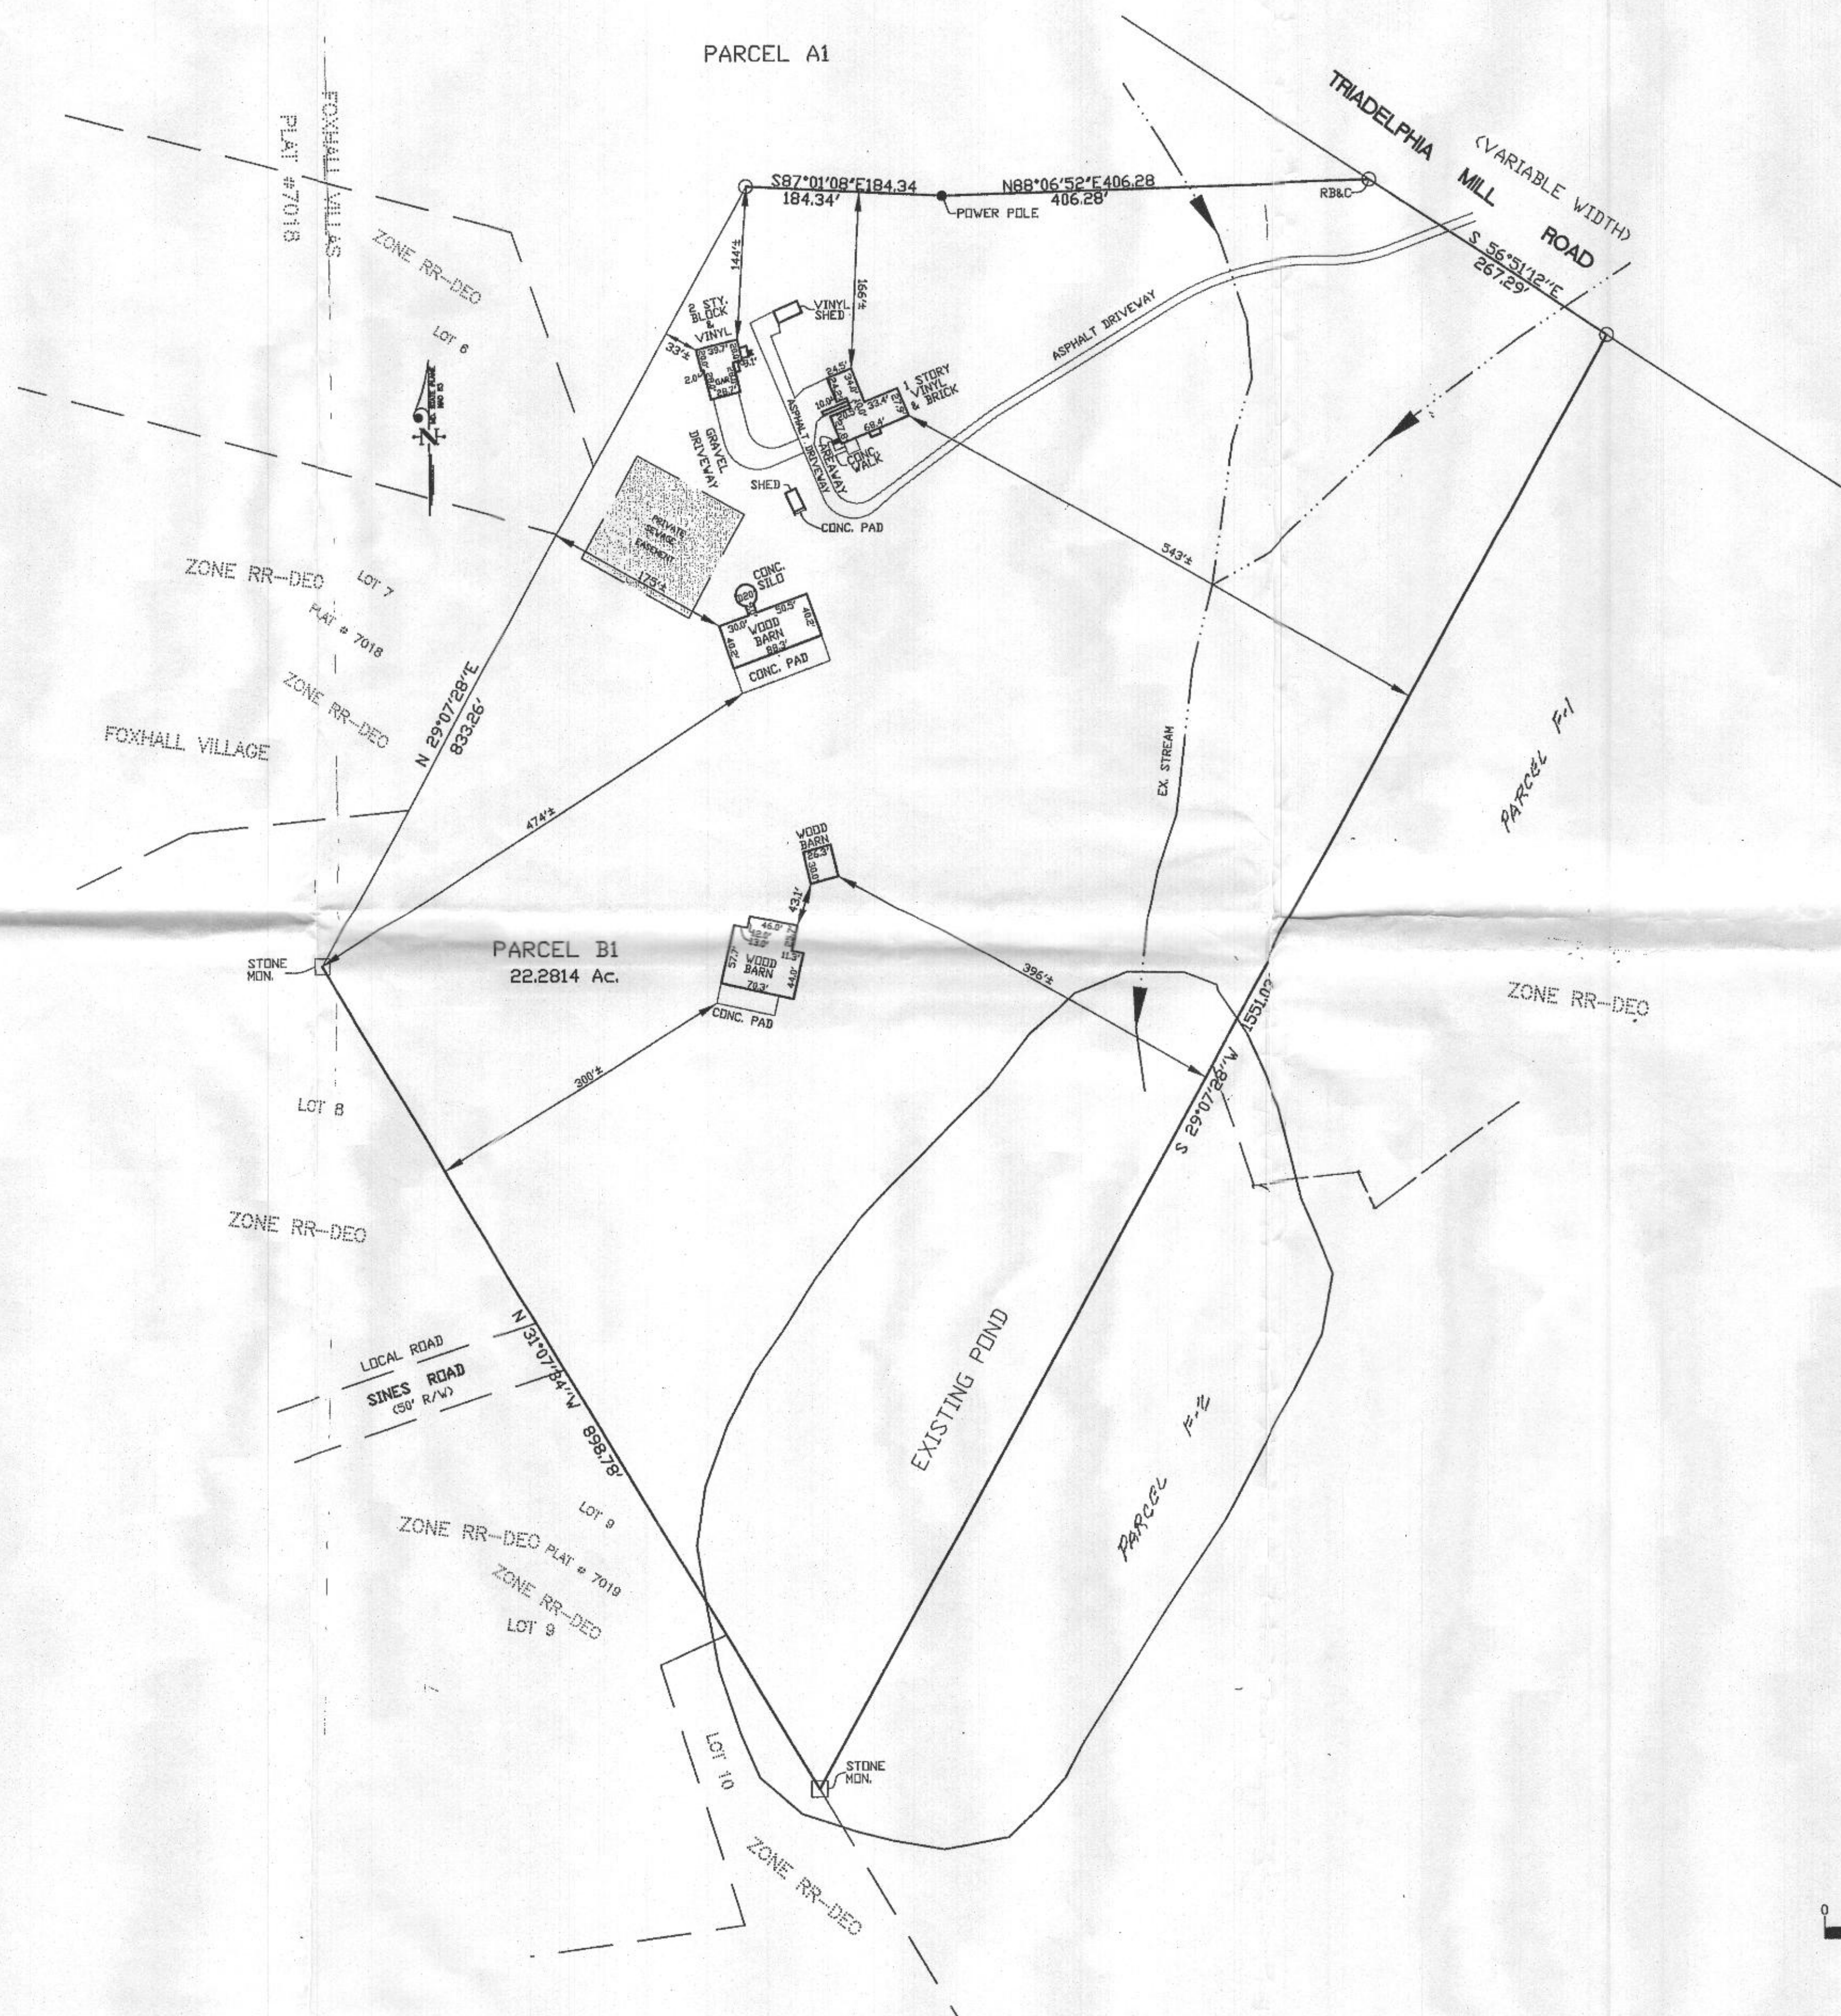

SURVEYOR'S CERTIFICATE

I hereby certify that a field survey of this property has been made under my supervision for the purpose of locating improvements shown hereon, and that they are located as shown.

William L. Moch
10-26-10
STATE OF MARYLAND
WILLIAM L. MOCH
PROFESSIONAL LAND SURVEYOR

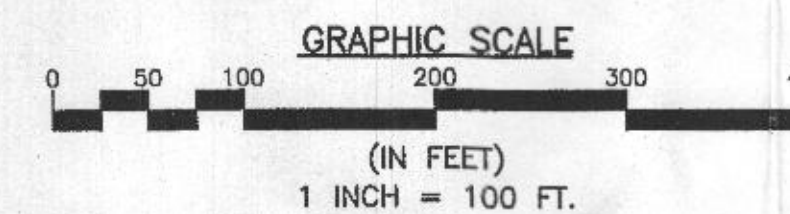

CLARK · FINEFROCK & SACKETT, INC.		
ENGINEERS · PLANNERS · SURVEYORS		
7135 MINSTREL WAY · COLUMBIA, MD 21045 · (410) 381-7500 BALT. · (301) 621-8100 WASH.		
DESIGNED DR	BOUNDARY SURVEY PARCEL B-1 THOMPSON PROPERTY TAX MAP 34, GRID 3, RR-DEO ZONE FIFTH (5TH) ELECTION DISTRICT HOWARD COUNTY, MARYLAND	SCALE 1" = 100'
DRAWN RM		DRAWING 1 of 1
CHECKED DR		JOB NO. 10-061
DATE 10-25-10		FILE NO. 10-061
FOR		

13261 -

TRIADELPHIA MHC
ROAD -

SUBDIVISION