

FIRST FLOOR
AS BUILT / DEMO PLAN

FURST RESIDENCE
4152 ROXBURY MILL ROAD
GLENWOOD, MARYLAND

REVISIONS:

DATE:

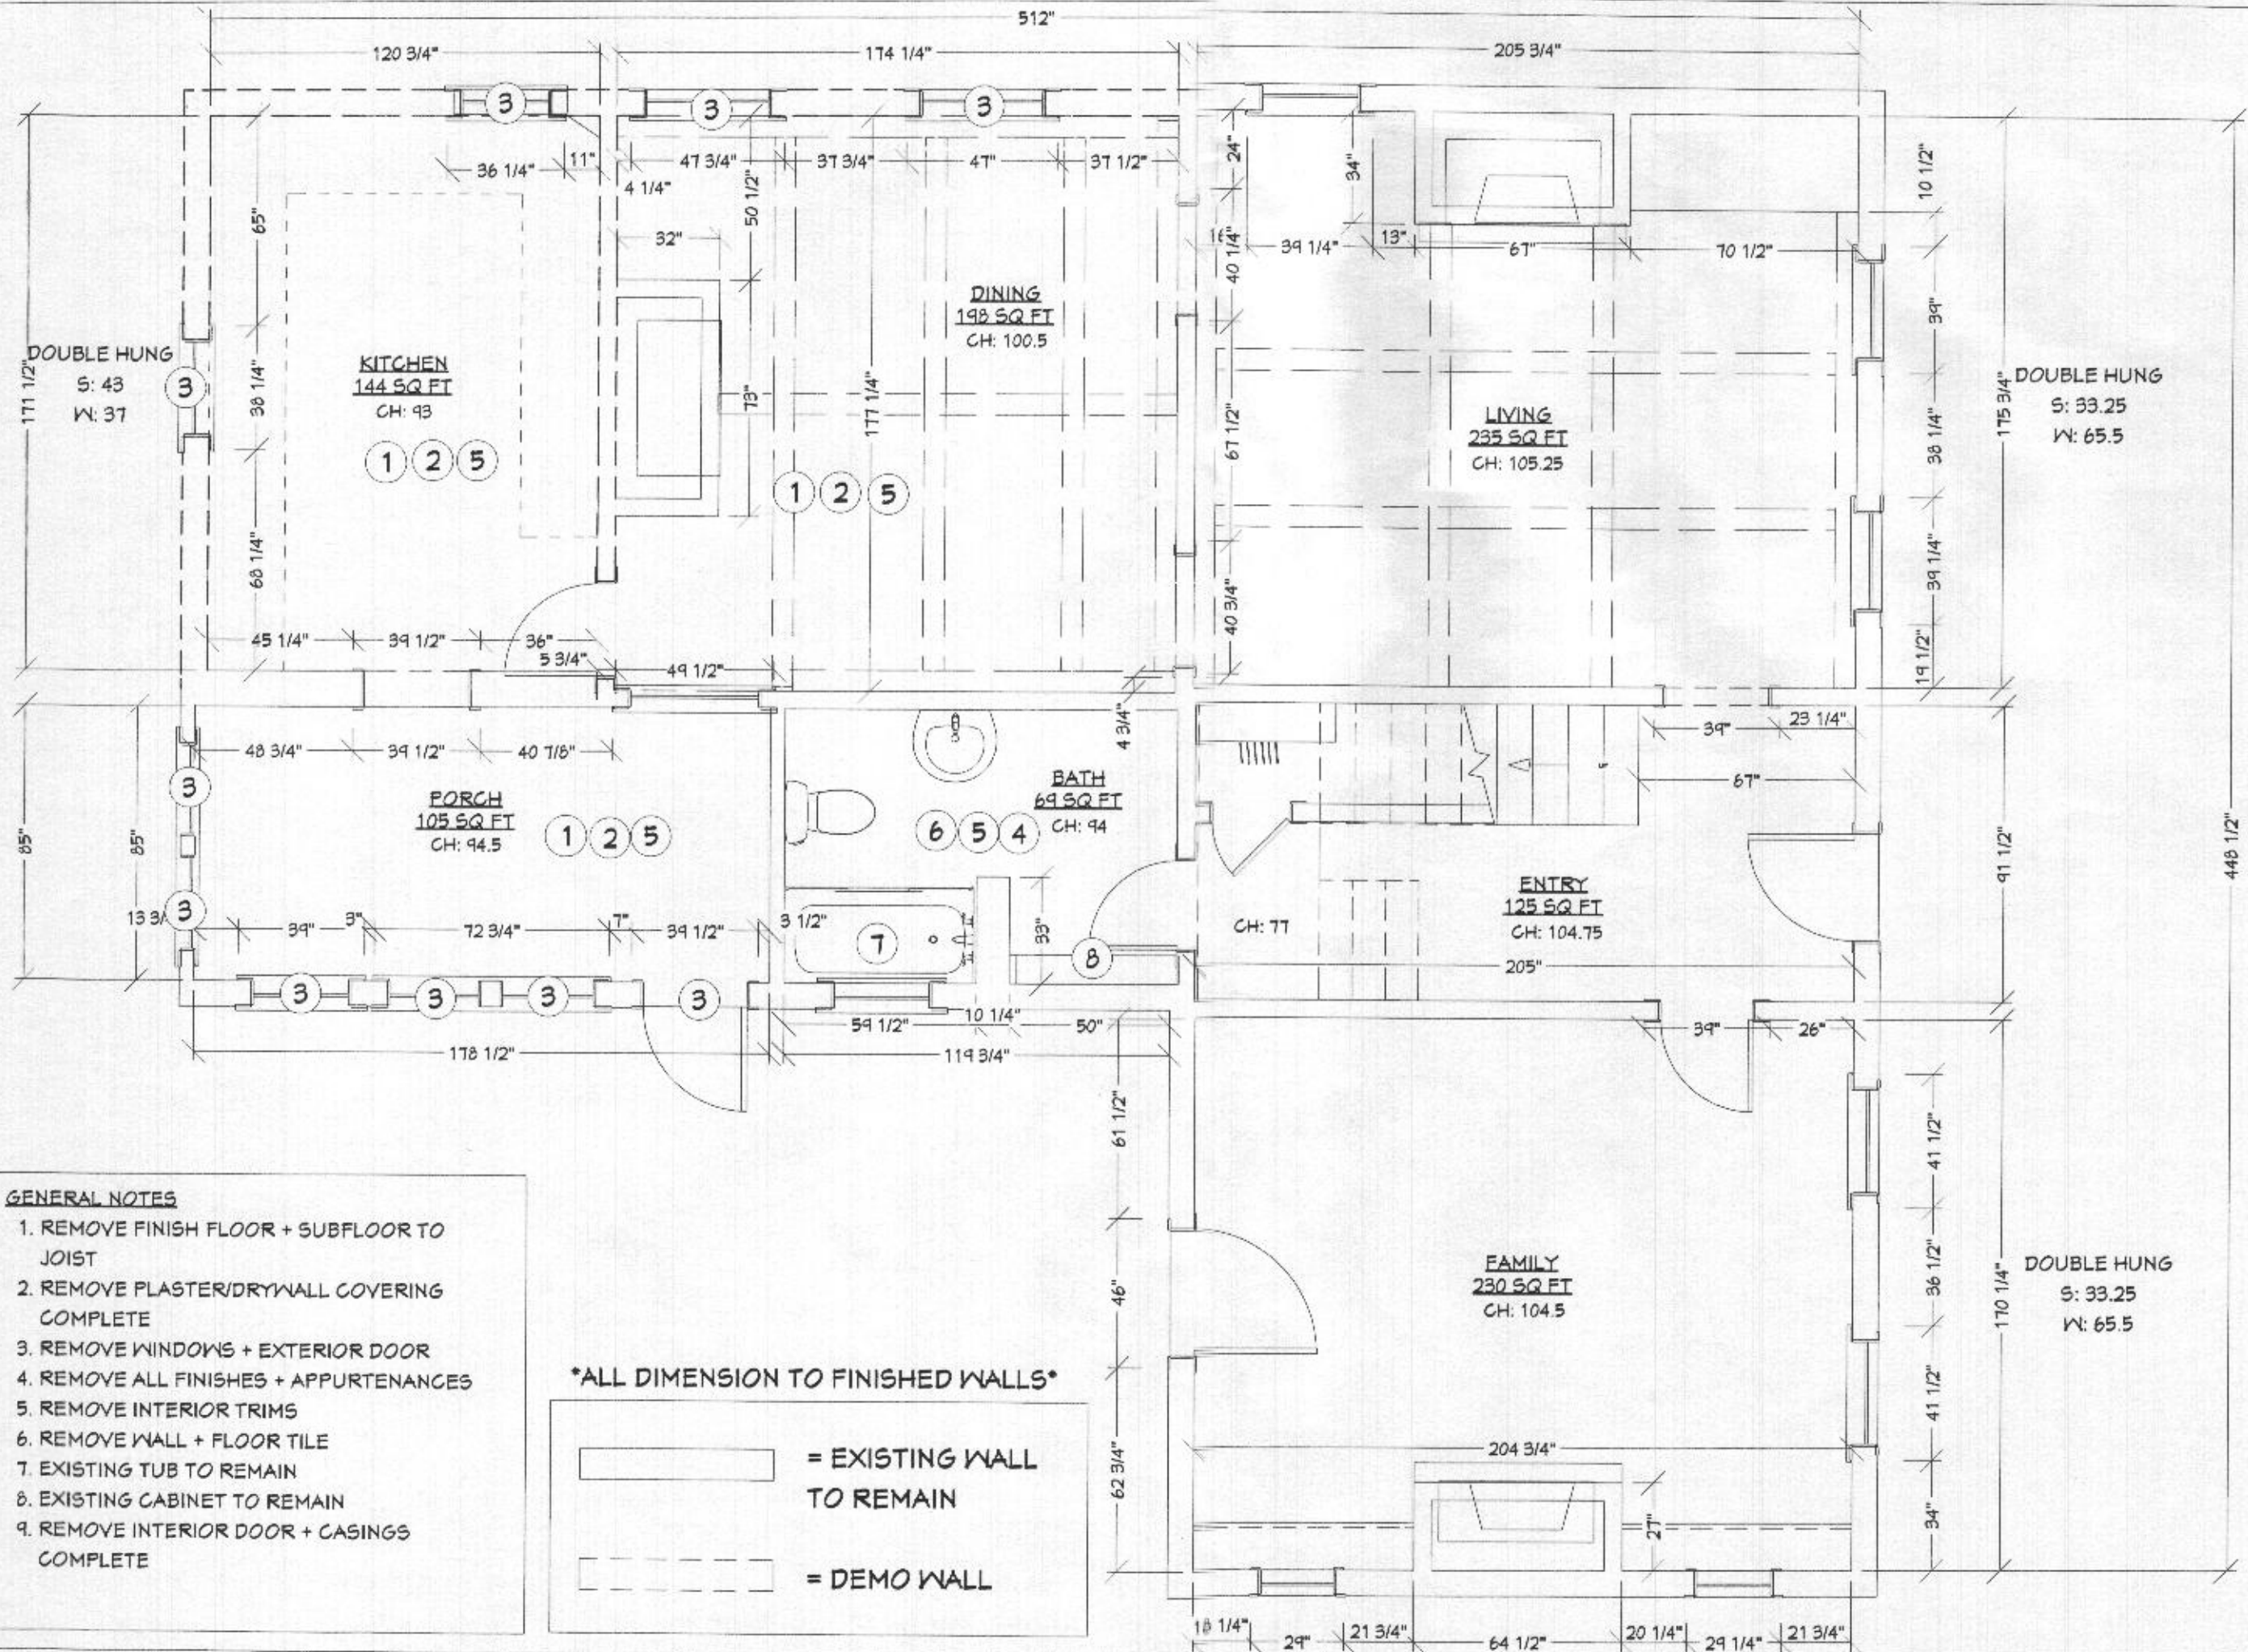
10/8/2019

SCALE:

1/4

SHEET:

3



SECOND FLOOR
 AS BUILT / DEMO PLAN

FURST RESIDENCE
 4152 ROXBURY MILL ROAD
 GLENWOOD, MARYLAND

REVISIONS:

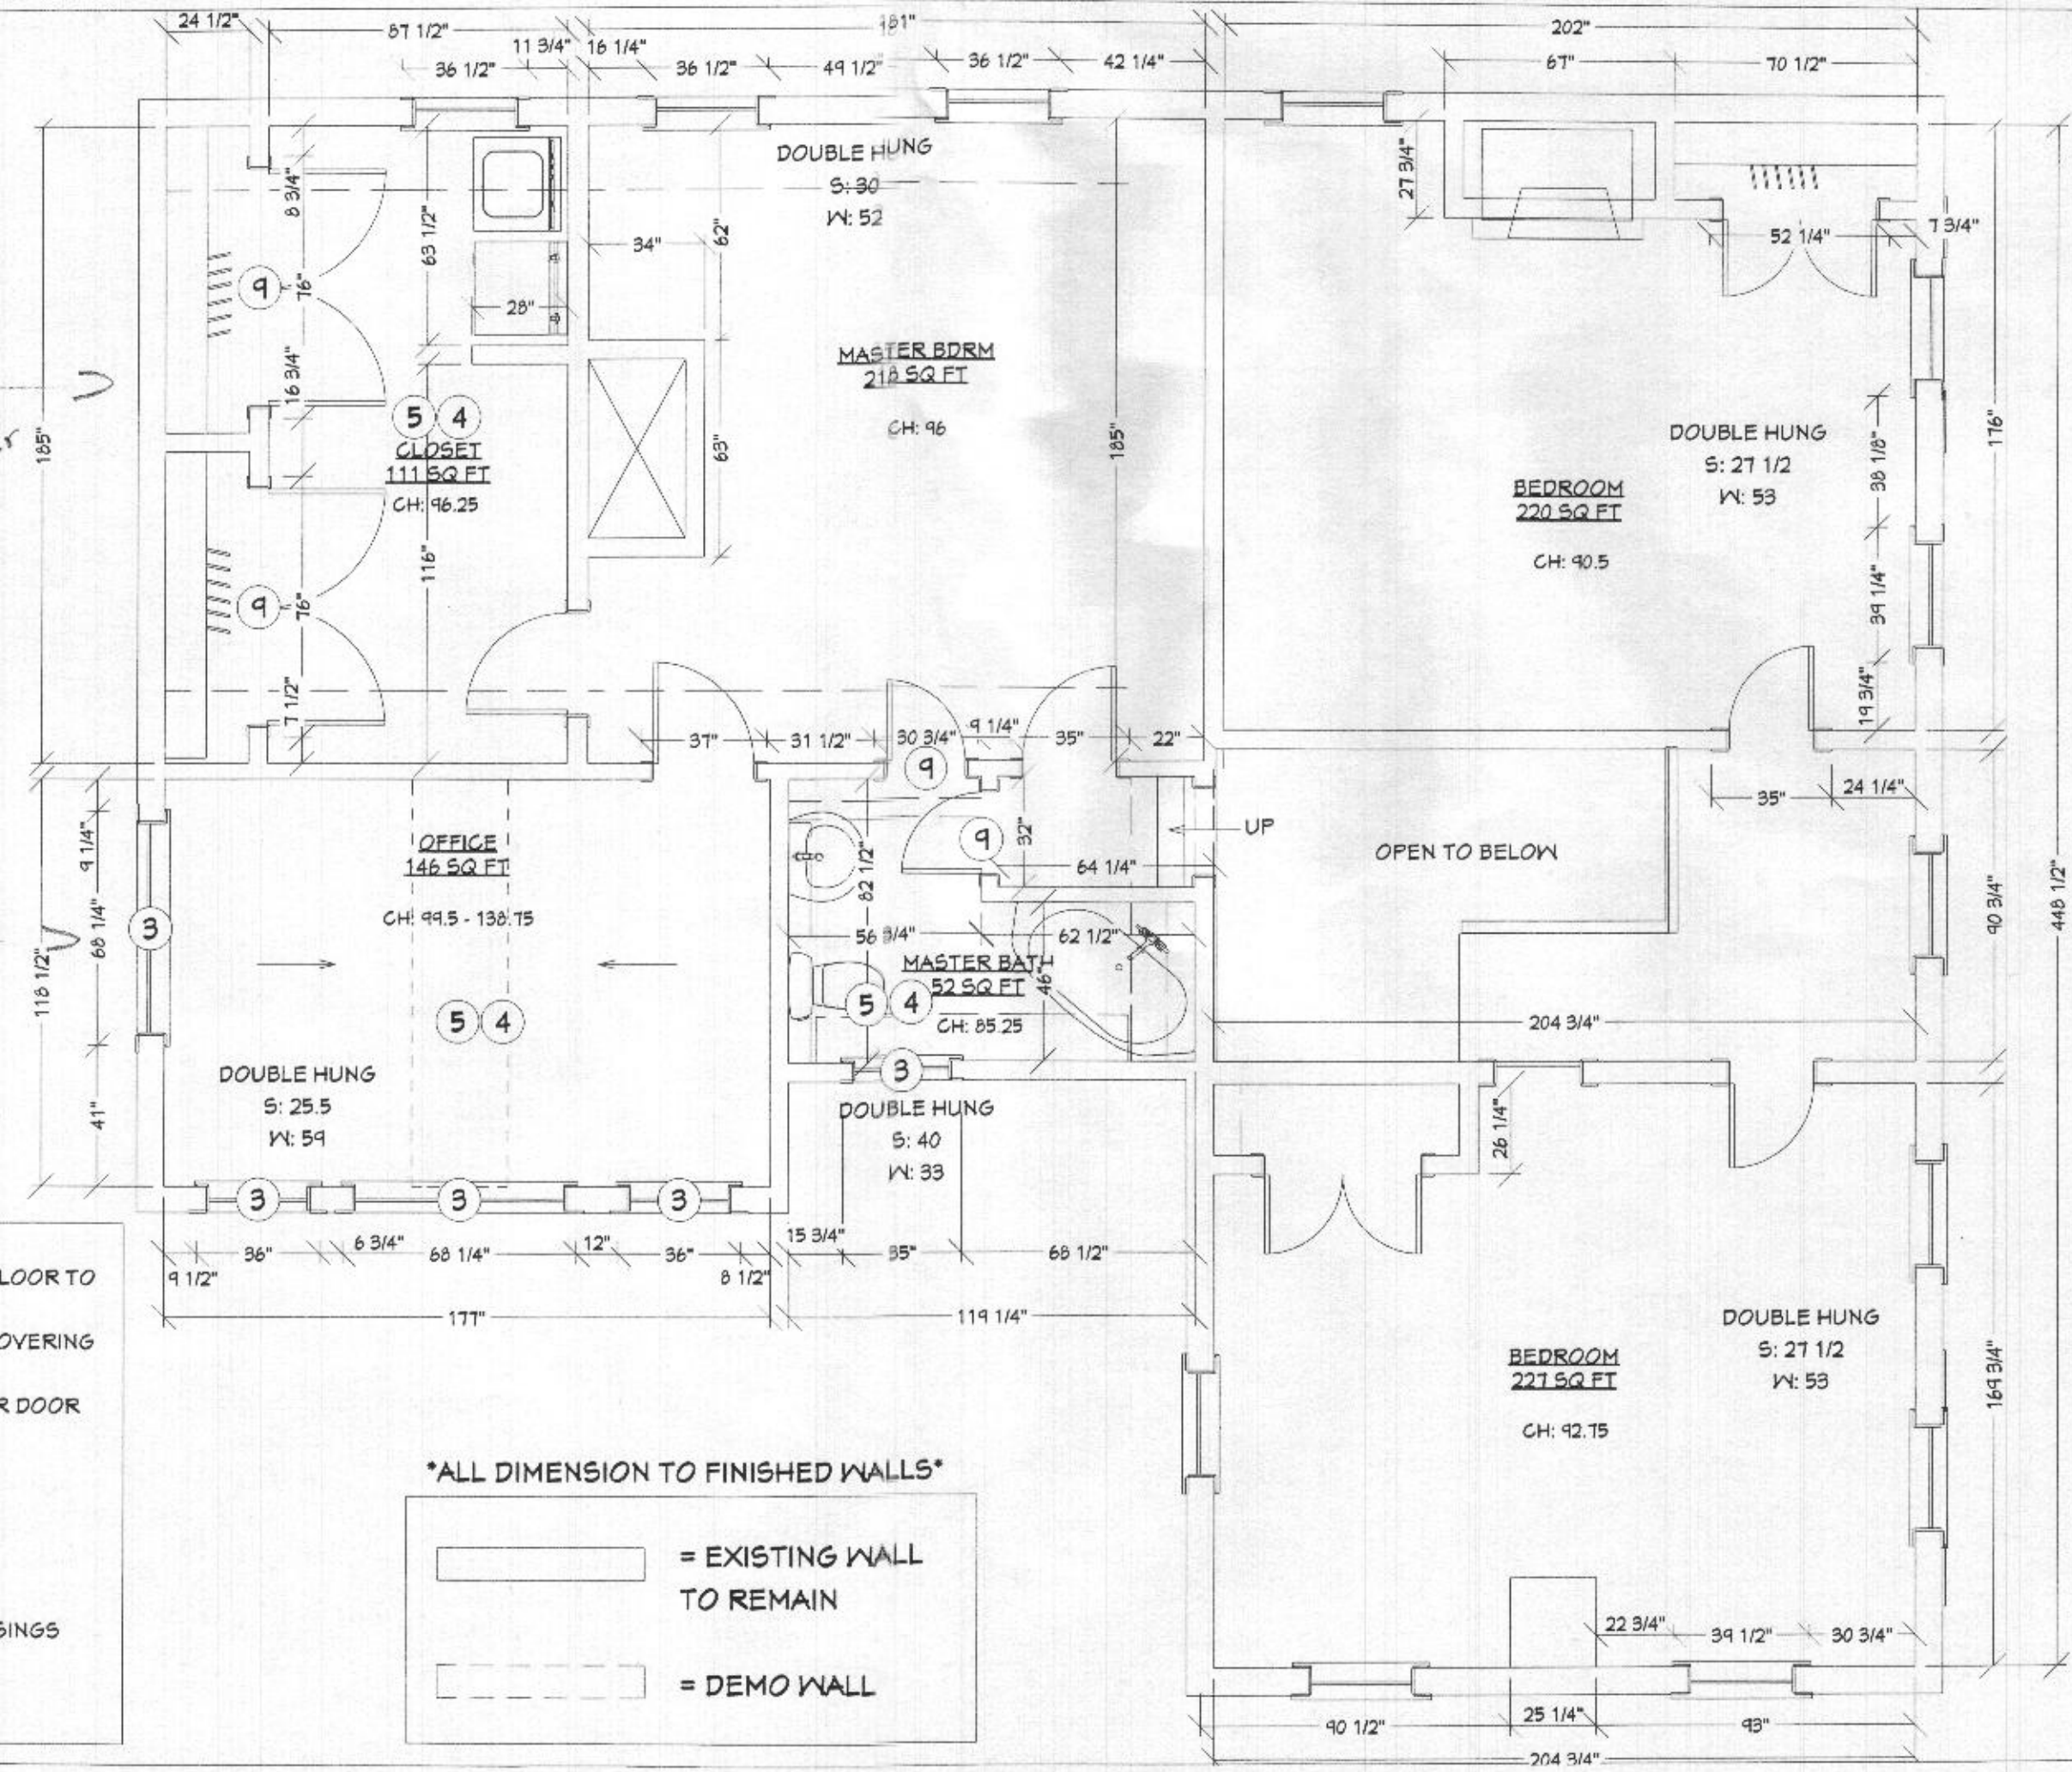
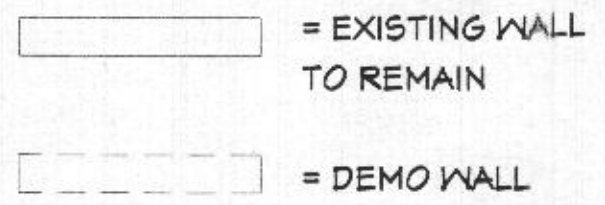
DATE:
 10/8/2019

SCALE:
 1/4"

SHEET:
 4

- GENERAL NOTES**
1. REMOVE FINISH FLOOR + SUBFLOOR TO JOIST
 2. REMOVE PLASTER/DRYWALL COVERING COMPLETE
 3. REMOVE WINDOWS + EXTERIOR DOOR
 4. REMOVE ALL FINISHES + APPURTENANCES
 5. REMOVE INTERIOR TRIMS
 6. REMOVE WALL + FLOOR TILE
 7. EXISTING TUB TO REMAIN
 8. EXISTING CABINET TO REMAIN
 9. REMOVE INTERIOR DOOR + CASINGS COMPLETE

ALL DIMENSION TO FINISHED WALLS



FIRST FLOOR
PROPOSED NEW PLAN

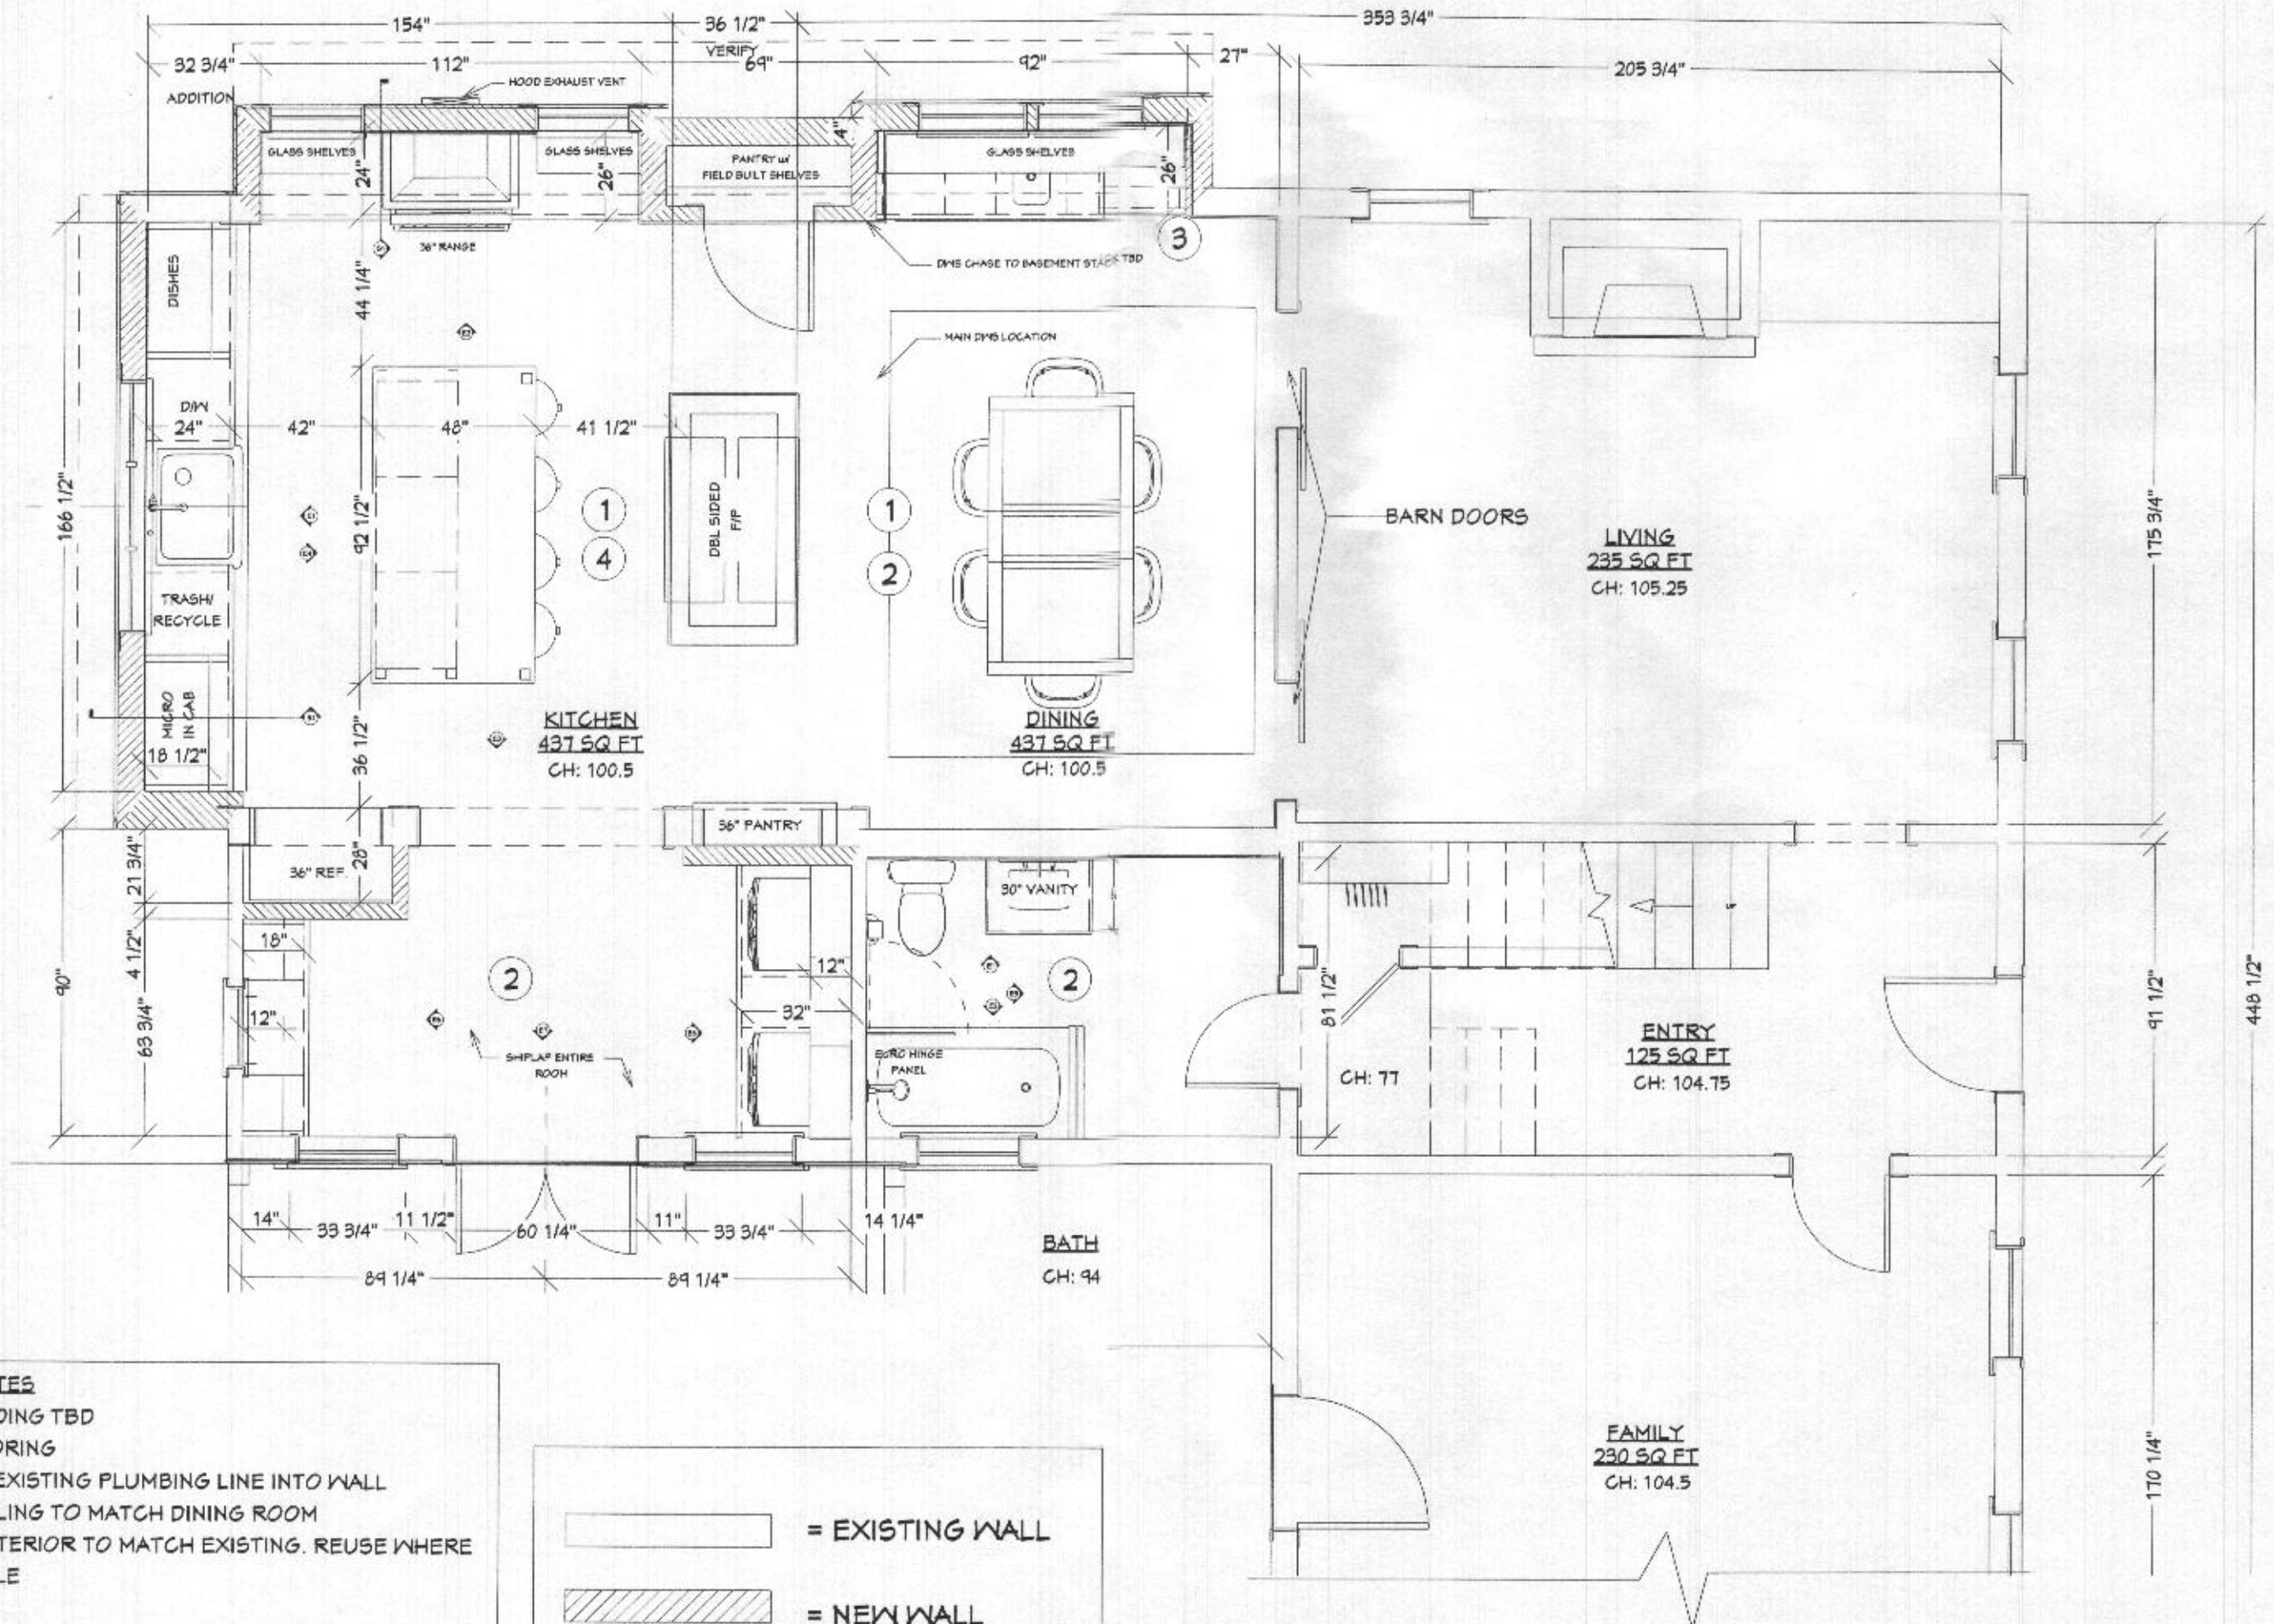
FIRST RESIDENCE
4152 ROXBURY MILL ROAD
GLENWOOD, MARYLAND

REVISIONS:

DATE:
10/8/2019


SCALE:
1/4"

SHEET:
5



GENERAL NOTES

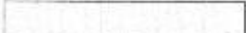1. NEW MOLDING TBD
2. NEW FLOORING
3. REWORK EXISTING PLUMBING LINE INTO WALL
4. RAISE CEILING TO MATCH DINING ROOM
5. DOORS INTERIOR TO MATCH EXISTING. REUSE WHERE APPLICABLE

 = EXISTING WALL
 = NEW WALL

SECOND FLOOR
PROPOSED NEW PLAN

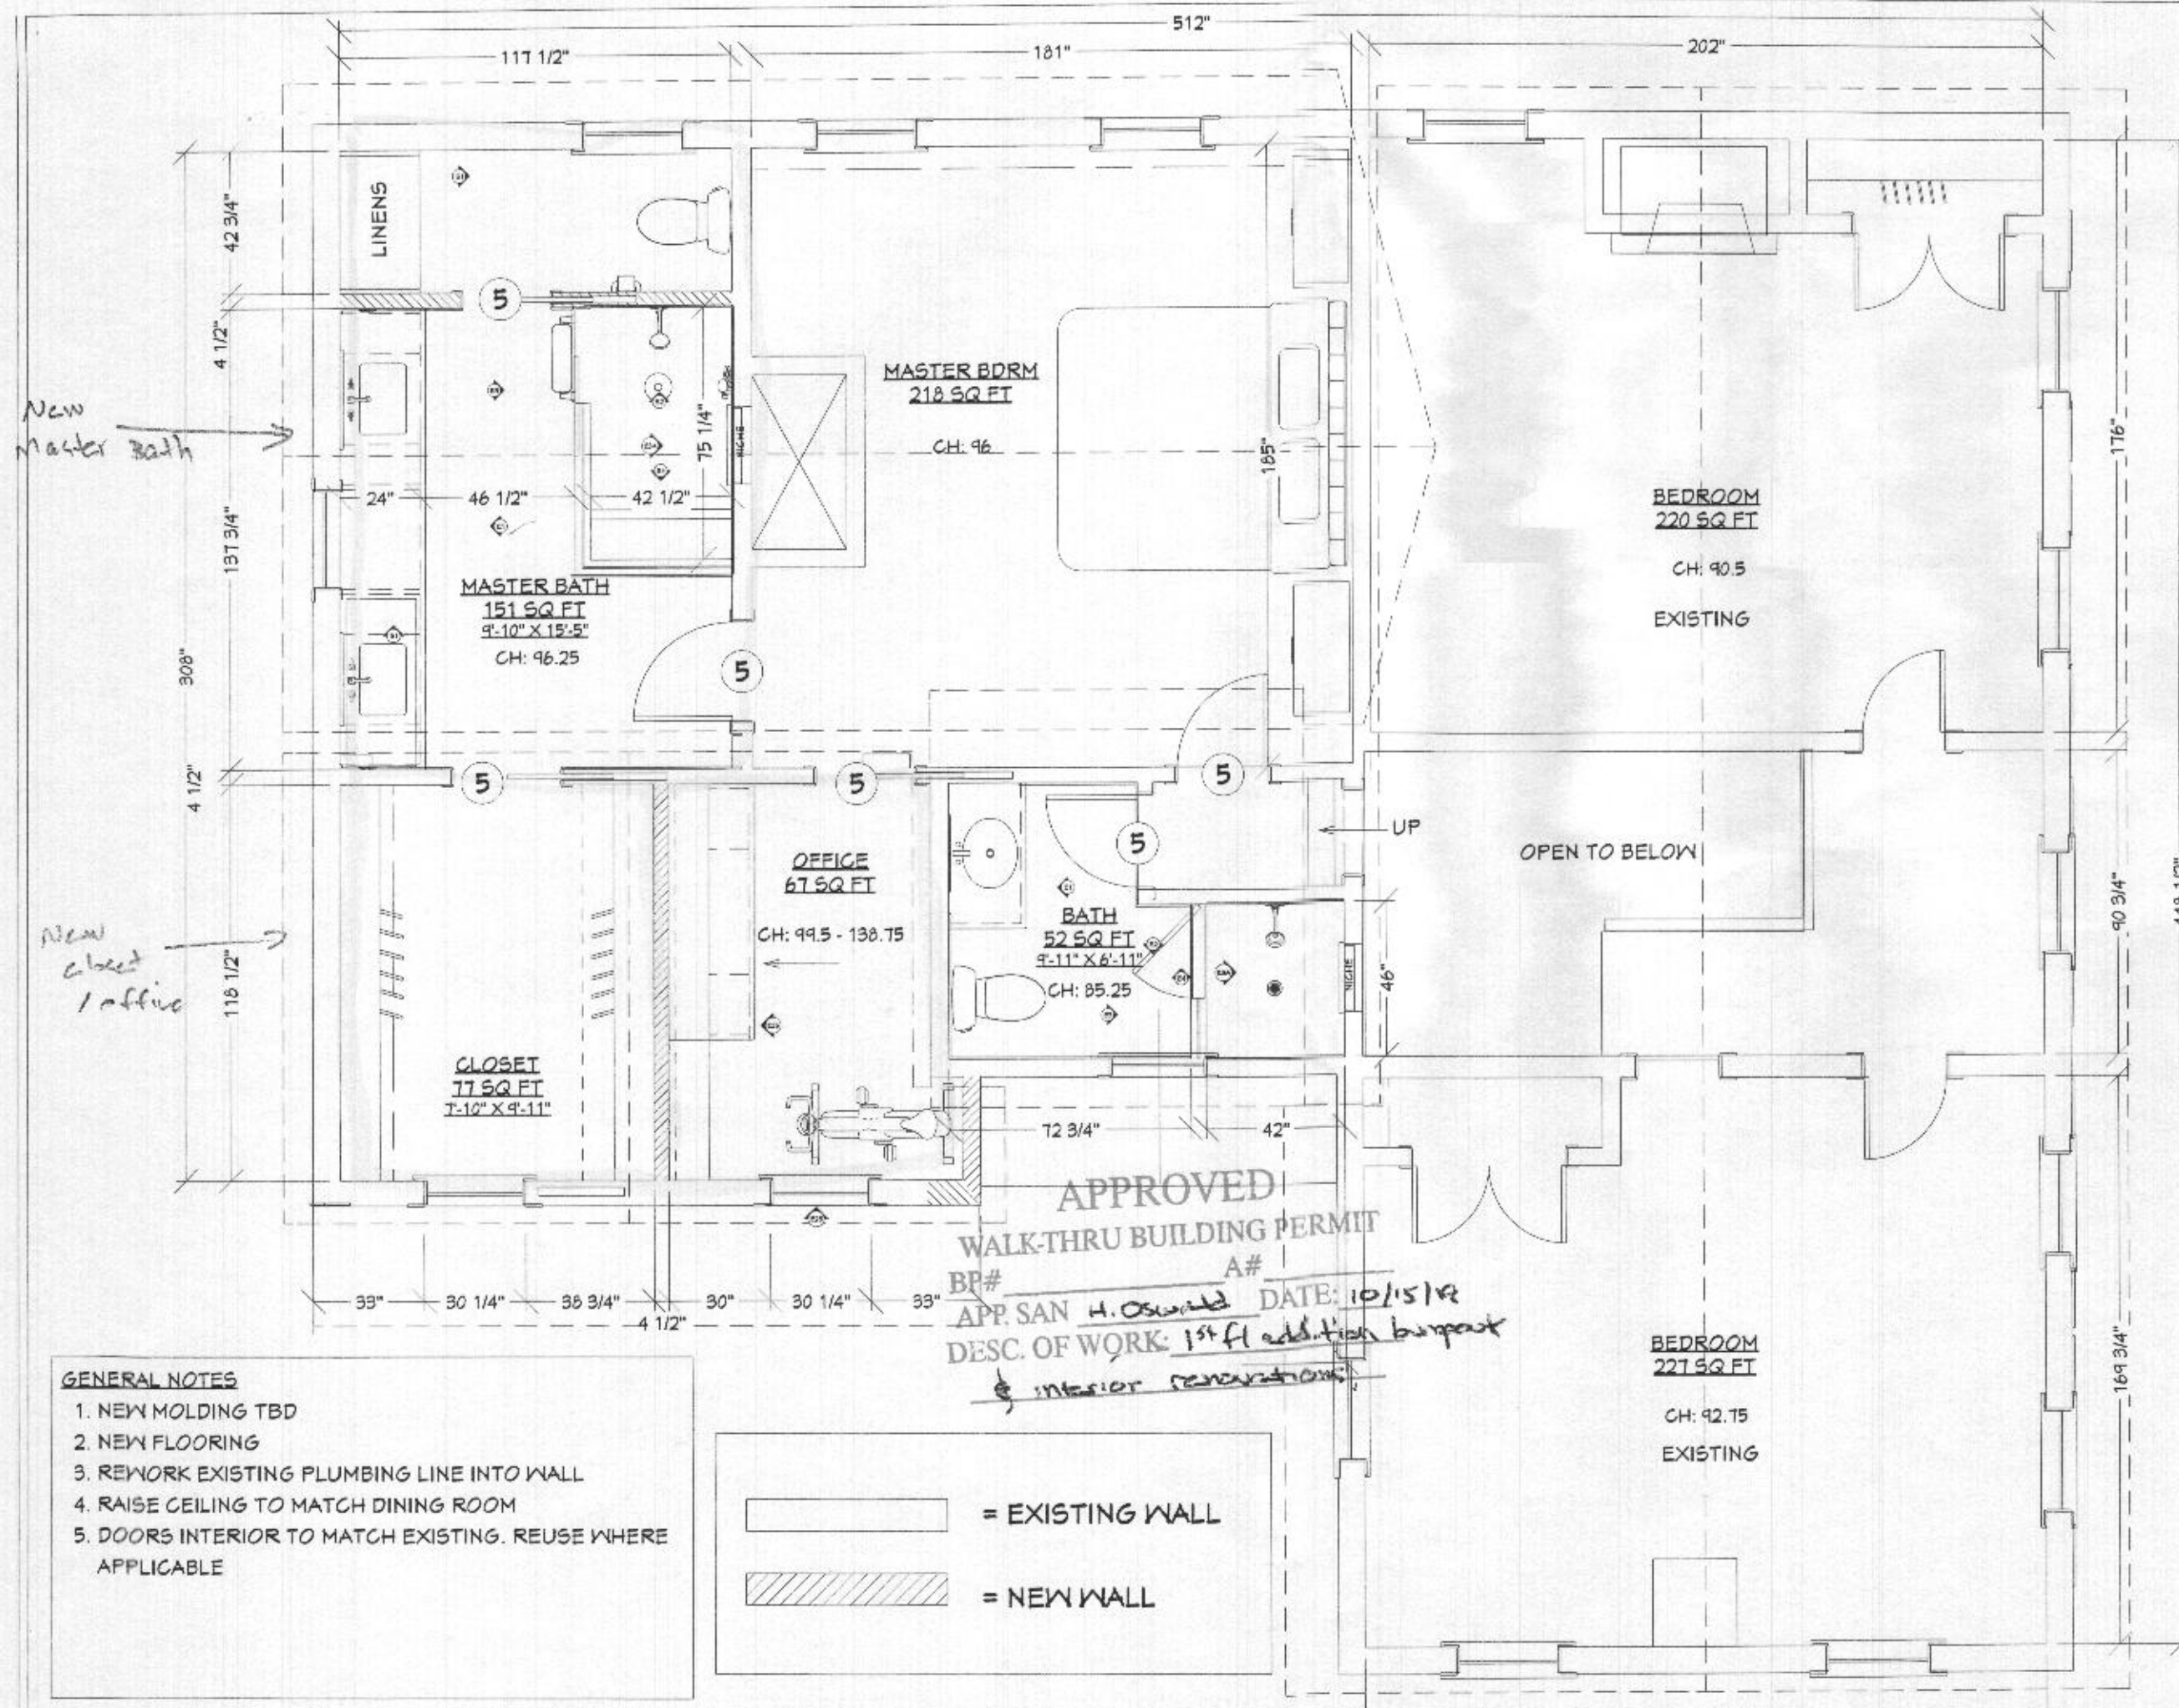
FURST RESIDENCE
4152 ROXBURY MILL ROAD
GLENWOOD, MARYLAND

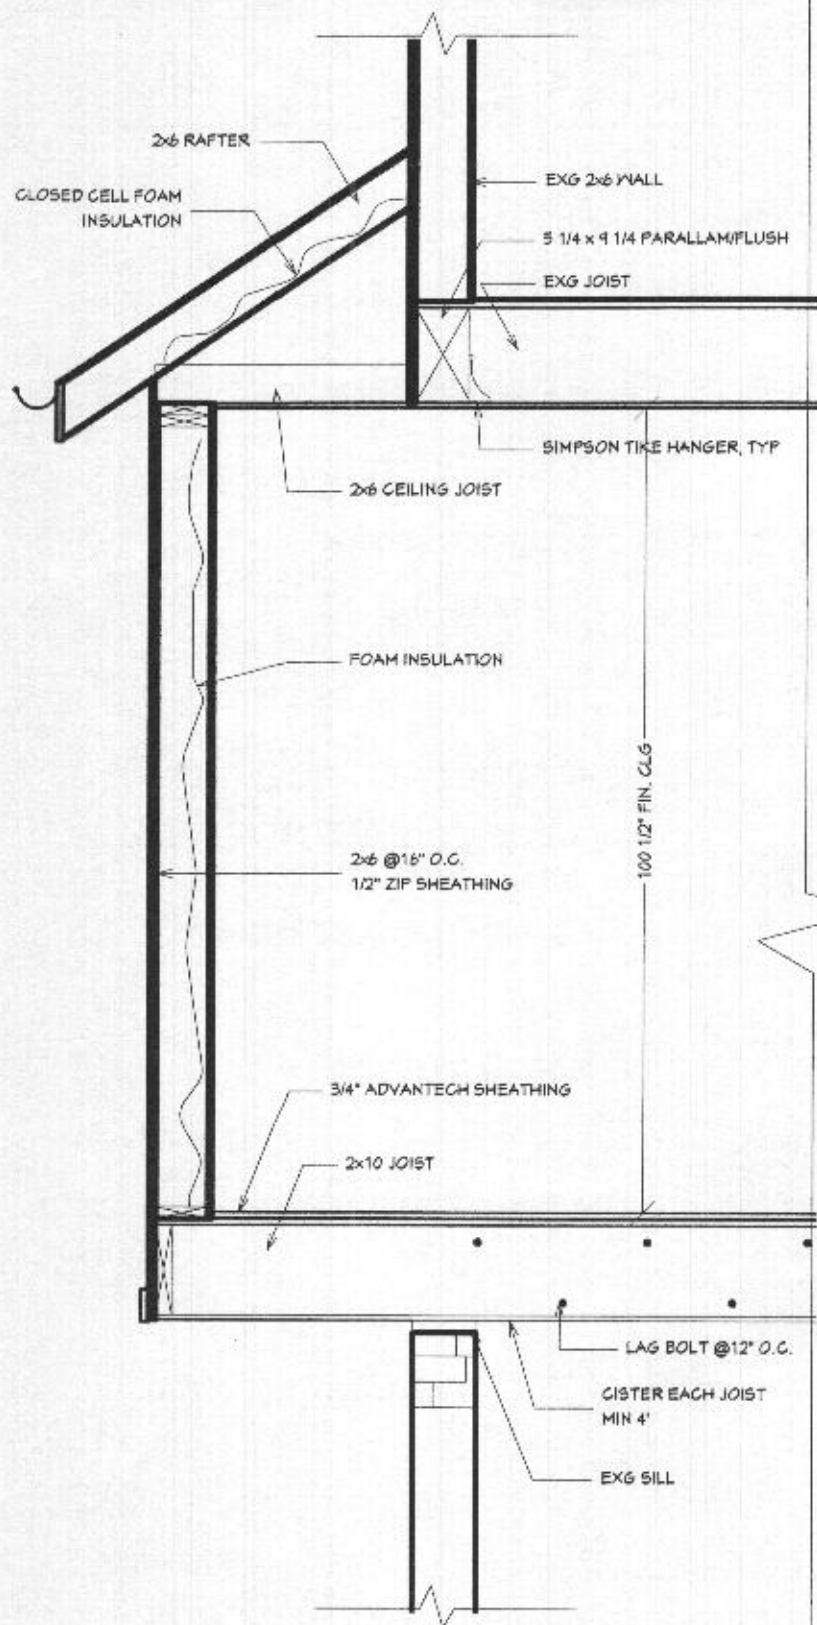
REVISIONS:

DATE:
10/8/2019


SCALE:
1/4








SHEET:
6





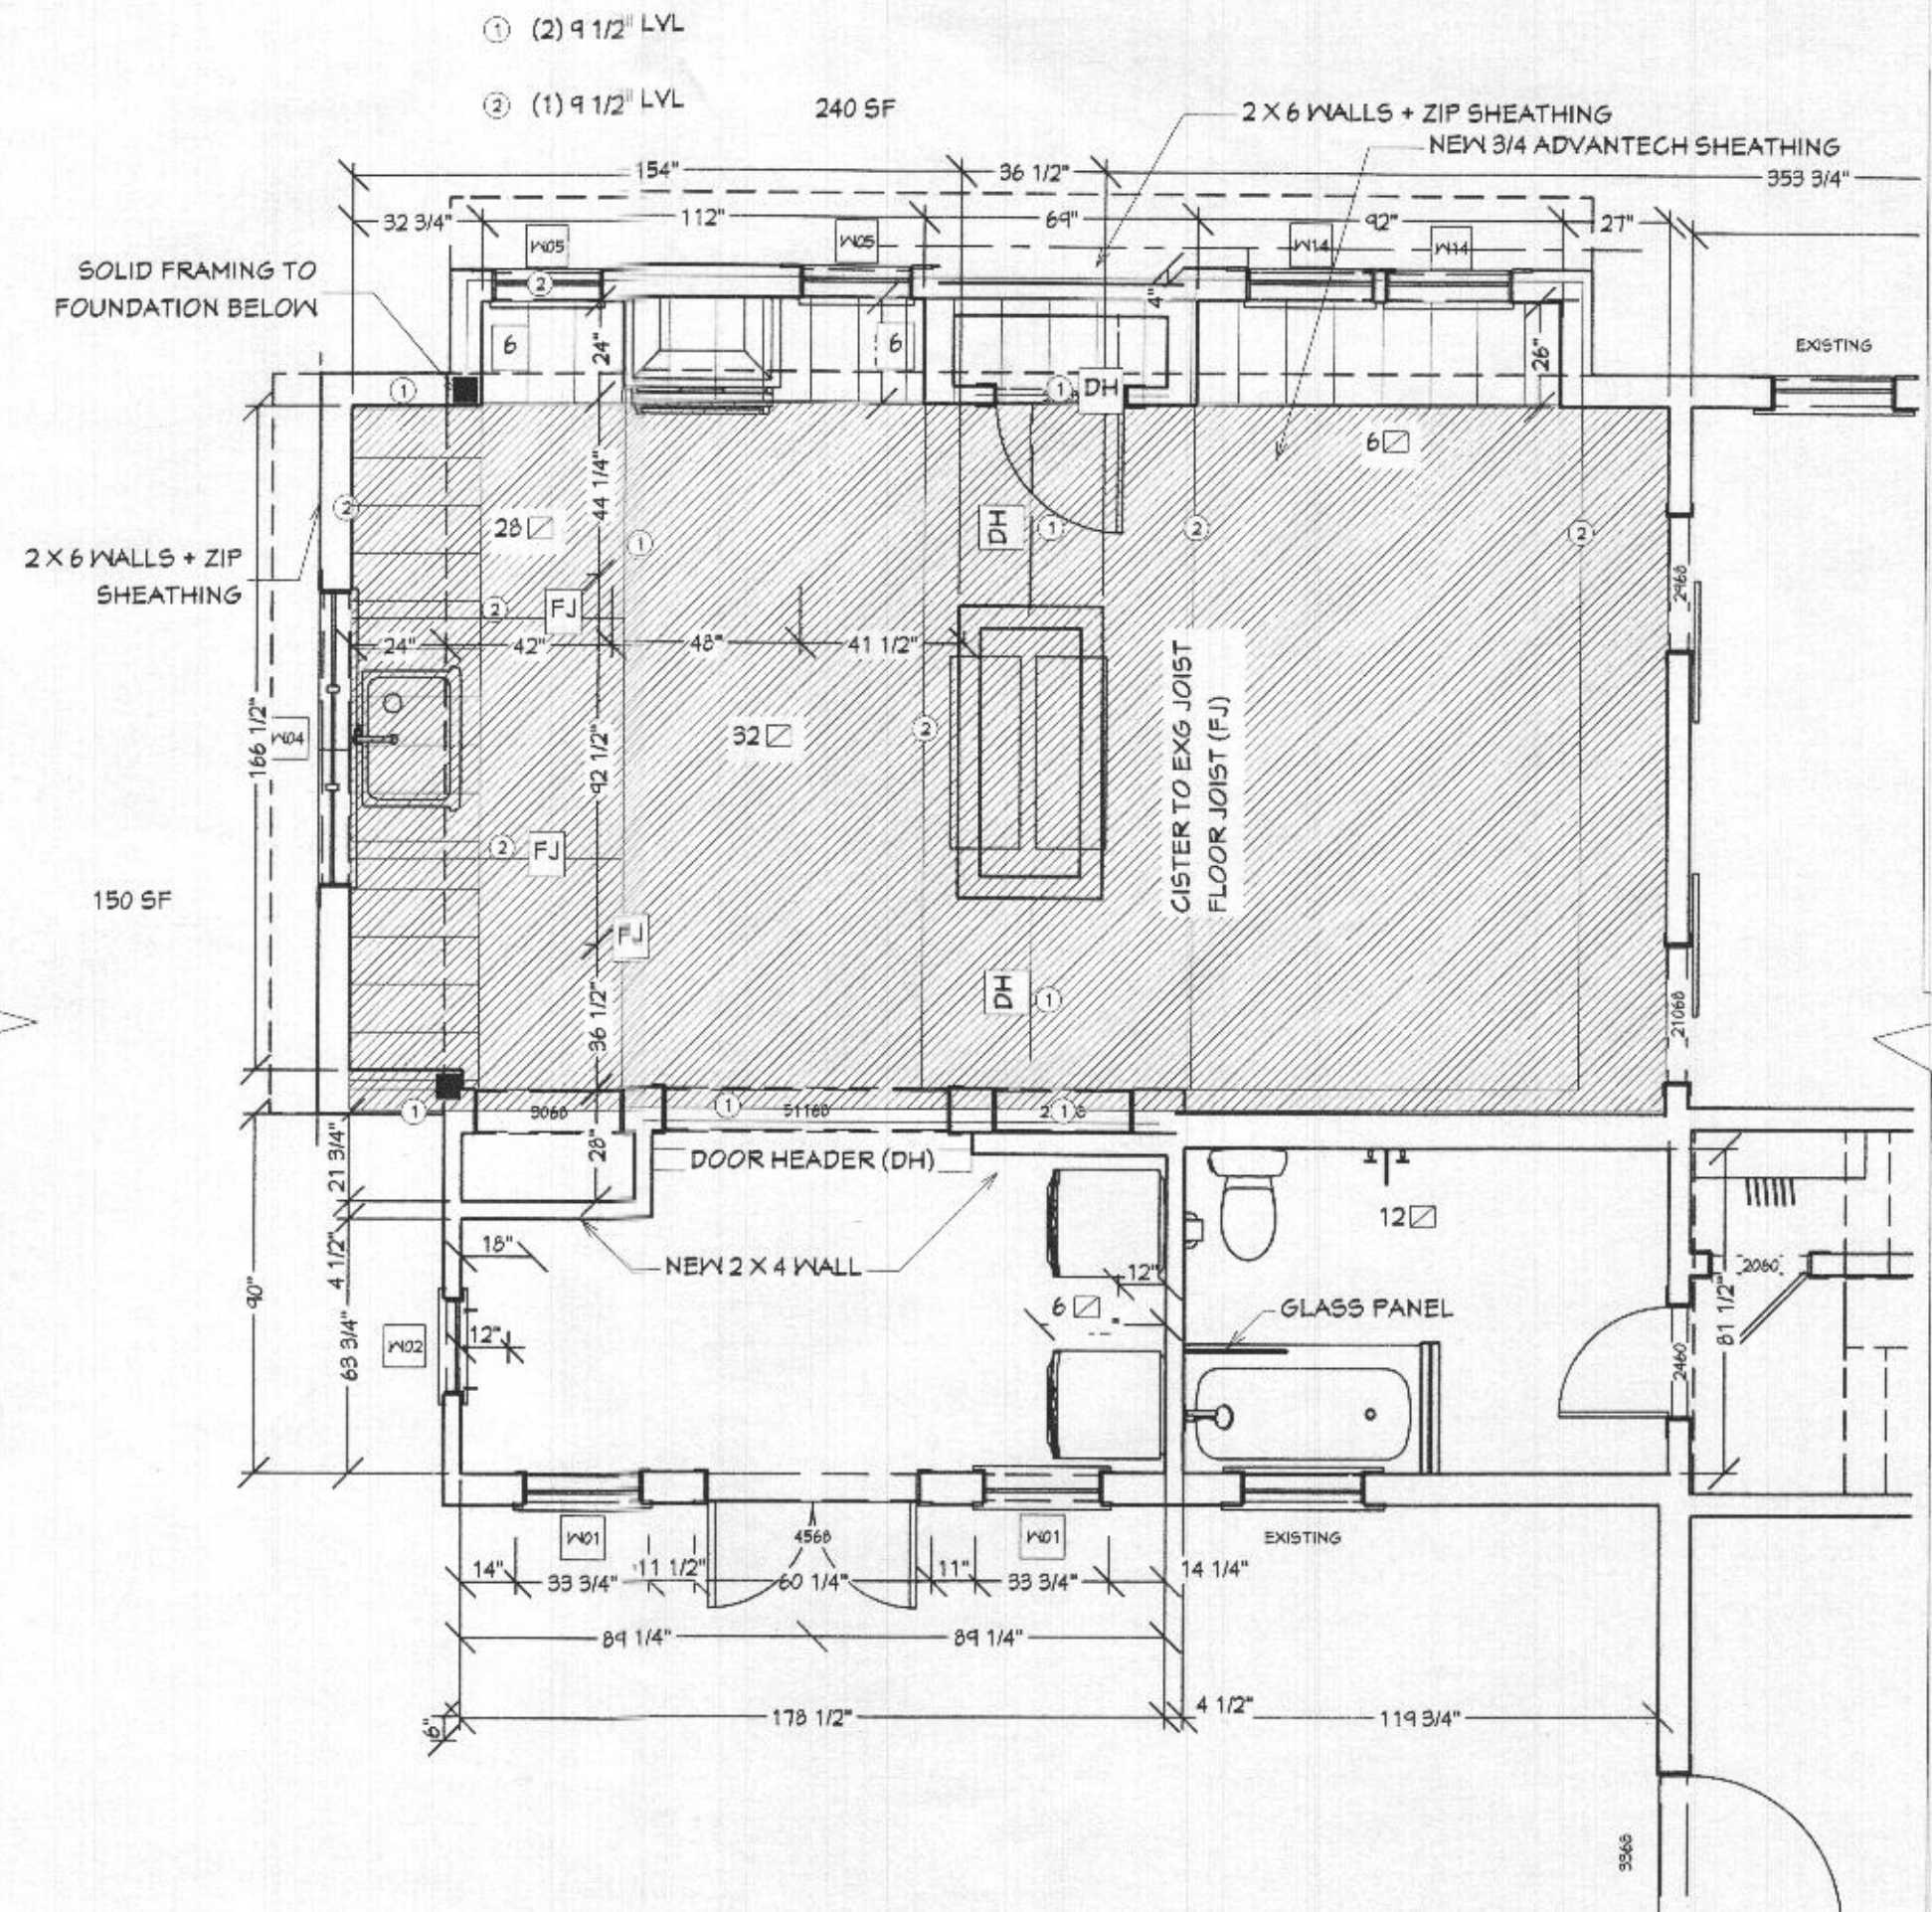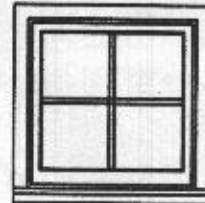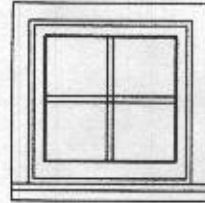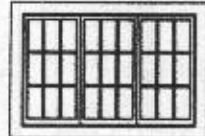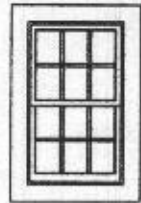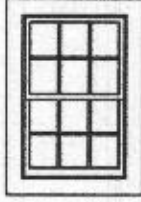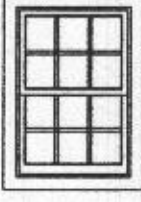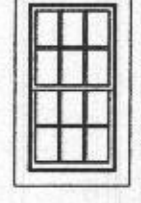S1 FRAMING SECTION @ SINK WALL
 1/2" = 1'-0"



WINDOW SCHEDULE															
NUMBER	LABEL	QTY	FLOOR	SIZE	WIDTH	HEIGHT	R/O	EGRESS	DESCRIPTION	HEADER	MANUFACTURER	COMMENTS	3D EXTERIOR ELEVATION	TOP	ROOM NAME
W01	2626FX	2	1	2626FX	30 "	30 "	31"X31"		FIXED GLASS	2X6X34" (2)				81 5/8"	ENTRY
W02	2020FX	1	1	2020FX	24 "	24 "	25"X25"		FIXED GLASS	2X6X28" (2)				81 5/8"	ENTRY
W04	6240TC	1	1	6240TC	74 "	48 "	75"X49"		TRIPLE CASEMENT-LHL/RHR	2X6X18" (2)				90"	KITCHEN
W05	2440DH	2	1	2440DH	28 "	48 "	29"X49"		DOUBLE HUNG	2X6X32" (2)				90"	KITCHEN
W14	2843DH	2	1	2843DH	32 "	50 3/4 "	33"X51 3/4"		DOUBLE HUNG	2X6X36" (2)				92"	DINING
W16	2639DH	1	2	2639DH	30 "	45 "	31"X46"		DOUBLE HUNG	2X6X34" (2)				88 5/8"	MASTER BATH
W17	26411DH	1	2	26411DH	30 1/4 "	59 "	31 1/4"X60"		DOUBLE HUNG	2X6X34 1/4" (2)				84 1/2"	CLOSET
W18	26411DH	1	2	26411DH	30 1/4 "	59 "	31 1/4"X60"		DOUBLE HUNG	2X6X34 1/4" (2)				84 1/2"	OFFICE