

FIRST FLOOR
ELECTRICAL PLAN


FURST RESIDENCE
4152 ROXBURY MILL ROAD
GLENWOOD, MARYLAND

REVISIONS:

DATE:
10/8/2019


SCALE:

SHEET:
9

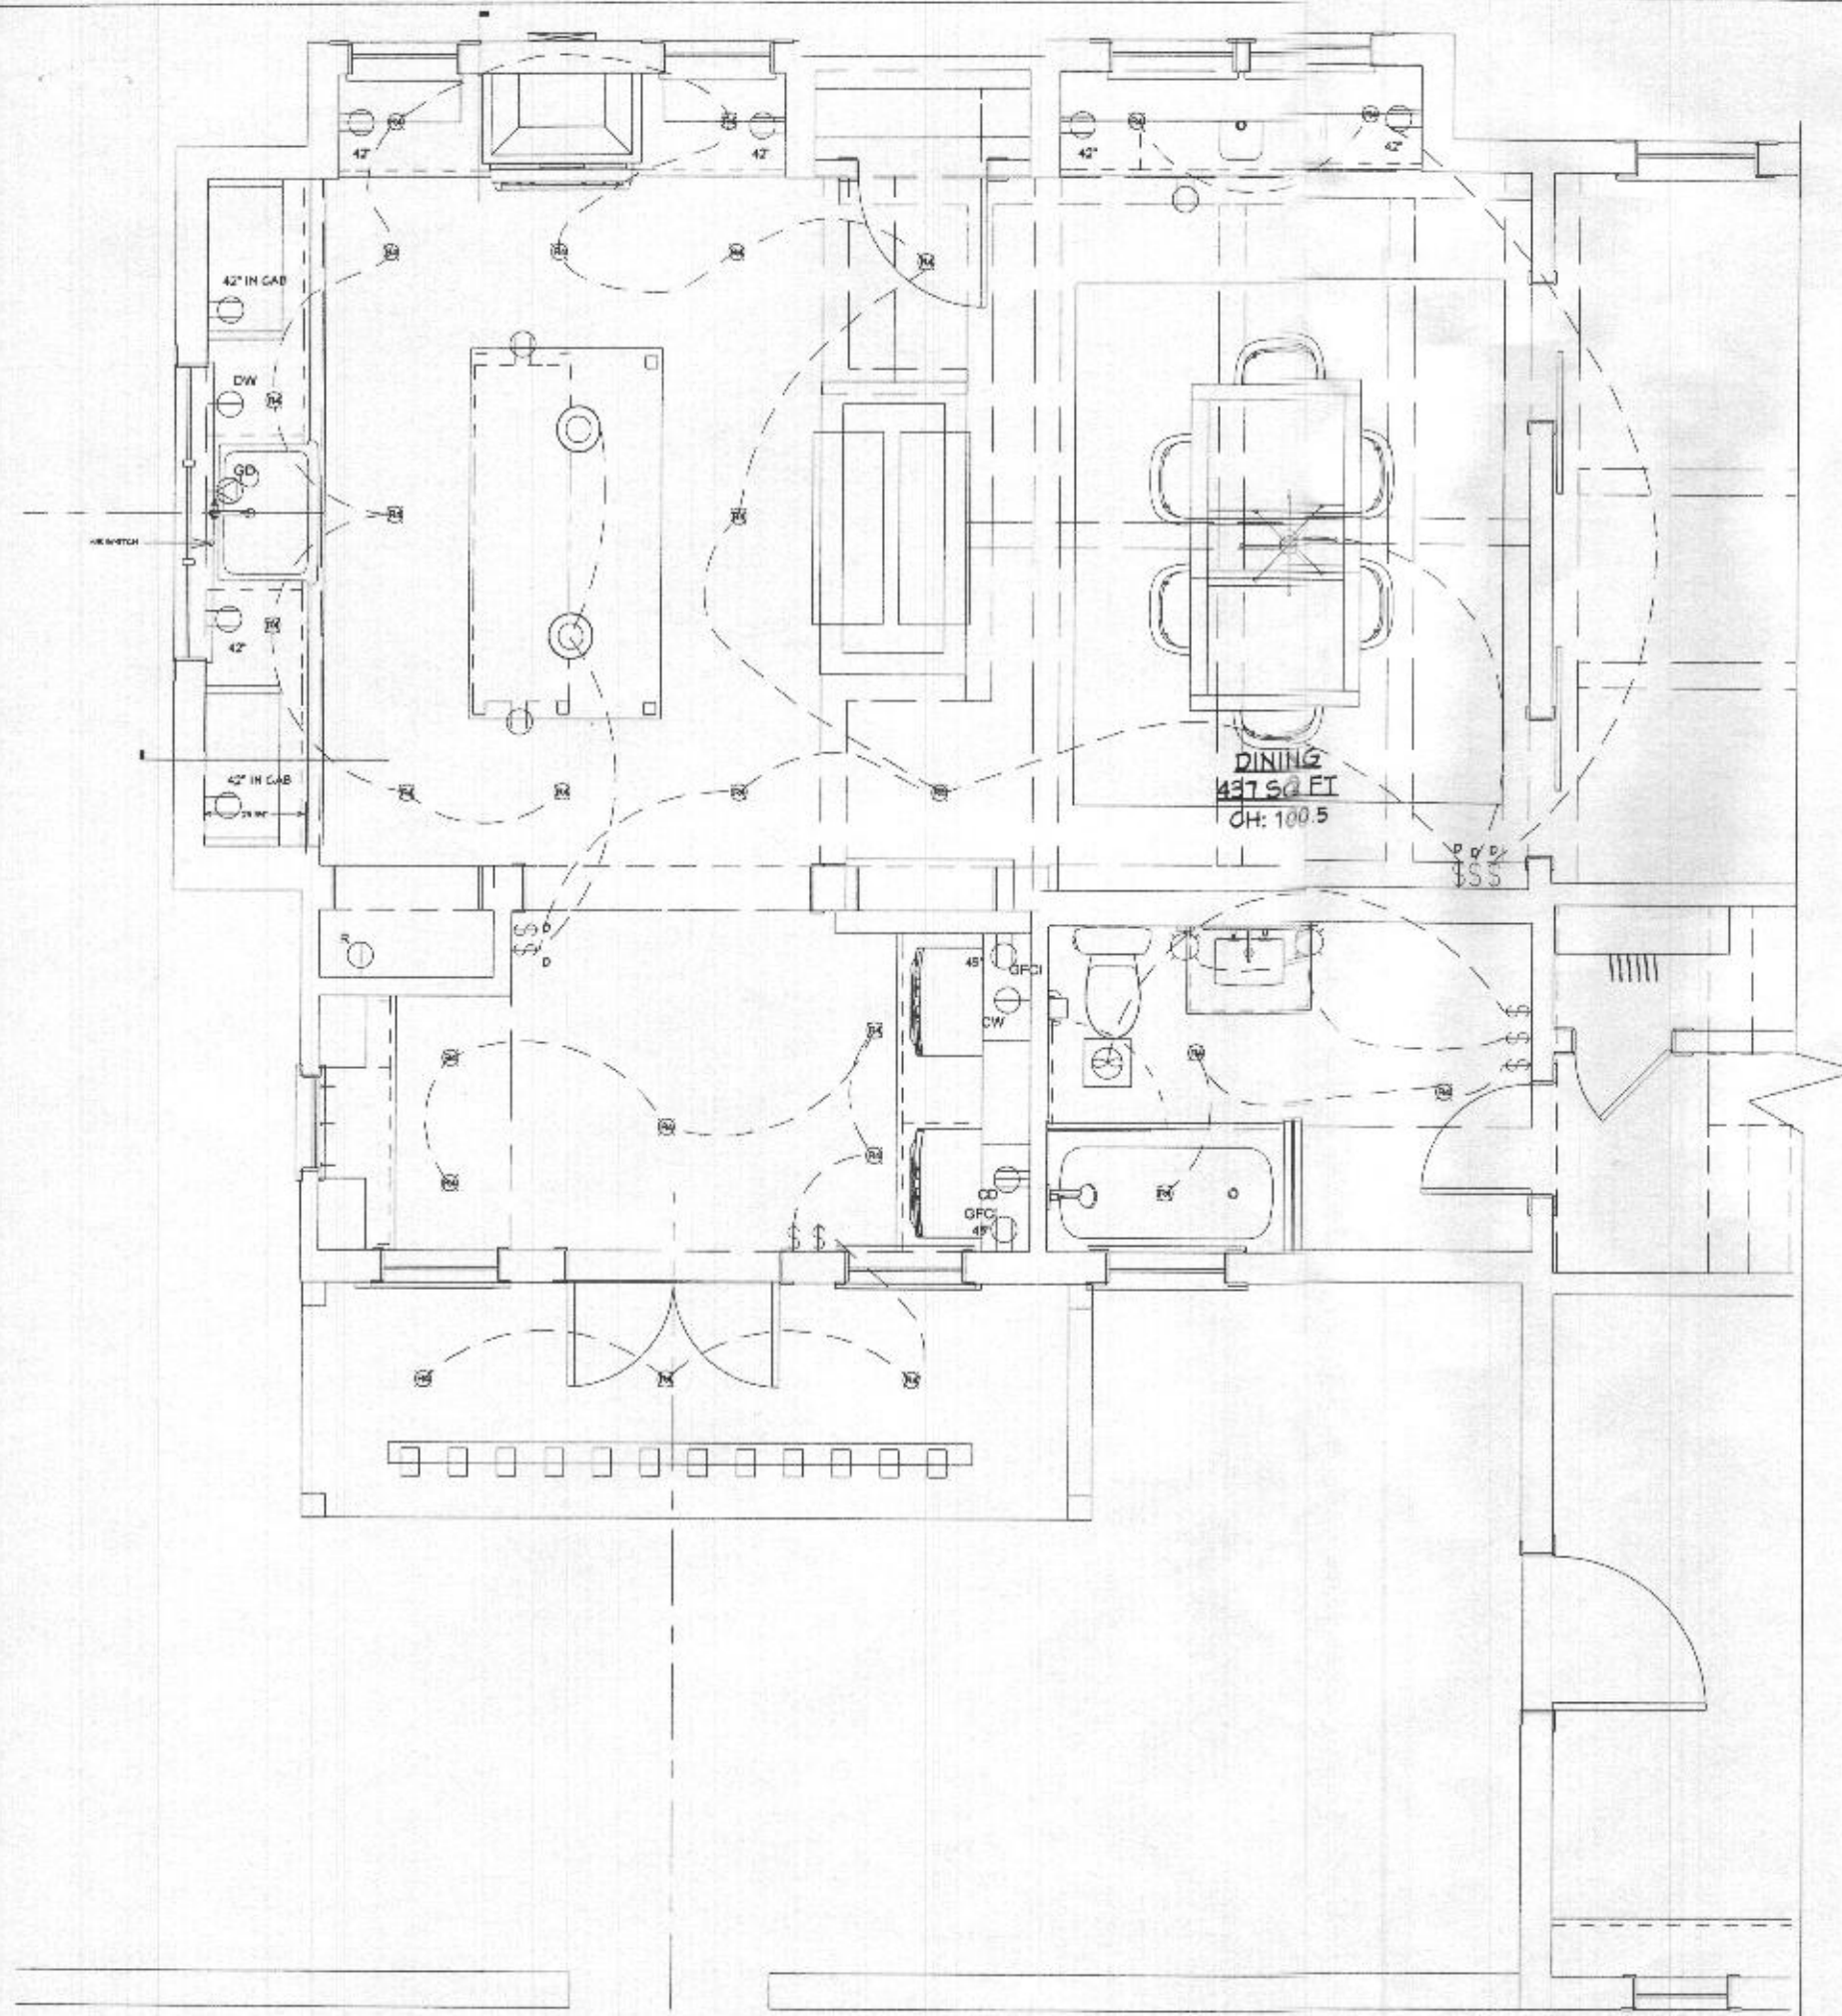

ELECTRICAL LEGEND:

- DUPLEX OUTLET
- 4" RECESSED
- SURFACE MOUNT PENDANT
- SURFACE MOUNT CHANDELIER
- LED UNDERCAB. LIGHTING
- DW
- HOOD
- REF/FRZ
- WASHER
- DRYER

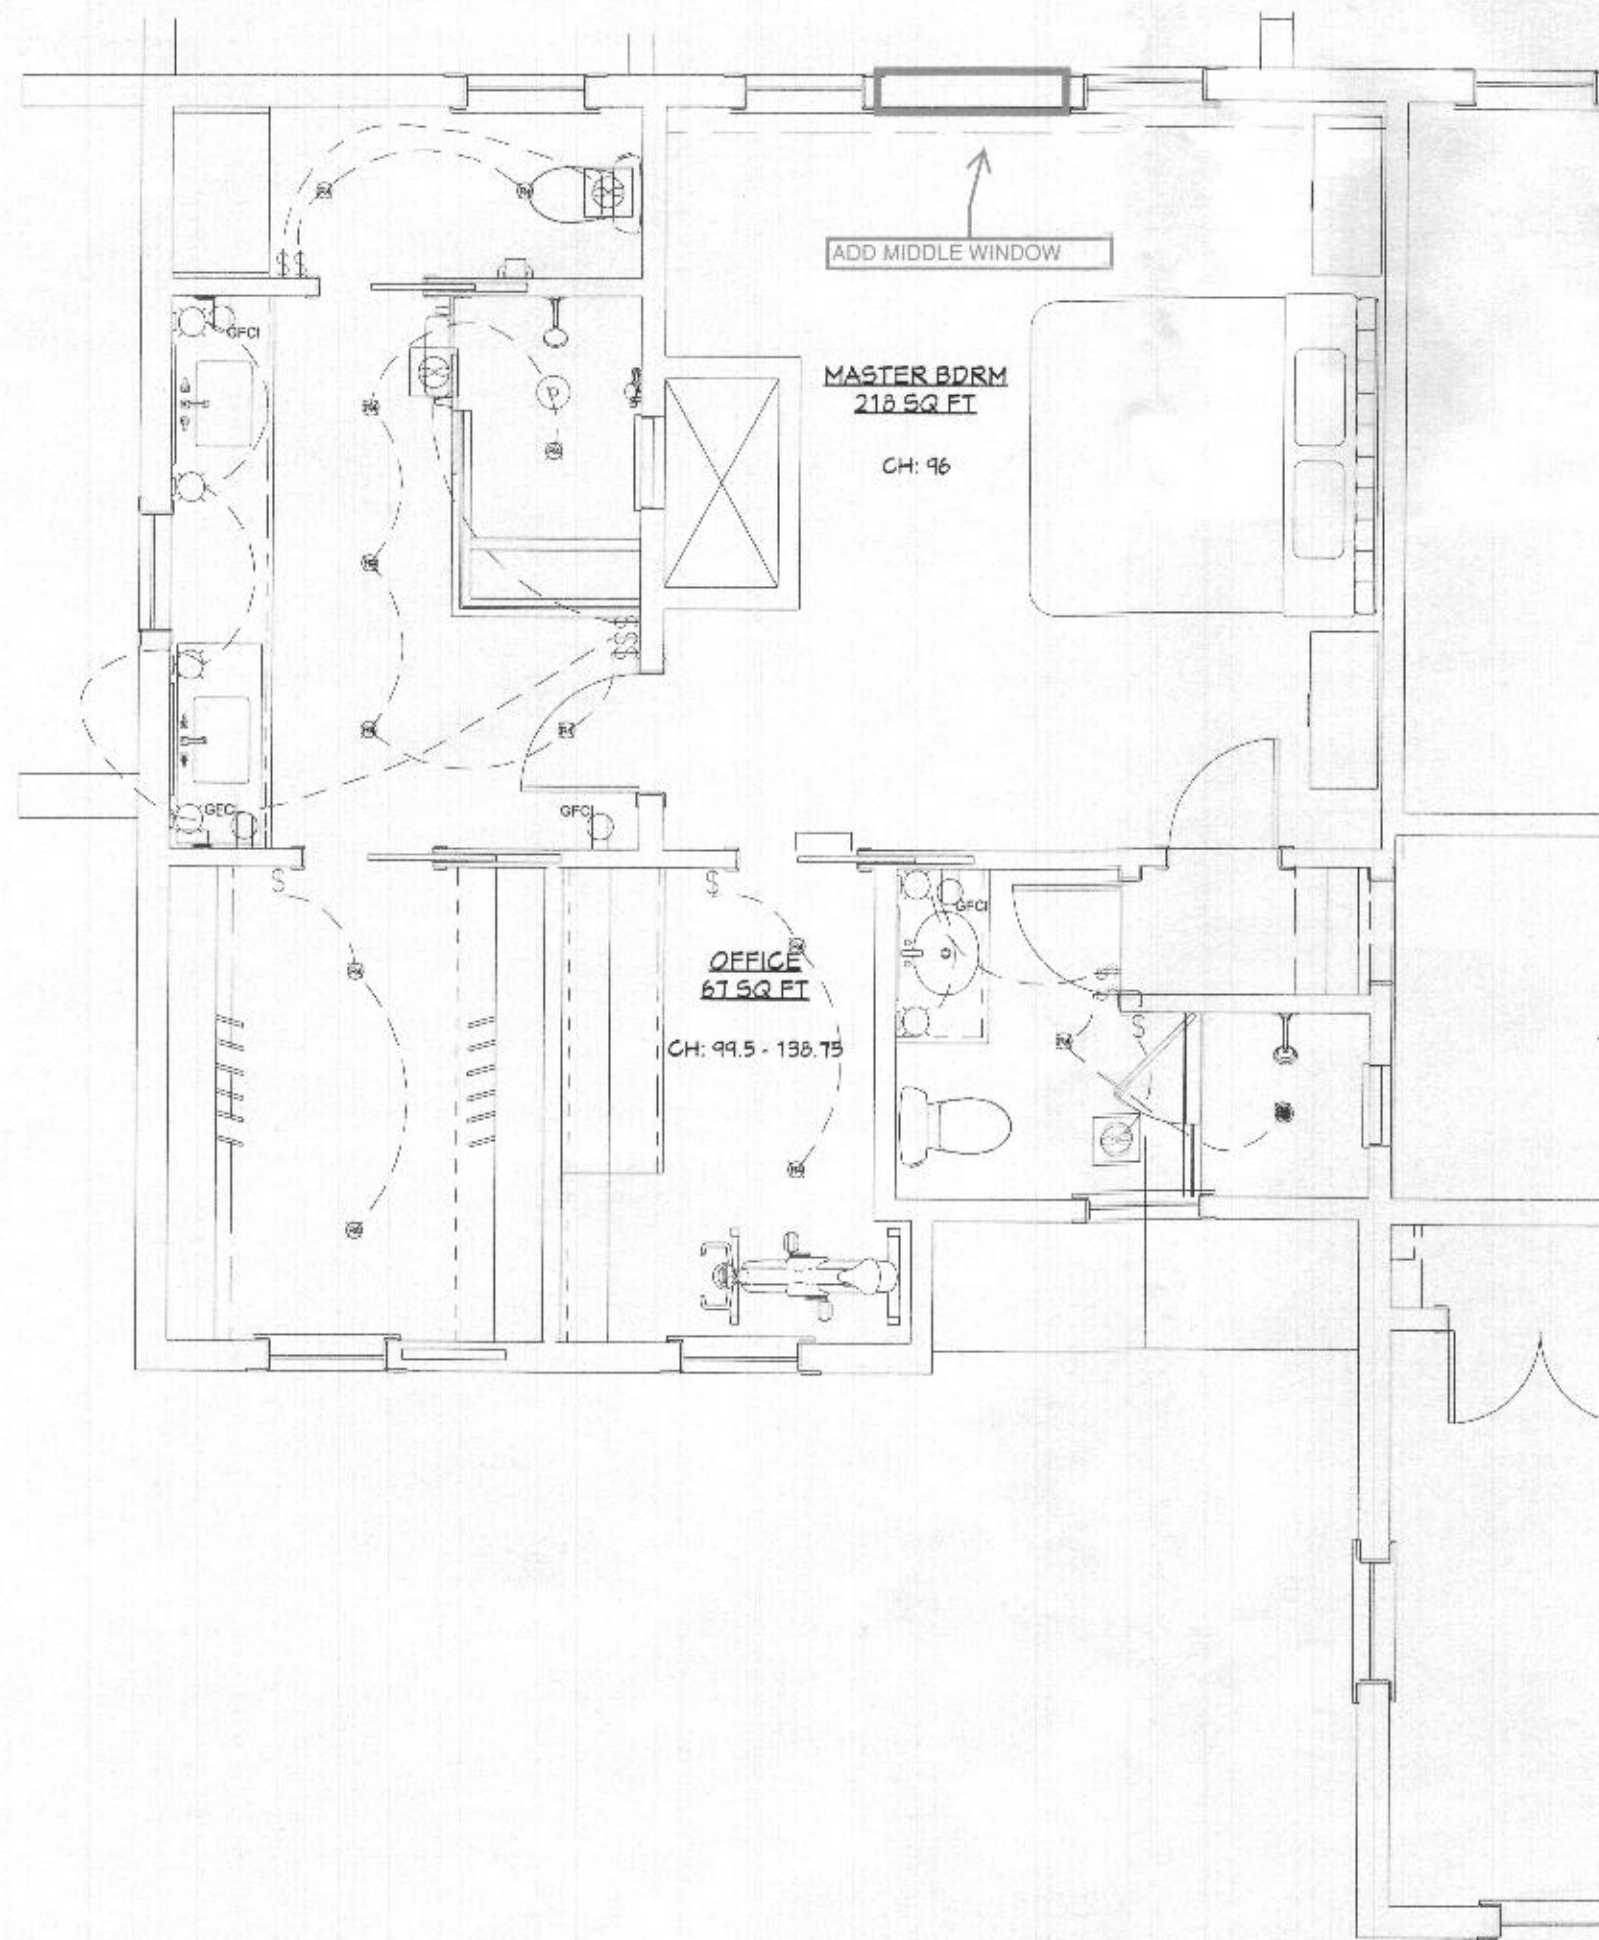

ELECTRICAL LEGEND	
	TIMER, PUSH BUTTON
	TOGGLE, SLIDE DIMMER
	DUPLEX OUTLET
	4" RECESSED - SPEC TBD
	4" RECESSED - FOR WET USE, SPEC TBD
	WALL SCONCE MTD. AT 66" AFF - TBD
	EXHAUST

SECOND FLOOR ELECTRICAL PLAN

FIRST RESIDENCE
4152 ROXBURY MILL ROAD
GLENWOOD, MARYLAND

REVISIONS:


DATE:
10/8/2019

SCALE:


SHEET:
10




NEW MUDROOM ENTRY ELEVATION

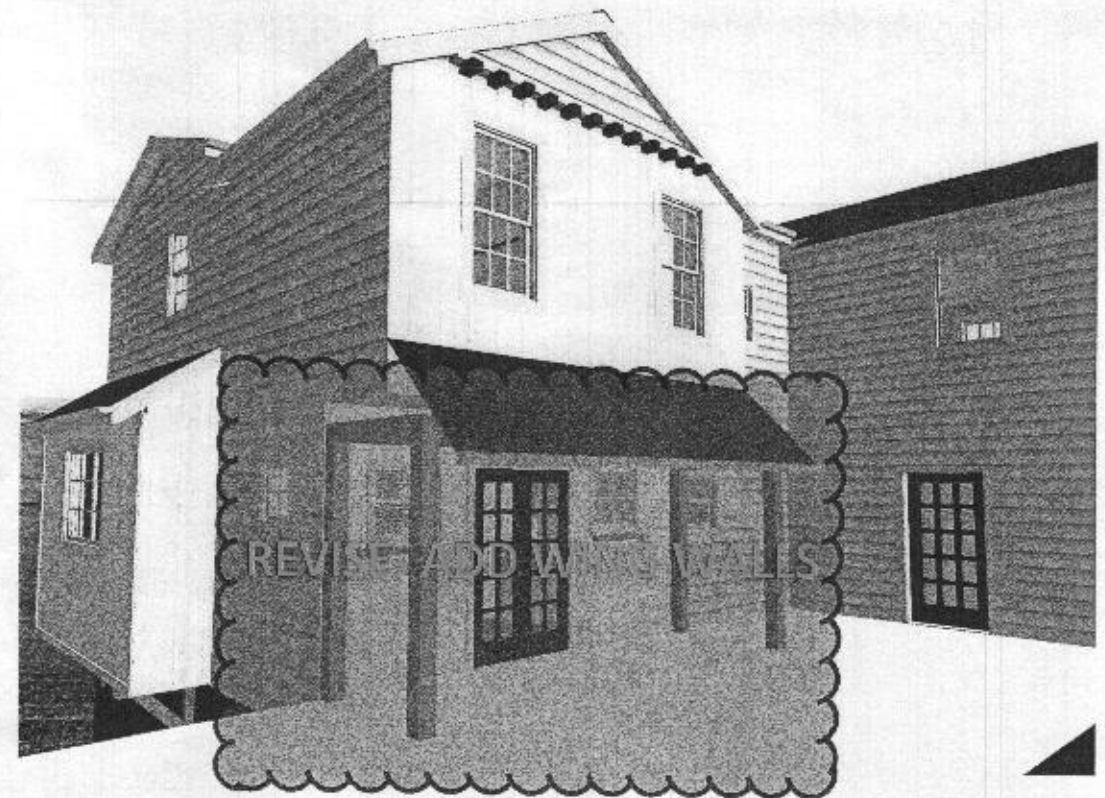

3-D RENDERING

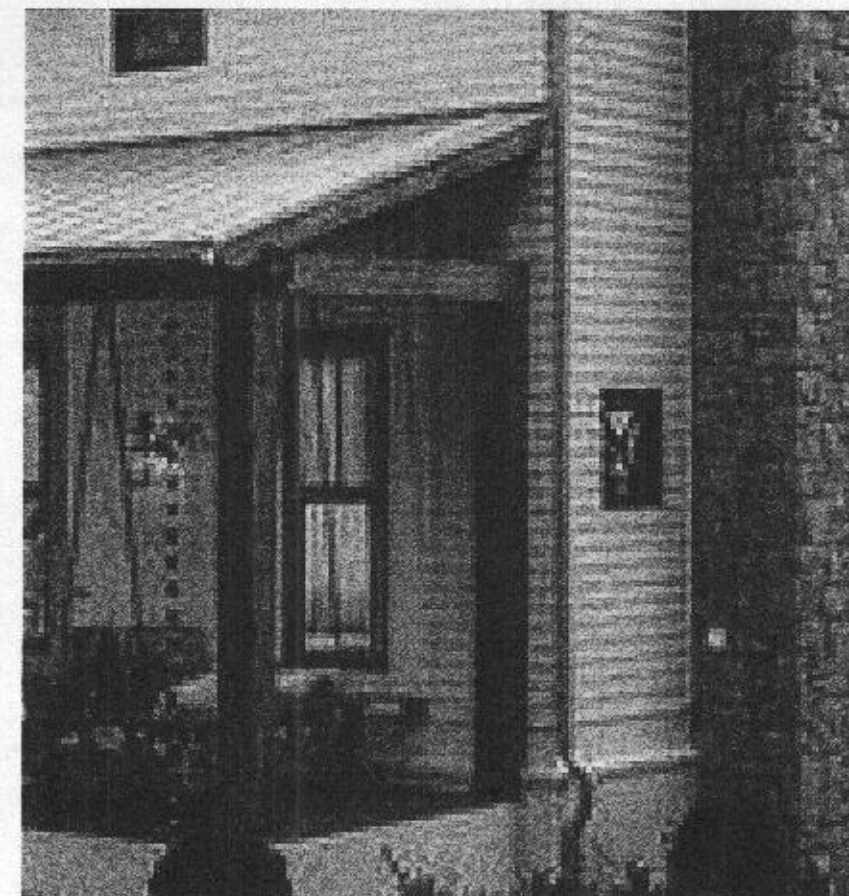

EXTERIOR INSPIRATION

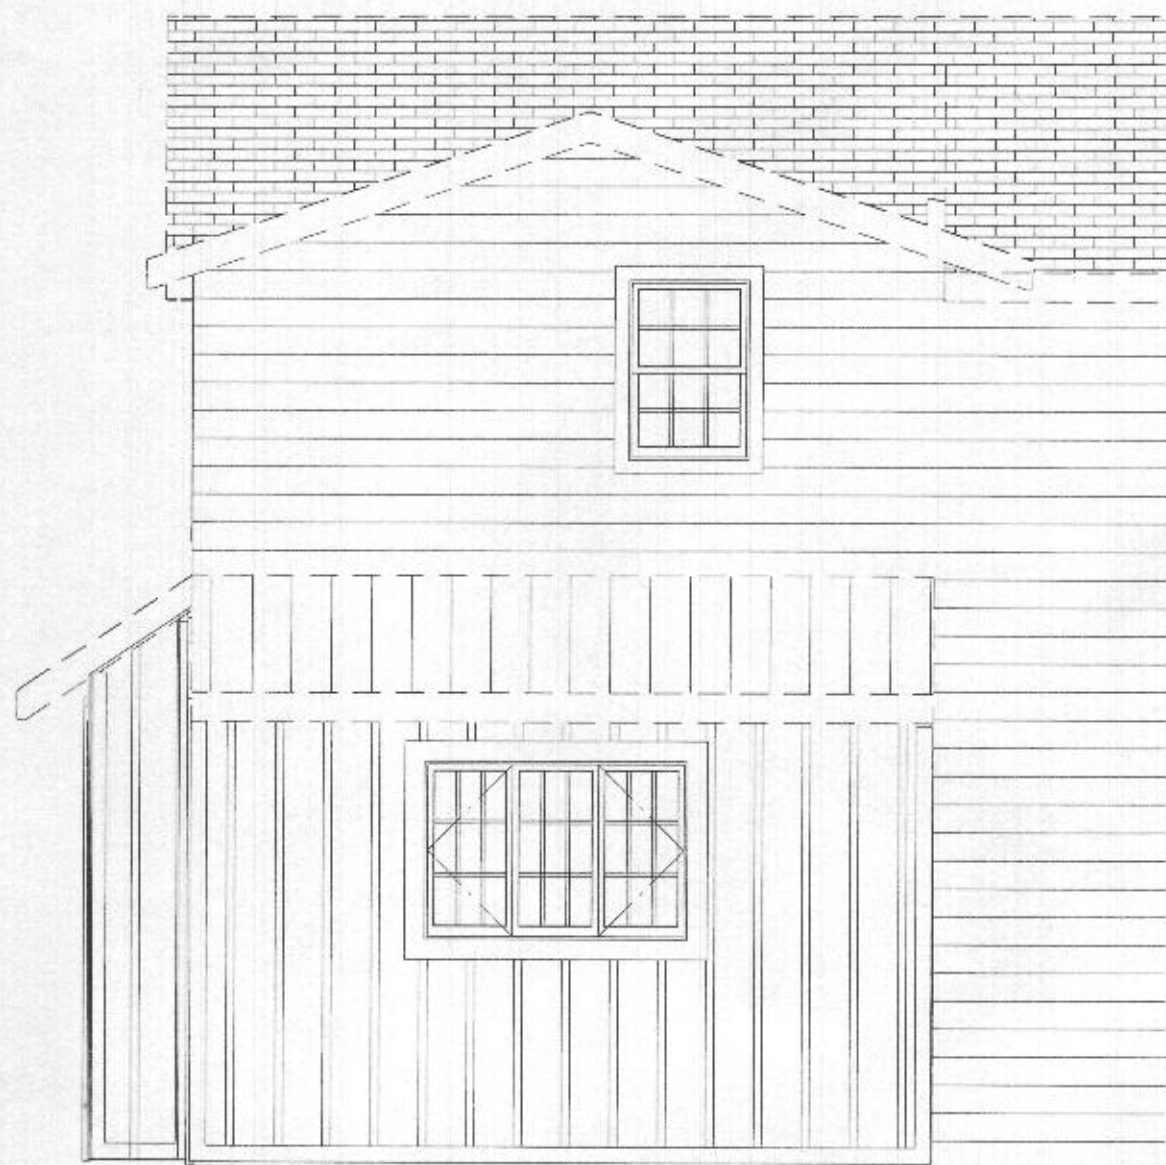

REAR ELEVATION



SIDE ELEVATION