

APPLICATION

A 21192

P _____

SEWAGE DISPOSAL TESTING

STATE OF MARYLAND - DEPARTMENT OF HEALTH AND MENTAL HYGIENE

HOWARD COUNTY HEALTH DEPARTMENT
ENVIRONMENTAL HEALTH SERVICES
P. O. BOX 476, ELLICOTT CITY, MARYLAND 21043
TELEPHONE: 465-3000, EXT. 358

DISTRICT 3

DATE 3/10/75

TO: THE COUNTY HEALTH OFFICER
ELLICOTT CITY, MARYLAND

I, HEREBY, APPLY FOR THE NECESSARY TEST IN ORDER TO CONSTRUCT (OR RECONSTRUCT) A SEWAGE DISPOSAL SYSTEM.

PROPERTY OWNER Ronald F. Sines, et ux

ADDRESS _____

Any questions call:
Mr. Beach, P. E. J.
465-1635

PHONE _____

PROPERTY LOCATION:

SUBDIVISION _____

LOT NO. 1

ROAD AND DESCRIPTION Thompson Drive (almost to end - joins Wooded Acres, Inc.)

SIZE OF LOT 0.96 acres

TYPE BLDG. 3 or 4

NUMBER OF BEDROOMS

IF NOT SINGLE RESIDENCE DESCRIBE _____

(Single Fmly. Dwlg.)

THE SYSTEM INSTALLED UNDER THIS APPLICATION IS ACCEPTABLE ONLY UNTIL PUBLIC FACILITIES BECOME AVAILABLE.

SIGNATURE OF APPLICANT /s/ Ronald F. Sines

APPROVED BY _____

FOR _____

(KIND OF SYSTEM)

DATE _____

REJECTED BY _____

FOR _____

(KIND OF SYSTEM)

DATE _____




HOLD PENDING FURTHER TESTS _____

DATE _____

REASONS FOR REJECTION OR HOLDING _____

THIS IS NOT A PERMIT

10

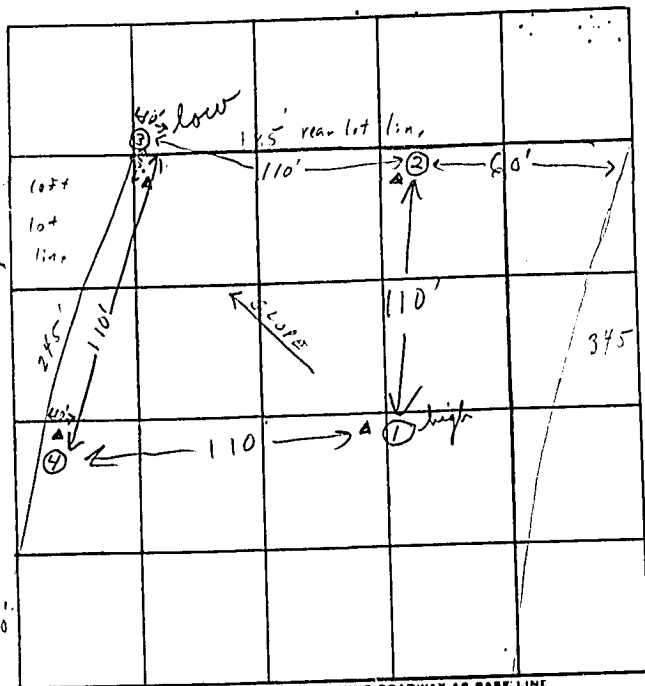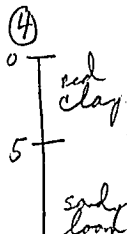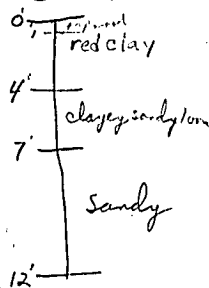

INDICATE NORTH. - NAME ADJOINING ROADWAY AS BASE LINE

80'
Thompson drive

DATE	TEST NO.	DEPTH	PRE-WET		TEST - 1" DROP		TIME
			START	STOP	START	STOP	
3-13-88	1 s high	4'	11:03	11:13	11:13	11:30	17 min
	1 d	12'	11:05	11:06	11:06	11:08	2 min
	2	11 1/2'	Vaseline 1 min. 11:08				11:09
	3 s low	4'	11:19	11:23	11:23	11:31	8 min
	3 d	11 1/2'	11:20	11:22	11:22	11:26	4 min
	(4 s)	4'	11:30	1/2" drop in 14 min. 11:30			
	4 d	11 1/2'	11:33	11:34	11:34	11:36	2 min
	4 c	5'	11:52	11:59	11:59	12:11	12 min

8 himary
inlet 4'

REMARKS

TYPE OF SOIL clay to 4' clay sand brown below

TESTED BY F. S. & H. O. N.

ALSO PRESENT:

Mr. Baith, Mr. Daniel